MAP FILE M56-61

COUNTY SURVEYORS FILE DATA
DO NOT REMOVE FROM OFFICE

Subdivision Of Section 32, T 30 S, R 8 W, W.M., Oregon

Roseburg Lumber Company

Scale: 1" = 300'

November 17, 1976

FILED
RECEIVED
NOV 19 1976
COUNTY SURVEYOR
DOUGLAS COUNTY, ORE.

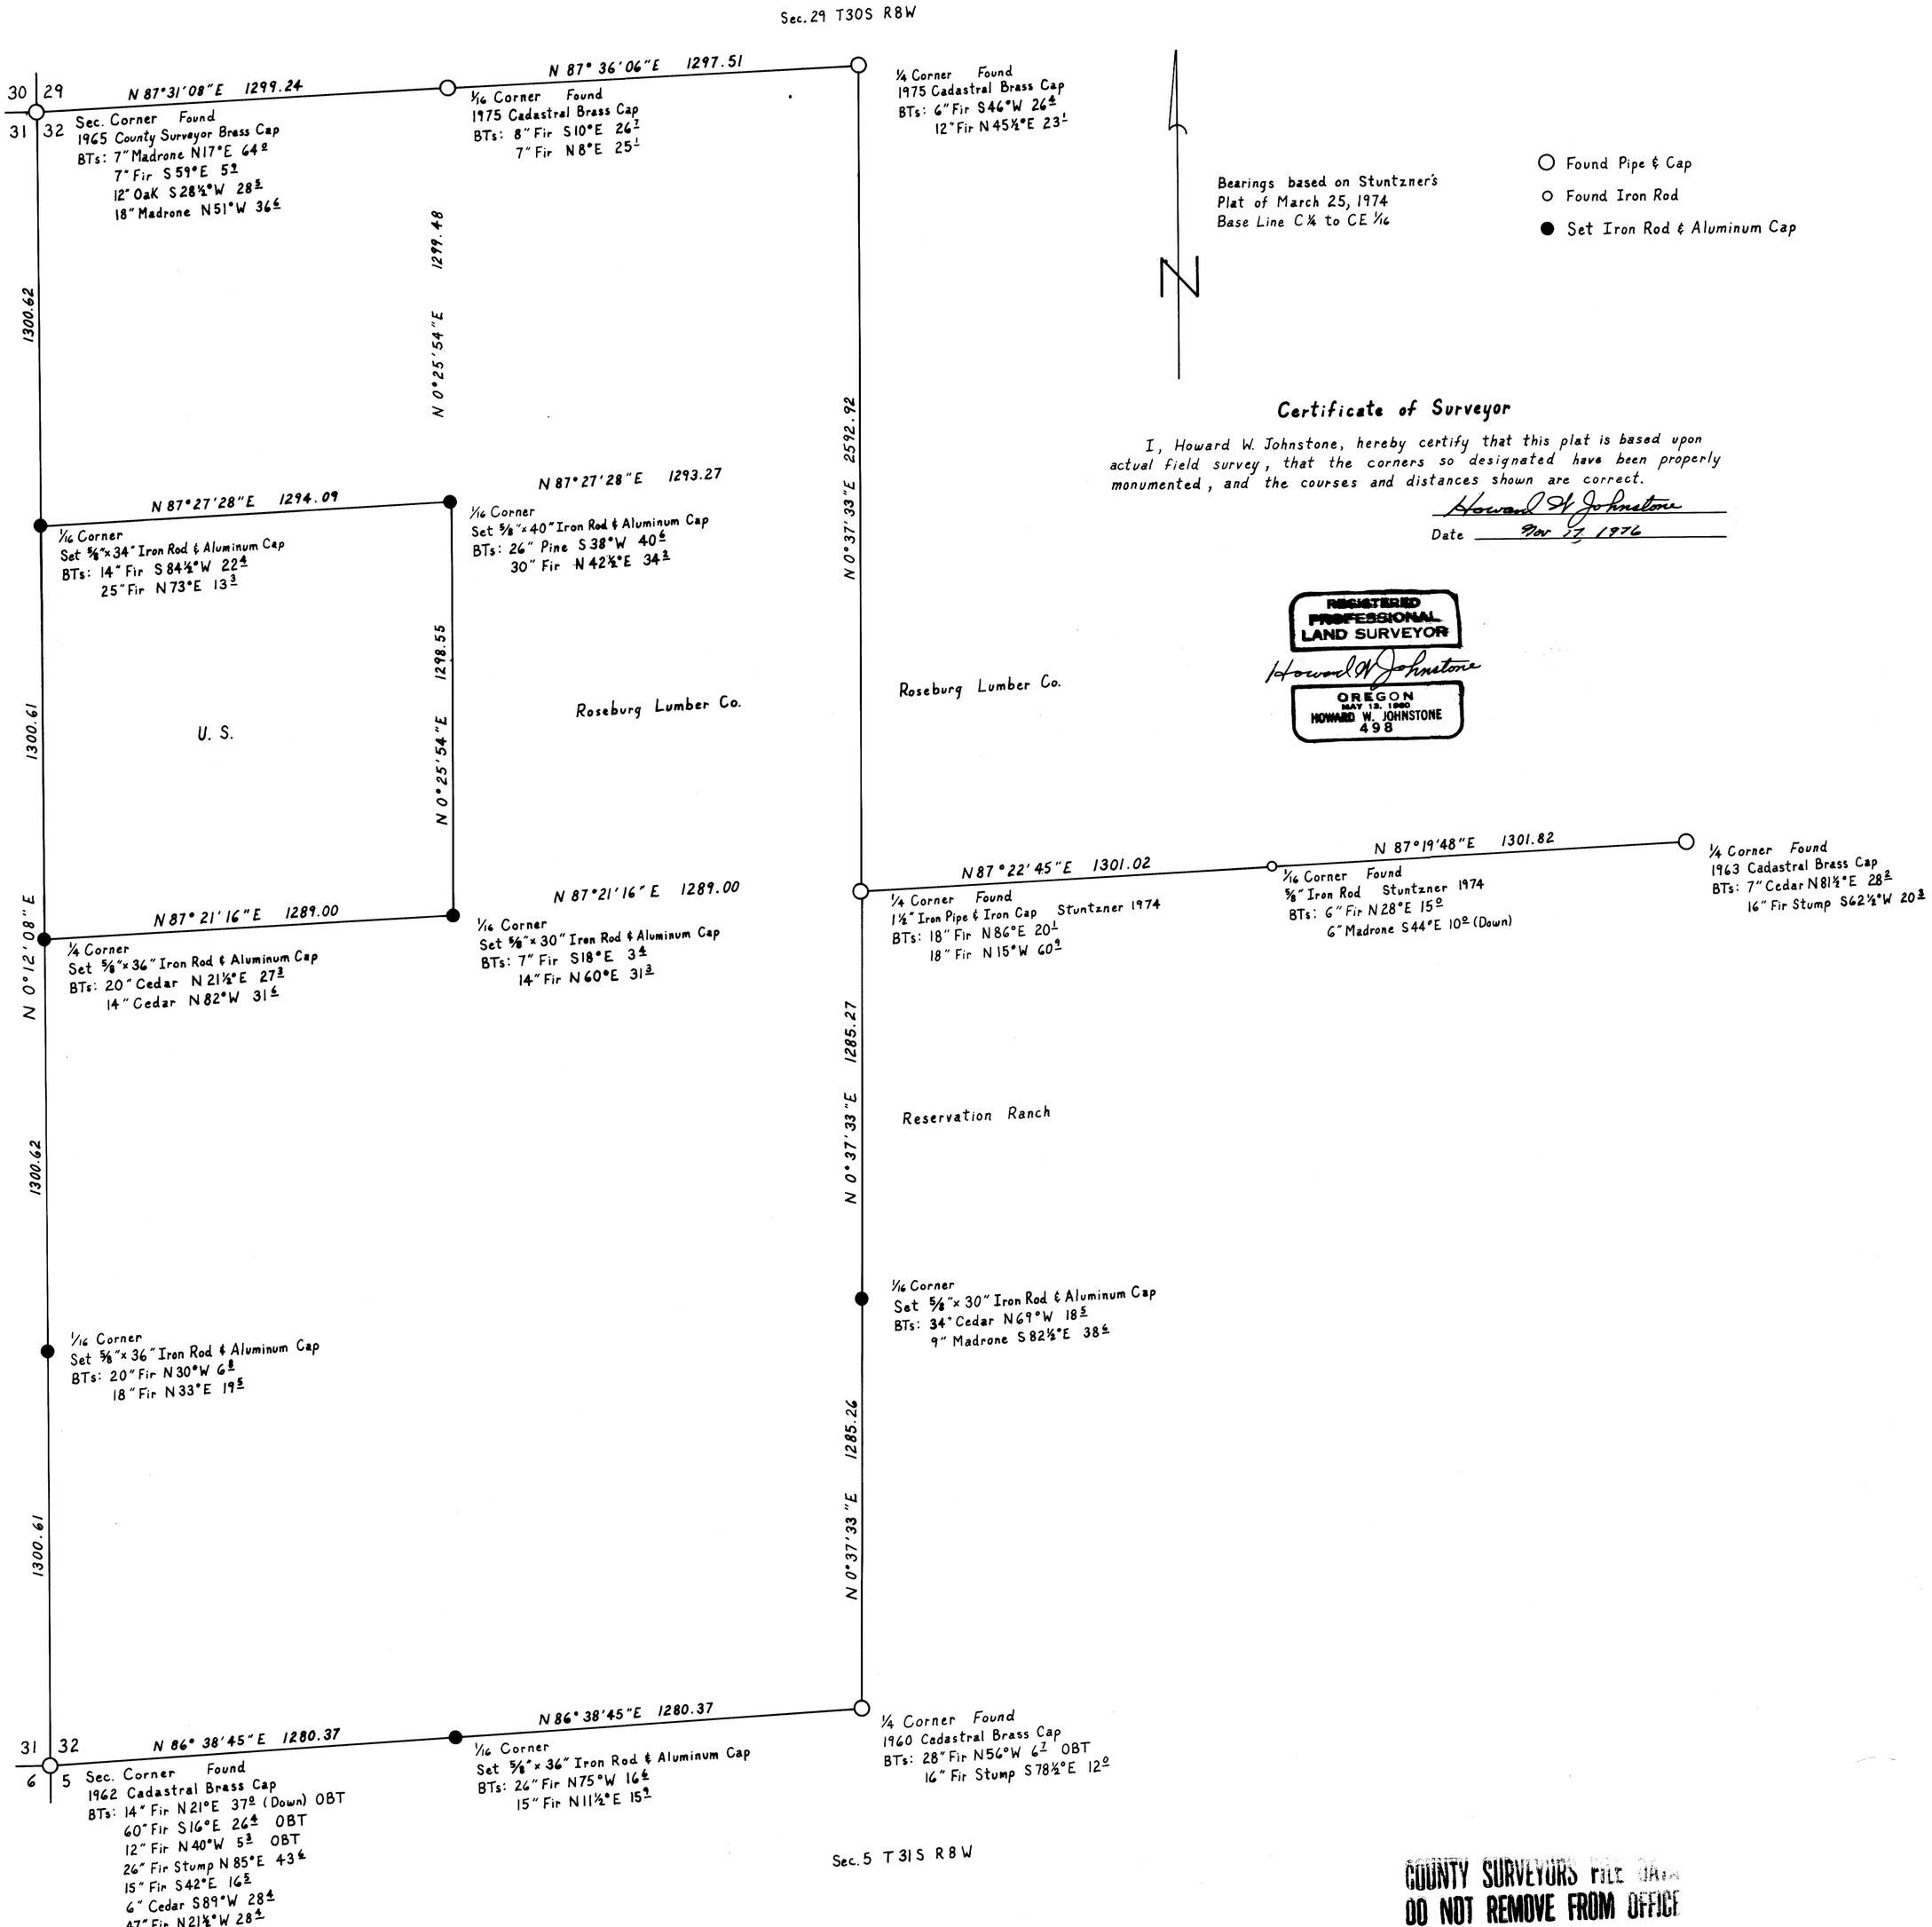

Certificate of Surveyor

I, Howard W. Johnstone, hereby certify that this plat is based upon actual field survey, that the corners so designated have been properly monumented, and the courses and distances shown are correct.

Howard W. Johnstone

Date Nov 17, 1976

REGISTERED PROFESSIONAL LAND SURVEYOR
Howard W. Johnstone
OREGON
MAY 13, 1960
HOWARD W. JOHNSTONE
498

COUNTY SURVEYORS FILE DATA
DO NOT REMOVE FROM OFFICE

MAP FILE M56-61