FILED
RECEIVED
MAY 30 1975
COUNTY SURVEYOR
DOUGLAS COUNTY, ORE.

MAP FILE 57 - 24

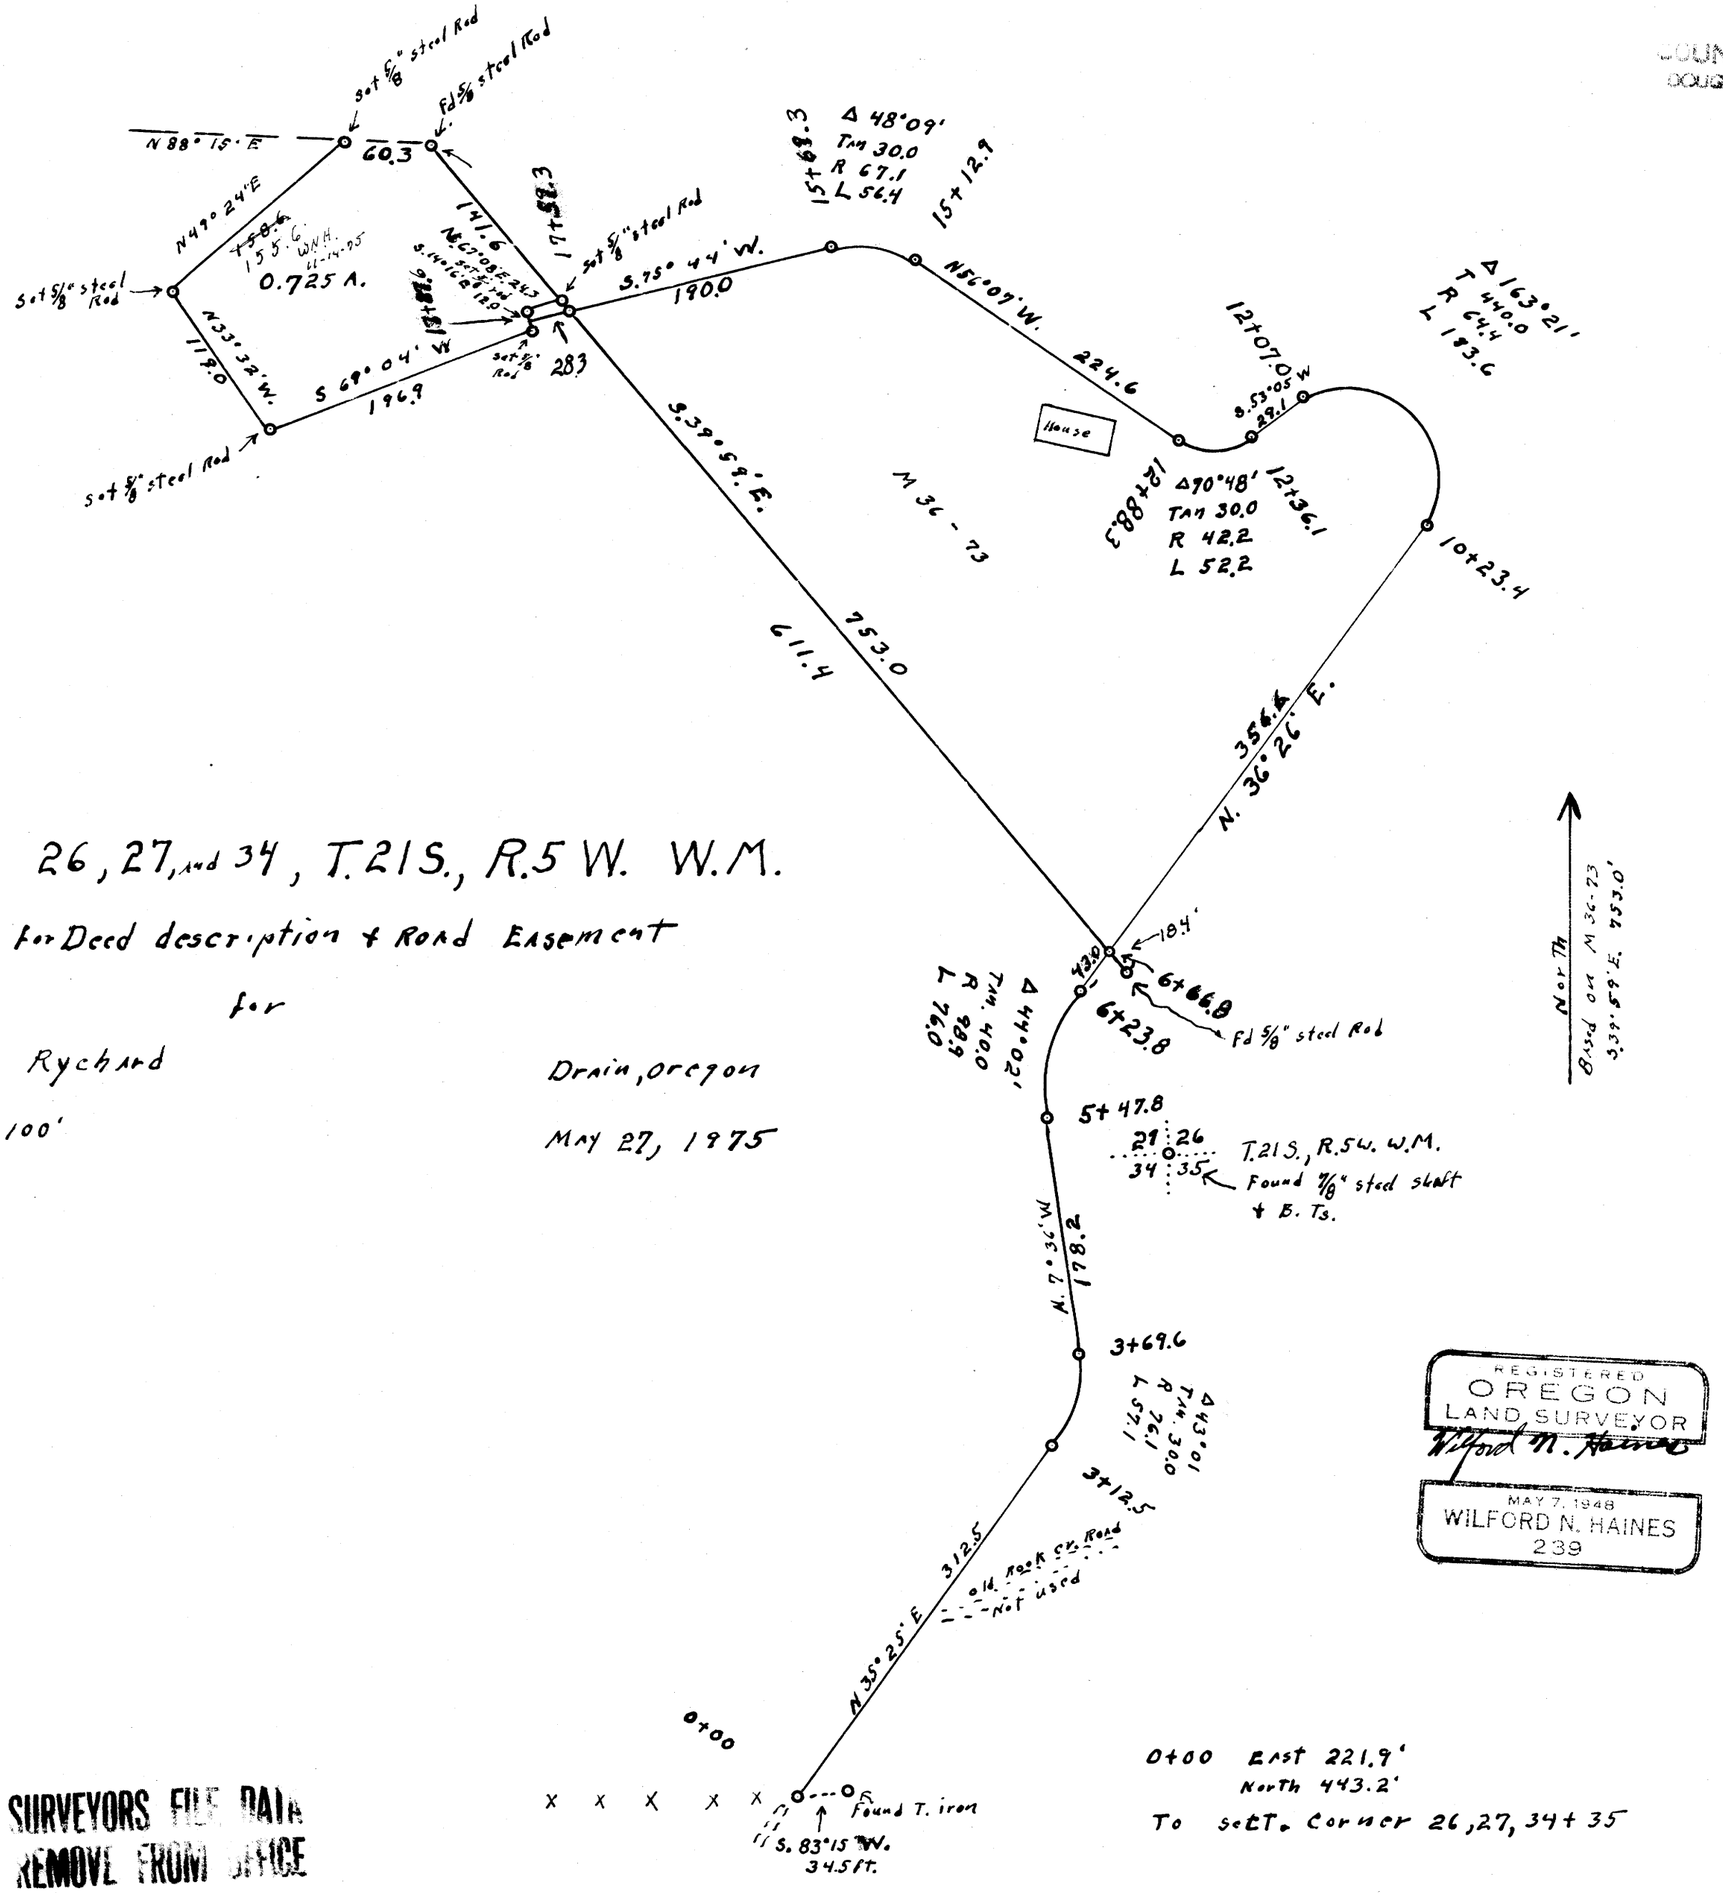

SECTS. 26, 27, and 34, T. 21S., R. 5 W. W.M.

Survey for Deed description & Road Easement

for

Quentin Rychard

Drain, Oregon

Scale 1" = 100'

May 27, 1975

REGISTERED
OREGON
LAND SURVEYOR
Wilford N. Haines
MAY 7, 1948
WILFORD N. HAINES
239

0+00 East 221.9'
North 443.2'
To sect. Corner 26, 27, 34 + 35

COUNTY SURVEYORS FILE DATA
DO NOT REMOVE FROM OFFICE

MAP FILE 57 - 24