MAP FILE M57 - 36

SURVEY TO SET PROPERTY CORNERS
IN SECTIONS 28 & 33, T.23S. R.5W.W.M.

FOR: DAN RUSSELL

BY: BAUGHMAN SURVEYING SERVICE

MAY 1975 SCALE: 1" = 200'

COUNTY SURVEYORS FILE DATA
DO NOT REMOVE FROM OFFICE

FILED
RECEIVED
JUN 9 1975
COUNTY SURVEYOR
DOUGLAS COUNTY, ORE.

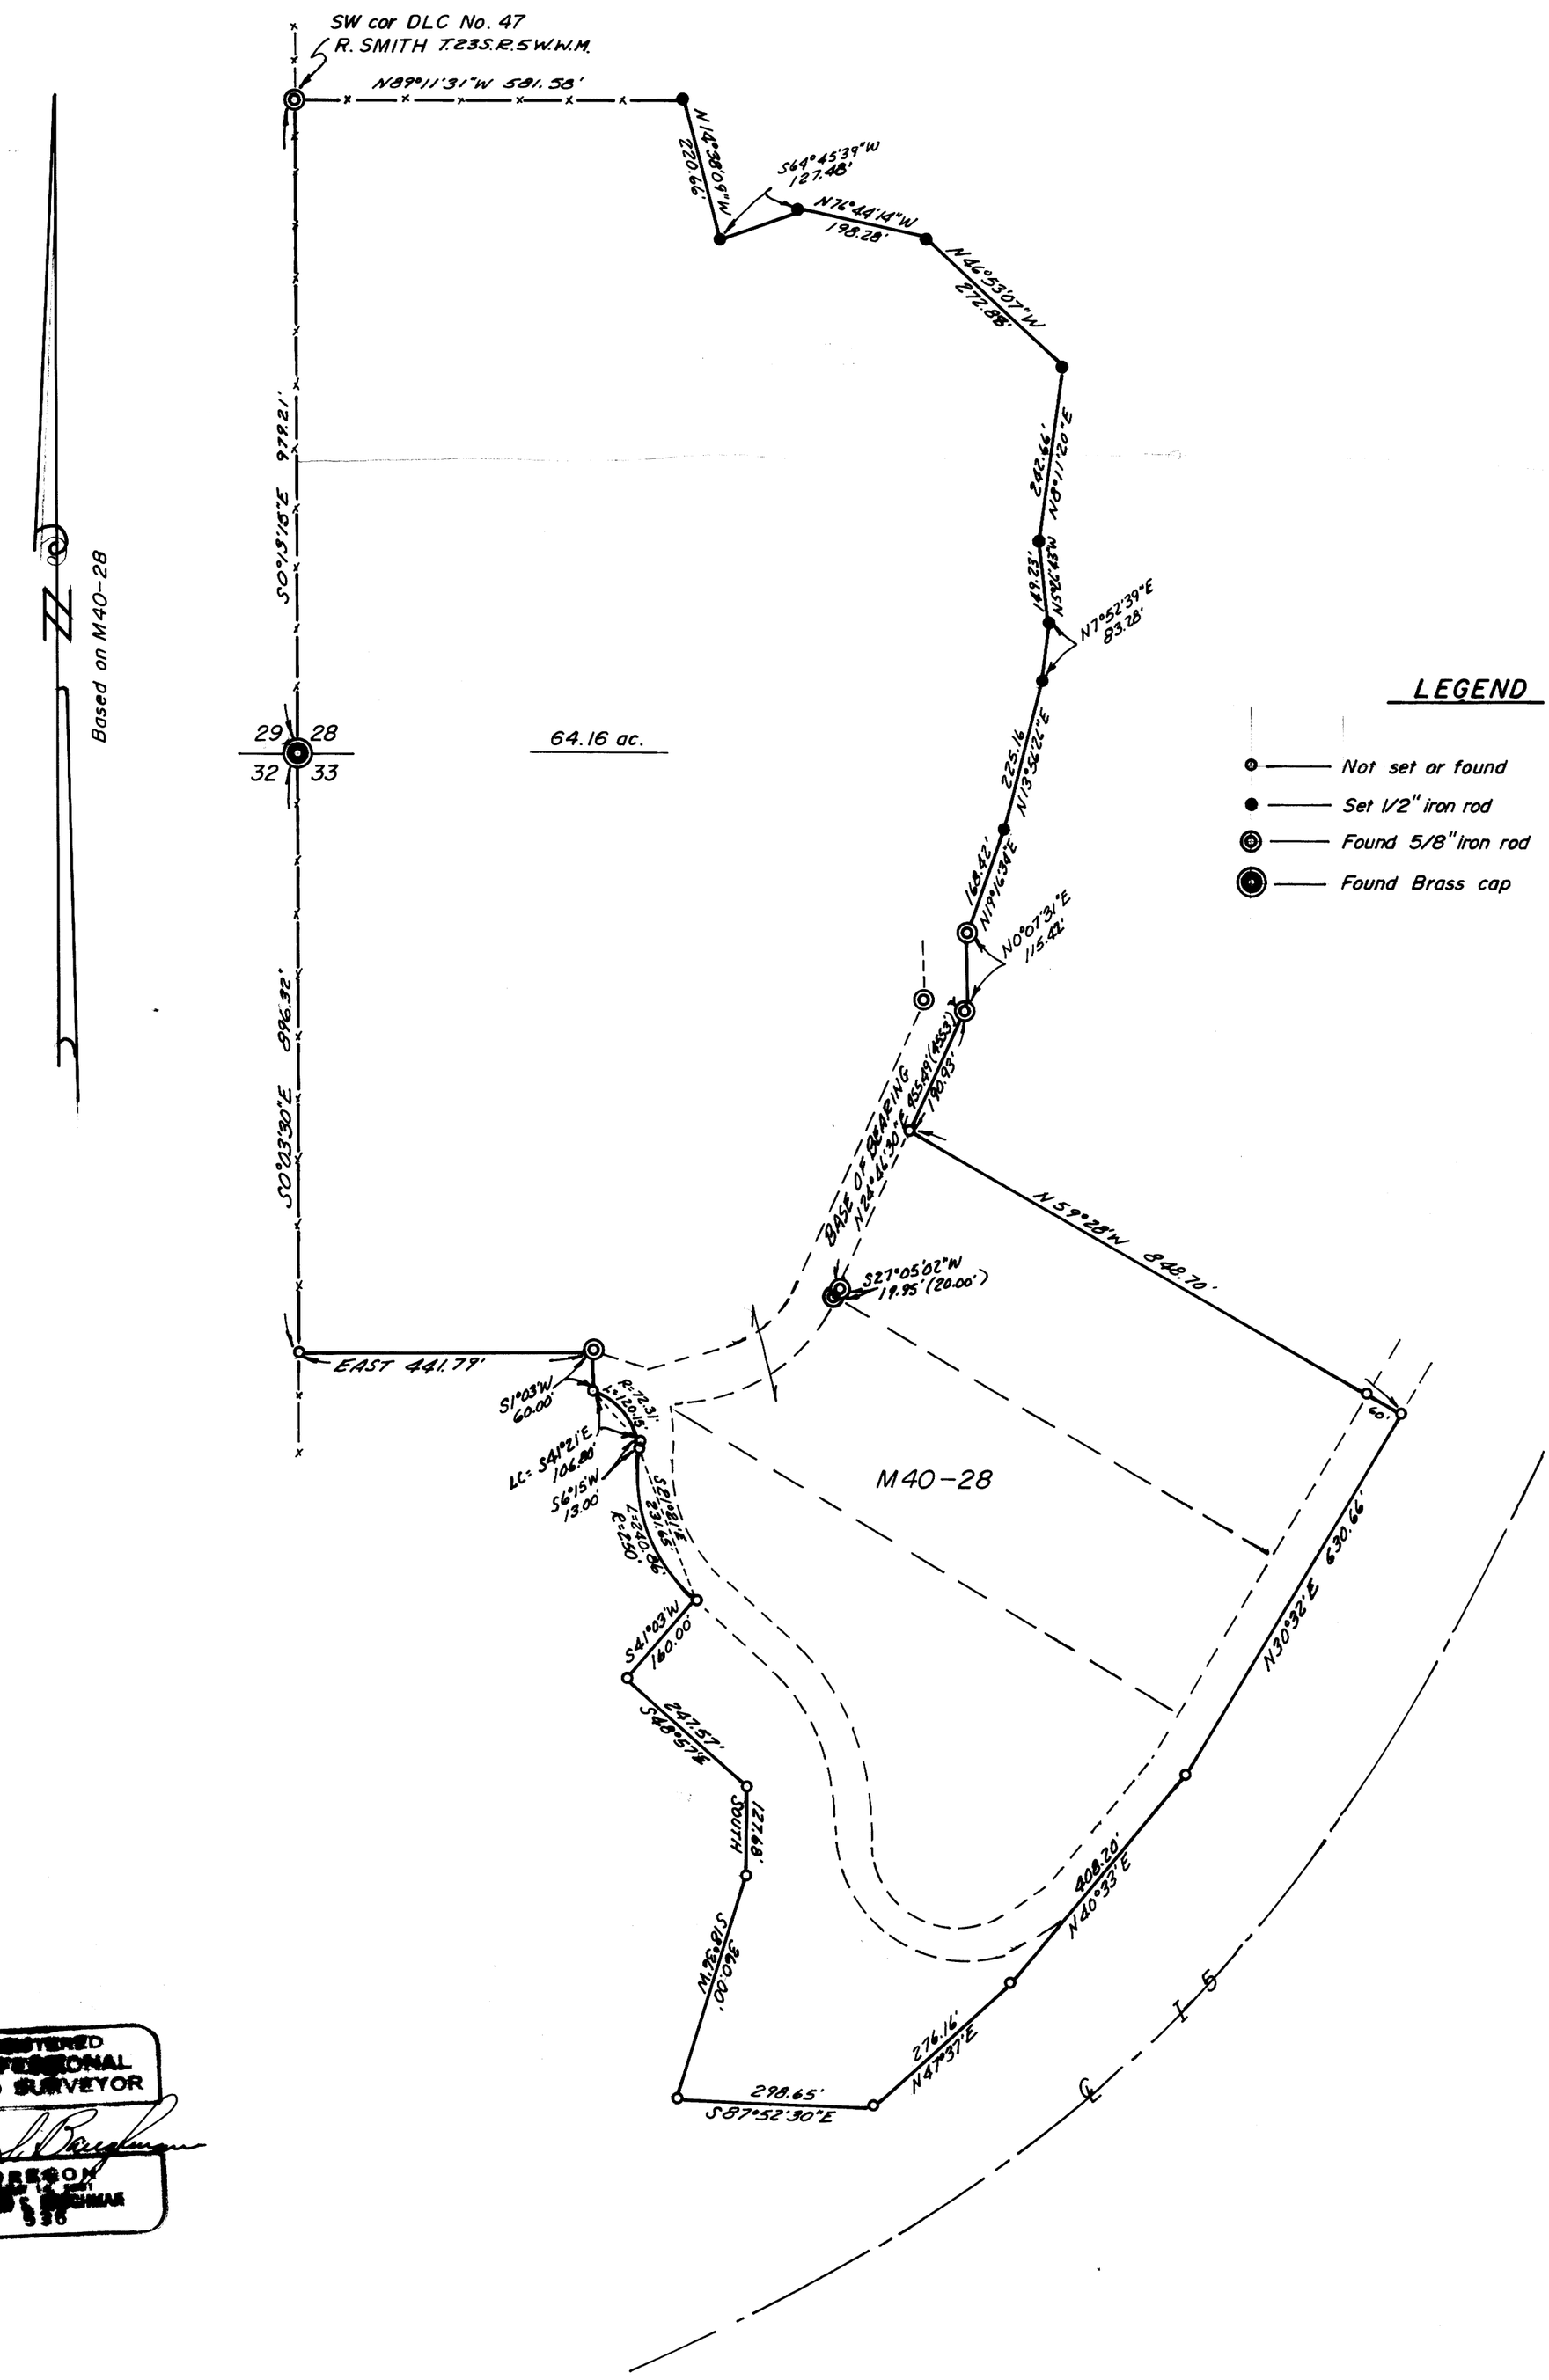

REGISTERED
PROFESSIONAL
LAND SURVEYOR
OREGON
536

MAP FILE M57 - 36