COUNTY SURVEYORS FILE DATA
DO NOT REMOVE FROM OFFICE

FILED
RECEIVED
JUN 19 1975
COUNTY SURVEYOR
DOUGLAS COUNTY, ORE.

SURVEY IN SEC. 1, T26S, R6W. W.M.

DOUGLAS COUNTY, ORE.

SURVEYED FOR- ROBT. SOULIA
SURVEYED BY- W. S. BARNES

JUNE 1975
SCALE 1" = 100'

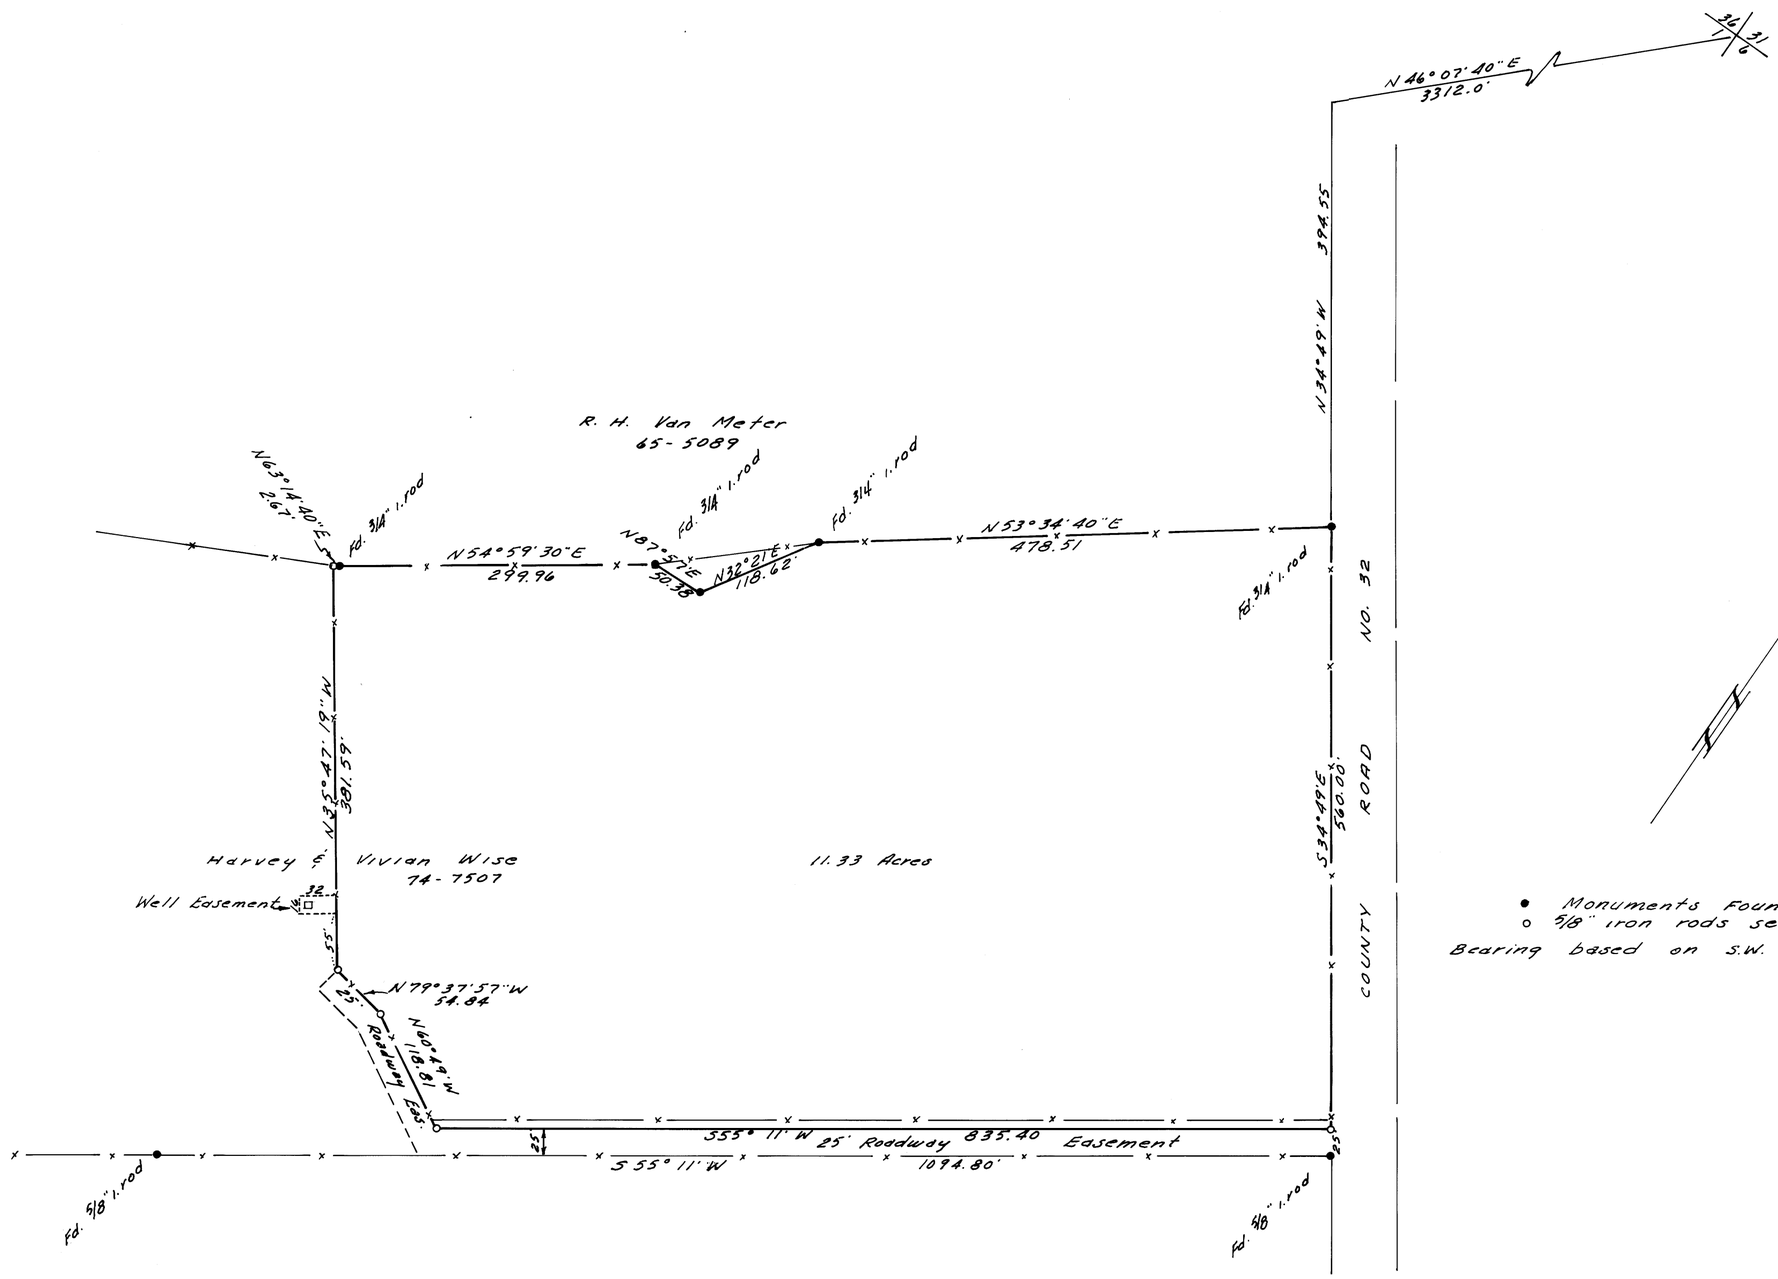

- • Monuments Found
- o 5/8" iron rods set.

Bearing based on S.W. R/W line of County Rd.

REGISTERED PROFESSIONAL ENGINEER
W. S. Barnes