COUNTY SURVEYORS FILE DATA
DO NOT REMOVE FROM OFFICE

MAP FILE M57-61

REESTABLISHMENT OF THE NORTHWEST CORNER THOMAS STEPHENS DONATION LAND CLAIM No. 40 SEC. 19, T27S, R5W, W.M.

(REFER TO COUNTY DRAWING No. M7-44)

FILED
RECEIVED
JUL 30 1975
COUNTY SURVEYOR
DOUGLAS COUNTY, ORE.

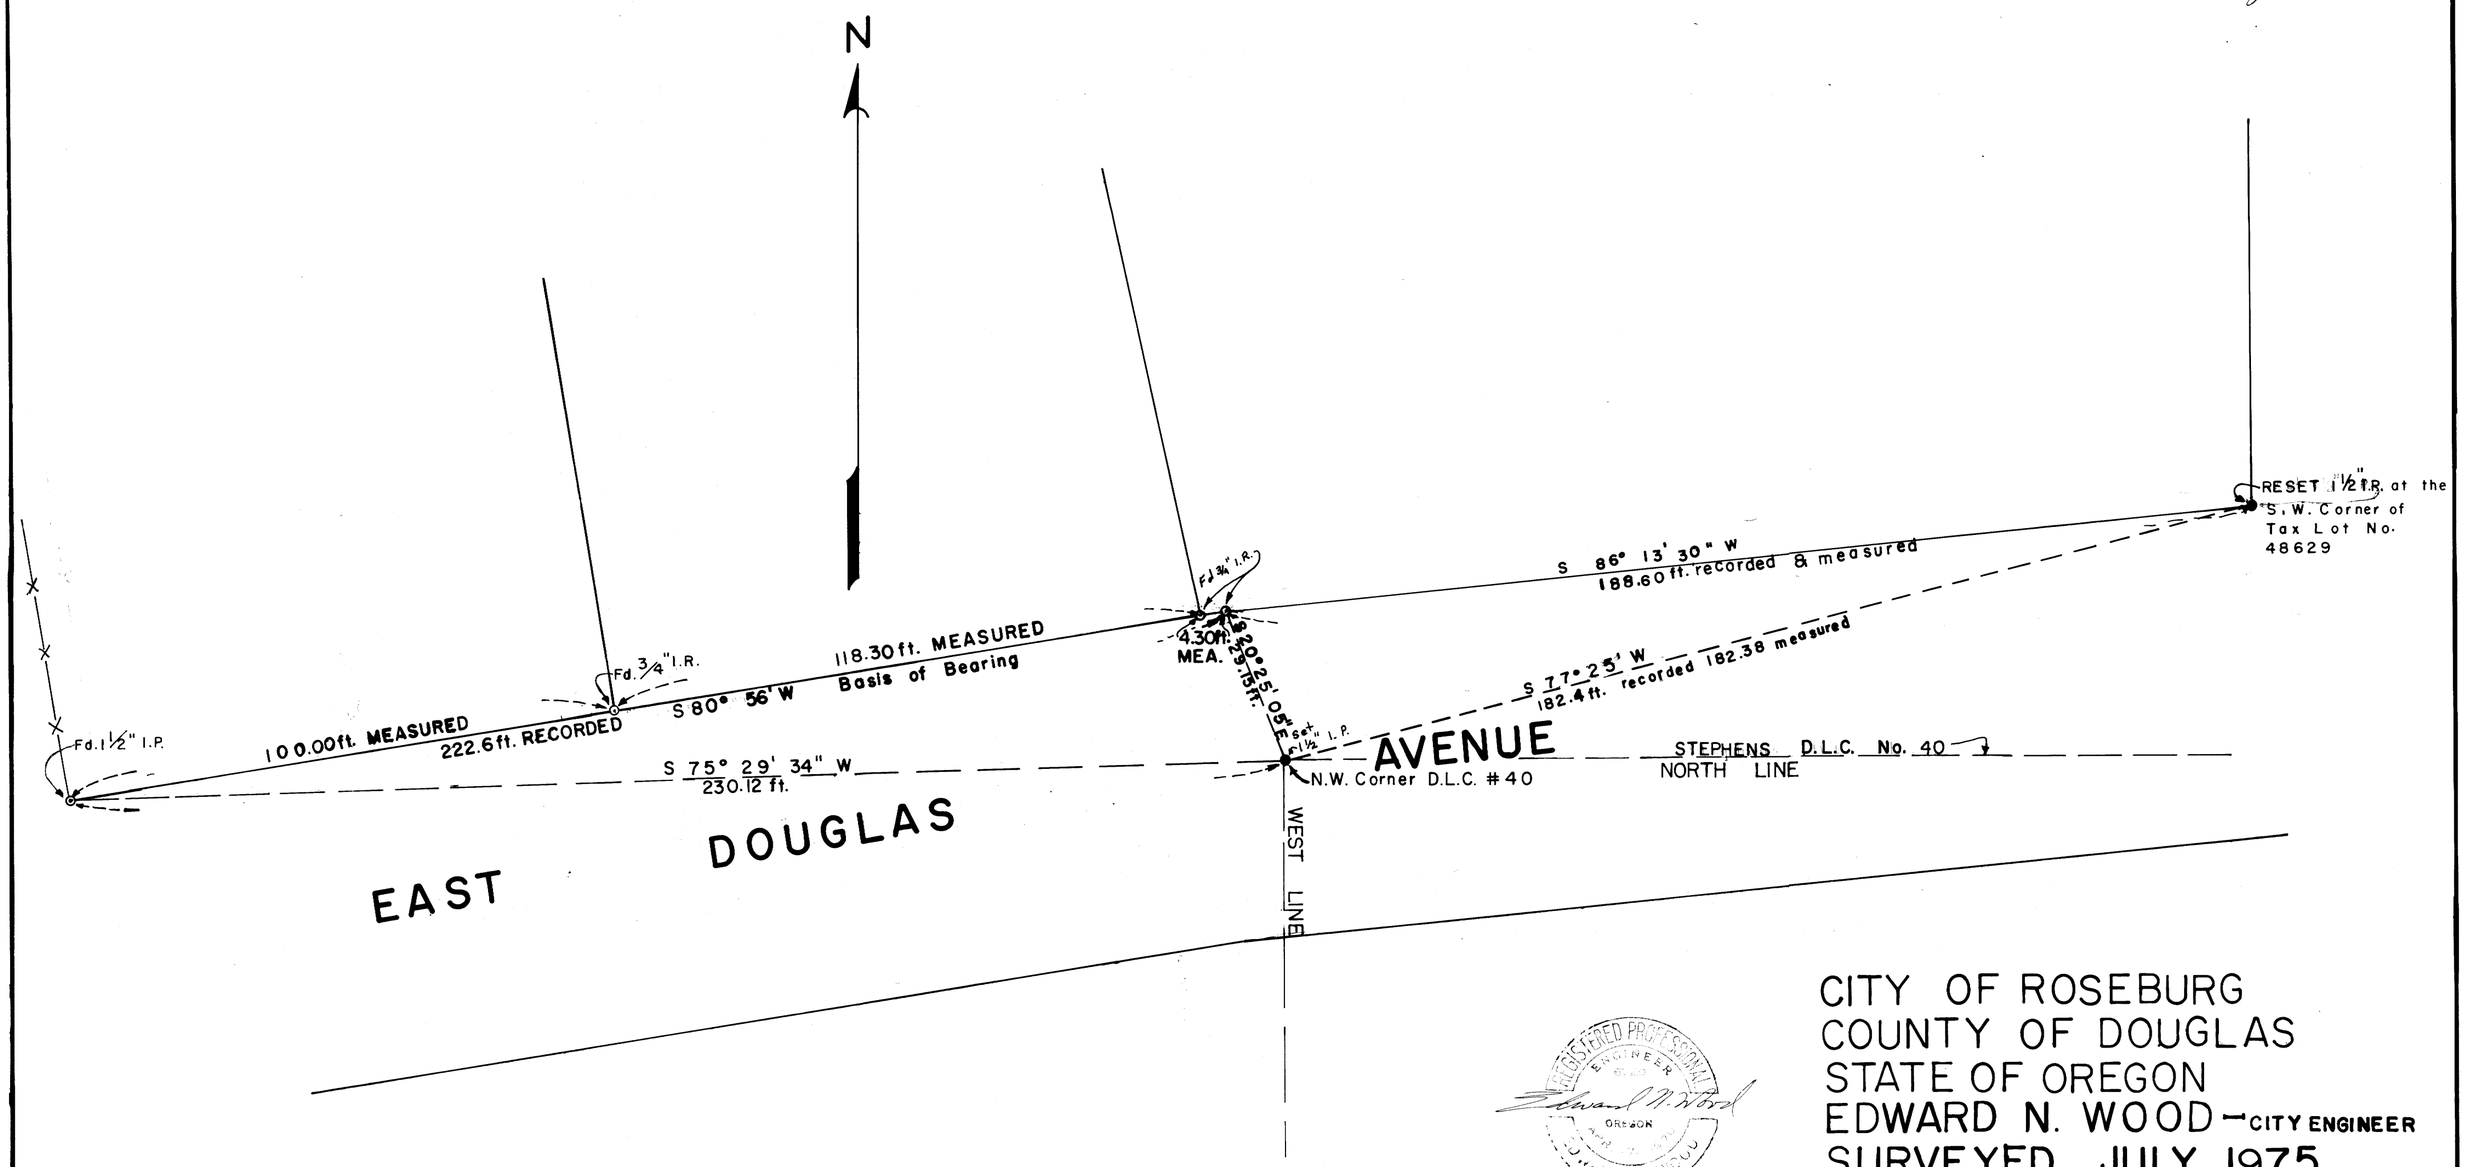

REGISTERED PROFESSIONAL ENGINEER
Edward N. Wood
OREGON

CITY OF ROSEBURG
COUNTY OF DOUGLAS
STATE OF OREGON
EDWARD N. WOOD — CITY ENGINEER
SURVEYED JULY 1975
Scale 1" = 20'

MAP FILE M57-61