SURVEY FOR DESCRIPTION

IN THE SW 1/4, SECTION 16, T.25S. R.5W.W.M.

FOR: GORDON ATTERBURY

BY: BAUGHMAN SURVEYING SERVICE

JULY 1975 SCALE: 1"=50'

COUNTY SURVEYORS FILE U...
DO NOT REMOVE FROM OFF...

FILED
RECEIVED
...011 1975
COUNTY SURVEYOR
DOUGLAS COUNTY, ORE.

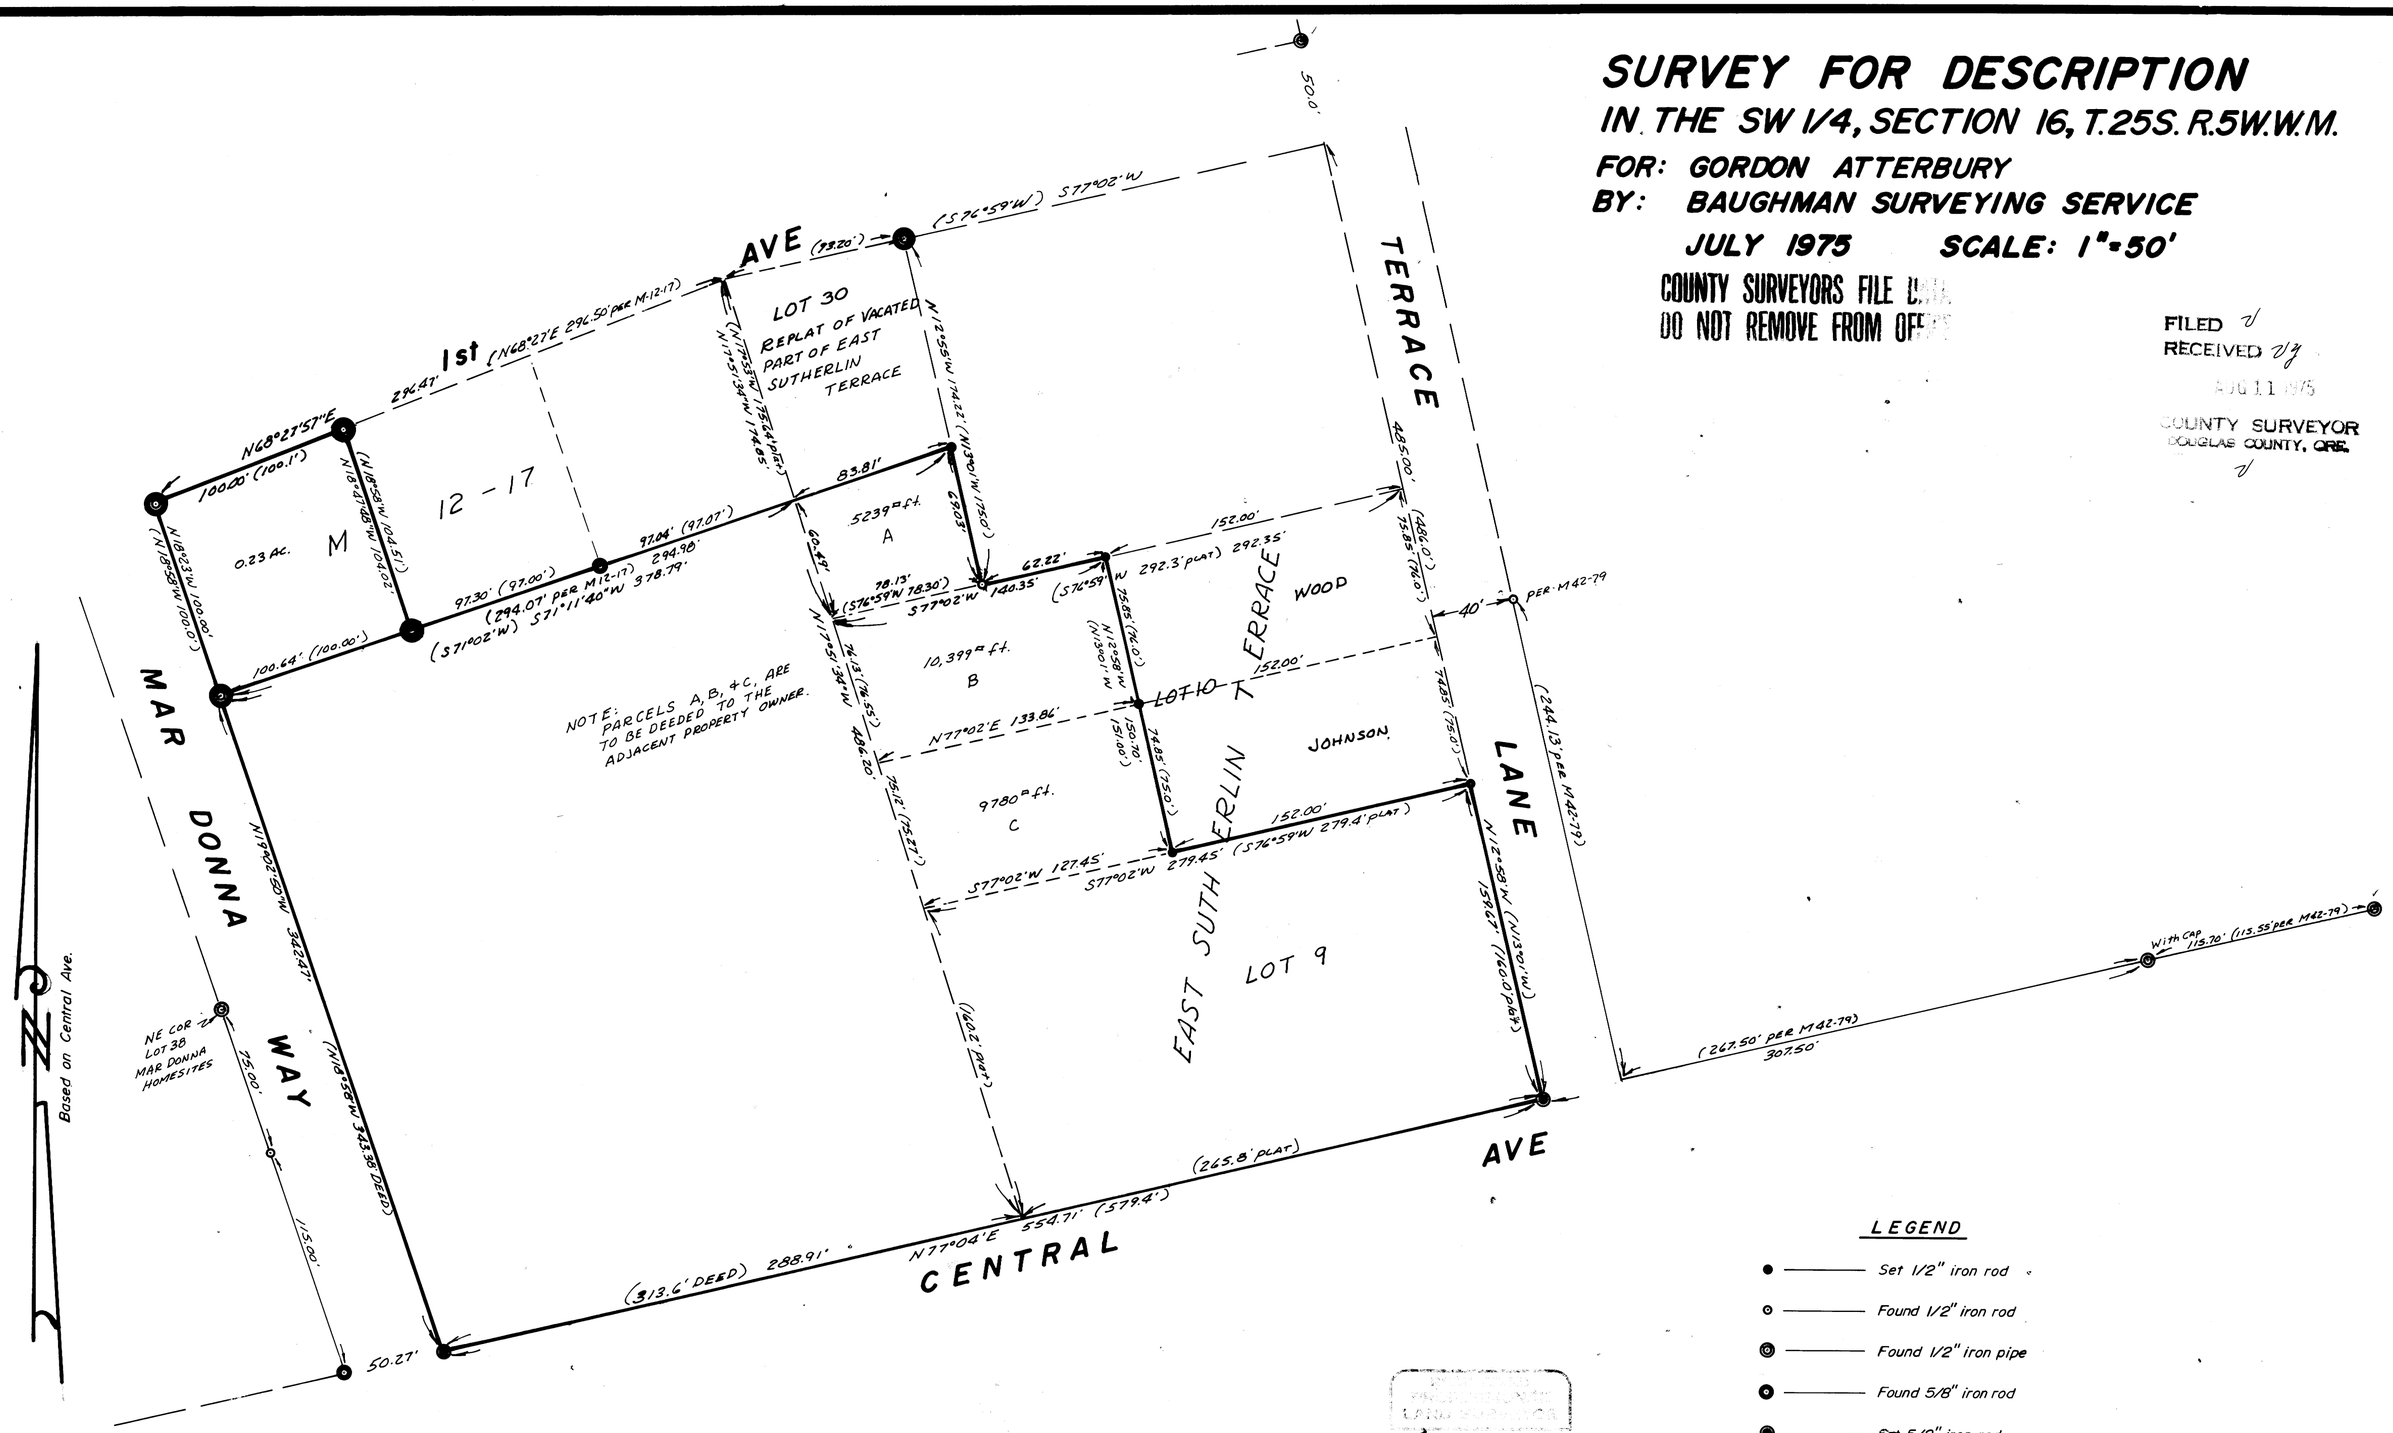

LEGEND

- Set 1/2" iron rod
- Found 1/2" iron rod
- Found 1/2" iron pipe
- Found 5/8" iron rod
- Set 5/8" iron rod
- Found 3/4" iron pipe
- Found 1-1/2" iron pipe

Job No. 35023

MAP FILE M.S.Z. - 67

MAP FILE M.S.Z. - 67