COUNTY SURVEYORS FILE DATA
DO NOT REMOVE FROM OFFICE

FILED
RECORDED by
COUNTY SURVEYOR
DOUGLAS COUNTY, OREG.

MAP FILE M58-24

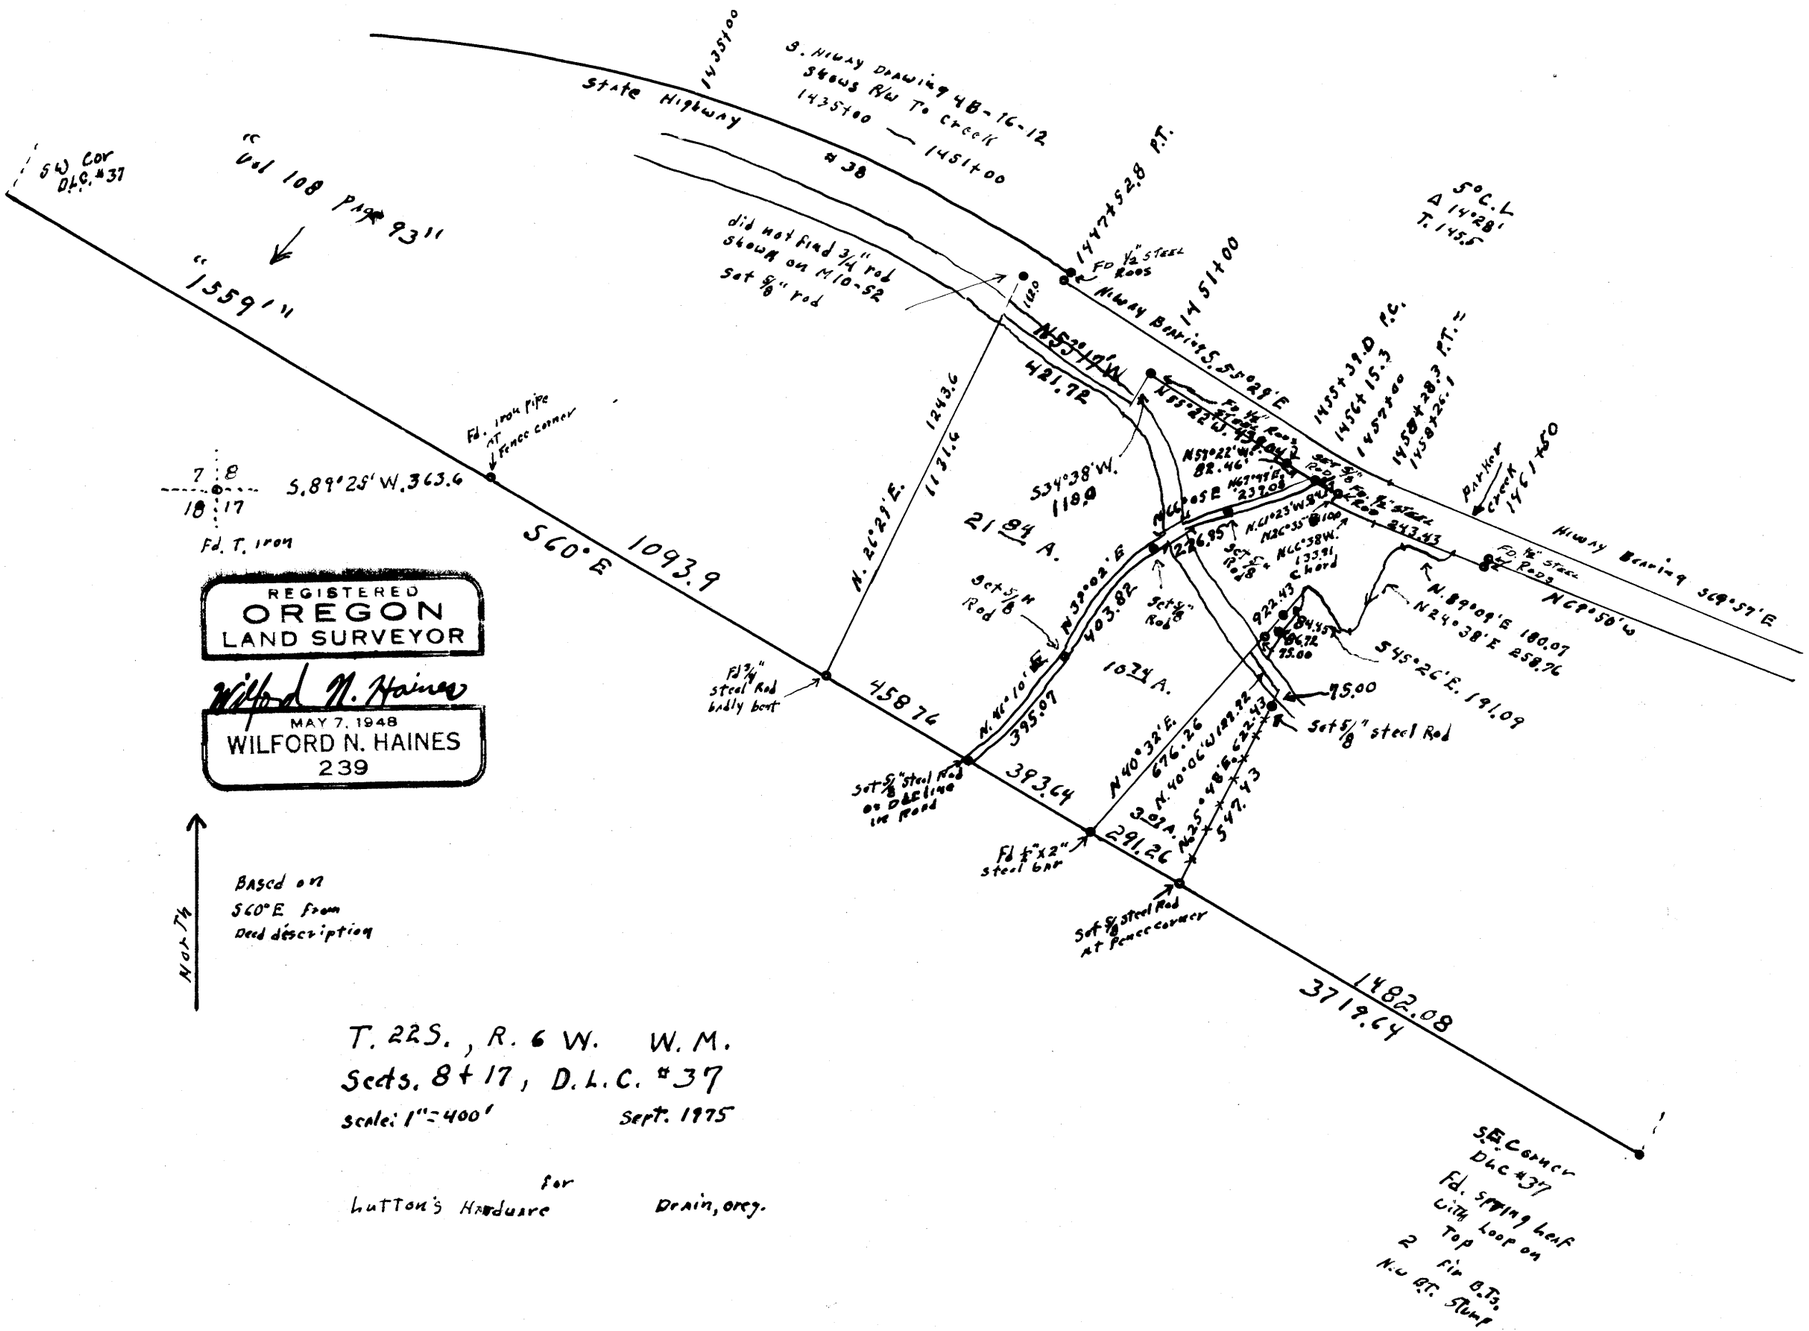
State Highway #38
1435+00
S. Hiway Drawing 4B-16-12 shows R/W To Creek 1435+00 — 1451+00
1447+528 P.T.
1451+00
Hiway Bearing S.55°28'E
50' C.L. Δ 14°28' T. 145.5
SW Cor D.L.C. #37
"Vol 108 Page 931"
"1559'"
did not find 3/4" rod shown on M10-52 set 5/8" rod
Fd. 1/2" steel Rods
Fd. iron pipe "X" fence corner
S.89°25' W. 363.6
7 8 18 17
Fd. T. iron
S60°E
1093.9
N. 26°29' E.
1243.6
1131.6
S34°38' W. 118.9
21 94 A.
421.72
N55°24' W
Set 5/8" Rod
N 39°02' E
403.82
N. 46°10' E
395.07
458.76
Fd 3/4" steel Rod badly bent
Set 5/8" steel Rod on D&E line in road
393.64
N 40°32' E.
676.26
10 74 A.
3.07 A.
N. 40°06' W 188.92
N 25°48' E 642.43
547.43
Fd 1"x2" steel bar
291.26
Set 5/8" steel Rod at fence corner
1482.08
3719.64
S.E. Corner D.L.C. #37 Fd. spring leaf with loop on top 2 Fir O.T.s. N.W. Qt. Stump
Parker Creek 1461+50
Hiway Bearing S69°57'E
N69°50'W
N. 89°09' E 180.07
N 24°38' E 258.76
S45°26' E. 191.09
Set 5/8" steel Rod
75.00
Set 5/8" Rod
Set 5/8" Rod
Set 5/8" Rod