COUNTY SURVEYOR
DO NOT REMOVE

FILED
OCT. 29
COUNTY
DOUGL COUNTY, ORE.

MAP FILE M58-38

BRASS CAP & WITNESS TREE MARKING.
(BRASS TAGS STAMPED "PLS 483" NAILED AT BASE OF "BT" BLAZE.)

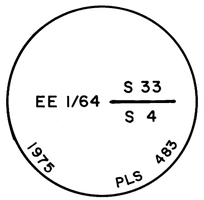

1

NOTE:
COR. FALLS AT BASE OF STEEP ASCENT EASTERLY.

14"SF S 70 1/4°W 73.4' MKD. "EE 1/64 S 4 BT"
21"SF N 42 3/4°W 53.3' MKD. "EE 1/64 S 33 BT"

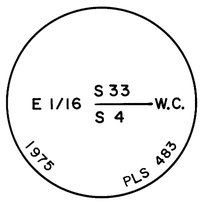

2

NOTE:
TRUE COR. BRS. N89°58'08"W 37.155' TO TOP EDGE OF SLIDE AREA INTO S. UMPQUA RIVER.

41.5"SP N 35 1/2°E 61.4' MKD. "E 1/16 WC S 33 BT"
17"SP S 42 1/4°E 28.6' MKD. "E 1/16 WC S 4 BT"

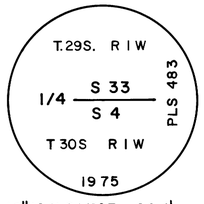

3

NOTE:
ORIGINAL COR. NOT FOUND. PROPORTIONATE COR. FALLS IN CTR. OF PAVED ROAD & IS SET 6" BELOW SURFACE.

18"IC N 6 1/2°E 64.4' MKD. "1/4 S 33 BT"
11.2"PP S 2 1/4°W 32.9' MKD. "1/4 S 4 BT"

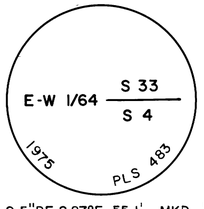

4

9.5"DF S 27°E 55.1' MKD. "EW 1/64 S 4 BT"
16.5"SP N 4 3/4°E 32.5' MKD. EW 1/64 S 33 BT"

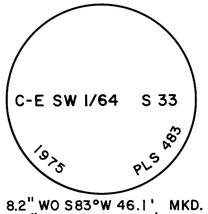

5

NOTE:
COR. FALLS 175' ± N OF GRAVEL ROAD.

8.2" WO S 83°W 46.1' MKD. "CE SW 1/64 S 33 BT"
10.8"DF S 5 3/4°E 28.5' MKD.

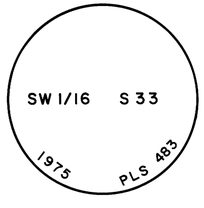

6

13"SP N 6 1/2°E 14.3' MKD. "SW 1/16 S 33 BT"
13.2"IC S 83/4°E 16.7' MKD.

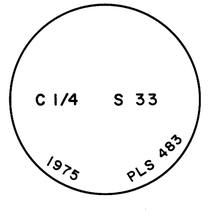

7

8"DF N 2 1/2°E 21.9' MKD. "C 1/4 S 33 BT"
9.3'DF S 48 1/4°E 44.7' MKD.

DEPENDENT RESURVEY AND SUBDIVISION OF A PORTION OF SECTION 33, T. 29 S., R. 1 W., W.M., DOUGLAS COUNTY, OREGON

FOR

U. S. FOREST SERVICE

UNDER
PROVISIONS OF CONTRACT NO. 004937N
(TILLER LAND SURVEY NO. 17) DTD. 9-2-75.
&
COMPLIANCE WITH PARAGRAPH 209-250,
OREGON REVISED STATUTES

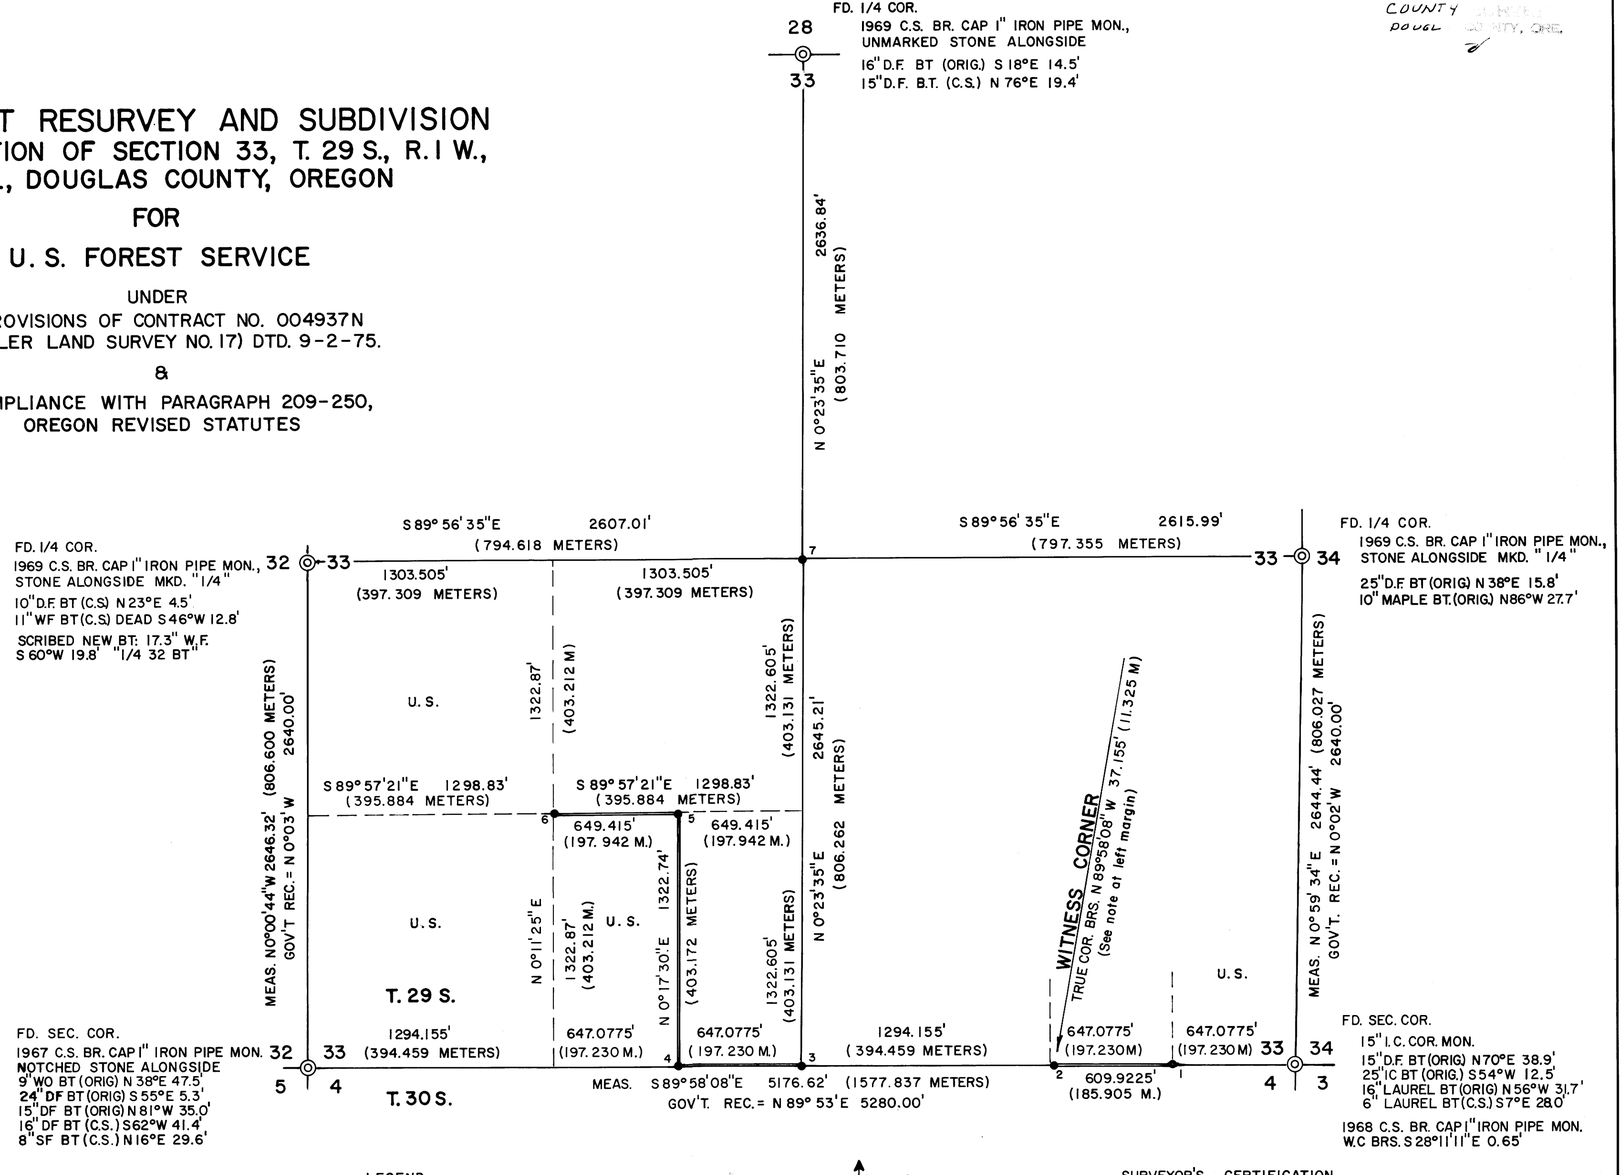

LEGEND

◎ FOUND RE-ESTAB. GOV'T. CORS.

● SET 2"x30" IRON PIPE MONS. WITH 3" BR. CAP RIVETED AT TOP AND 12" FLANGE WELDED TO BASE. SEE LIST OF MONS. AT LEFT.

═══ LINES BRUSHED & POSTED WITH 6' STEEL FENCE POSTS AT 5 CHAIN (OR LESS) INTERVALS.

MERIDIAN EST. BY MEAN OF 3 SEPARATE SOLAR OBS. OF 6 POINTINGS EACH.
TAKEN ON
9-12-75
9-25-75
9-26-75

APPROX. MEAN DECLINATION, 1975

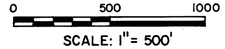

SCALE: 1" = 500'

SURVEYOR'S CERTIFICATION

I, CHARLES H. HURST, A REGISTERED PROFESSIONAL LAND SURVEYOR IN THE STATE OF OREGON, HEREBY CERTIFY THAT THIS PLAT AND THE NOTES HEREON OR ATTACHED, ARE A CORRECT REPRESENTATION OF A SURVEY EXECUTED DURING SEPTEMBER, 1975 FOR THE U.S. FOREST SERVICE, IN ACCORDANCE WITH THE STATUTES OF THE STATE OF OREGON AND WITH THE ARTICLES OF MY CONTRACT.

Charles H. Hurst
SURVEYOR

OCT 20 1975

REGISTERED
PROFESSIONAL
LAND SURVEYOR
Charles H. Hurst
OREGON
OCTOBER 30, 1959
CHARLES H. HURST
483

M58-38