MAP FILE M58-53

FILED Mg
RECORDED Dls
COUNTY, ORE.

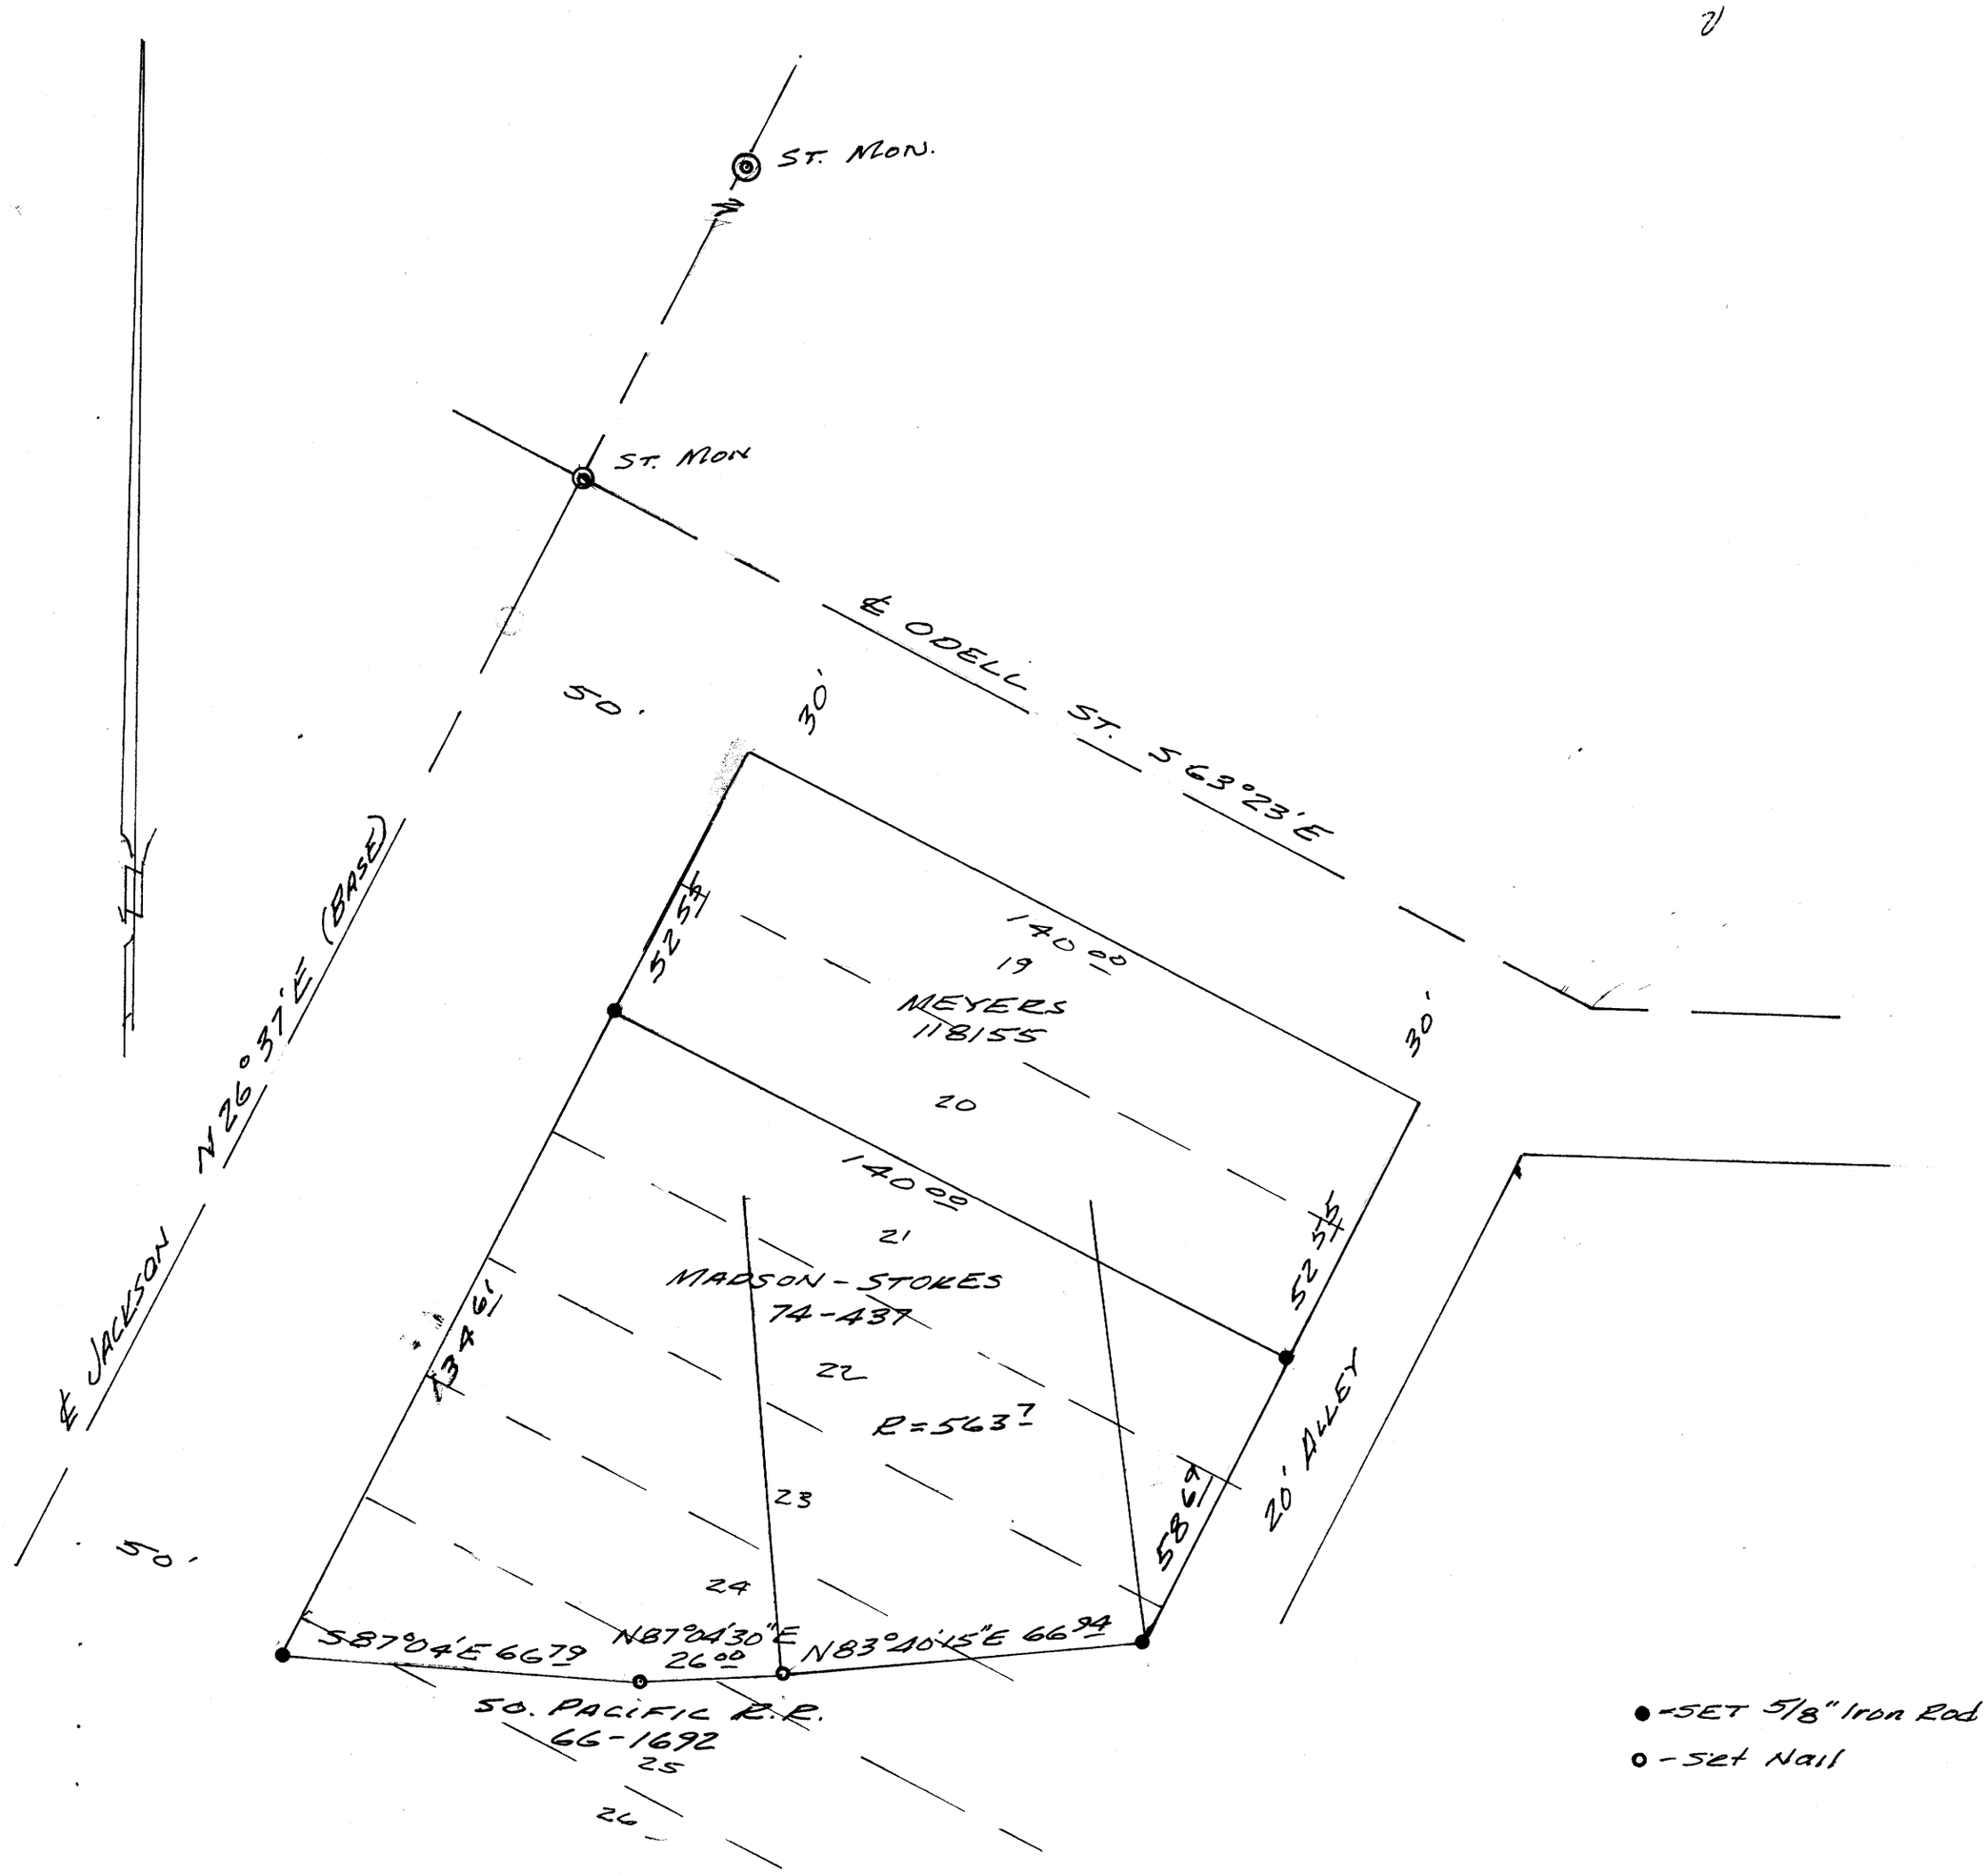

● -SET 5/8" Iron Rod
o - Set Nail

SURVEY TO SET PROPERTY CORNERS
IN LOTS 21, 22, 23, 24, 25 & 26; BLOCK 7
KINNEYS IMPROVED PLAT
SEC. 19, T27S., R.5W.W.M.
FOR MADSON-STOKES
by BRUCE ROGERS
NOV., 1975
1" = 30'

REGISTERED
OREGON
LAND SURVEYOR
Bruce R. Rogers
JULY 30, 1968
BRUCE R. ROGERS
660

COUNTY SURVEYORS FILE DATA
DO NOT REMOVE FROM OFFICE

MAP FILE M58-53