SURVEY TO SET PROPERTY CORNERS

COUNTY SURVEYORS FILE DATA
DO NOT REMOVE FROM OFFICE

FILED
RECEIVED mg
DEC 18 1975
COUNTY SURVEYOR
DOUGLAS COUNTY, ORE.

IN SECTION 32, T.27S. R.6W.W.M.

FOR: STANFORD BUELL

BY: BAUGHMAN SURVEYING SERVICE

NOVEMBER 1975 SCALE: 1"=100'

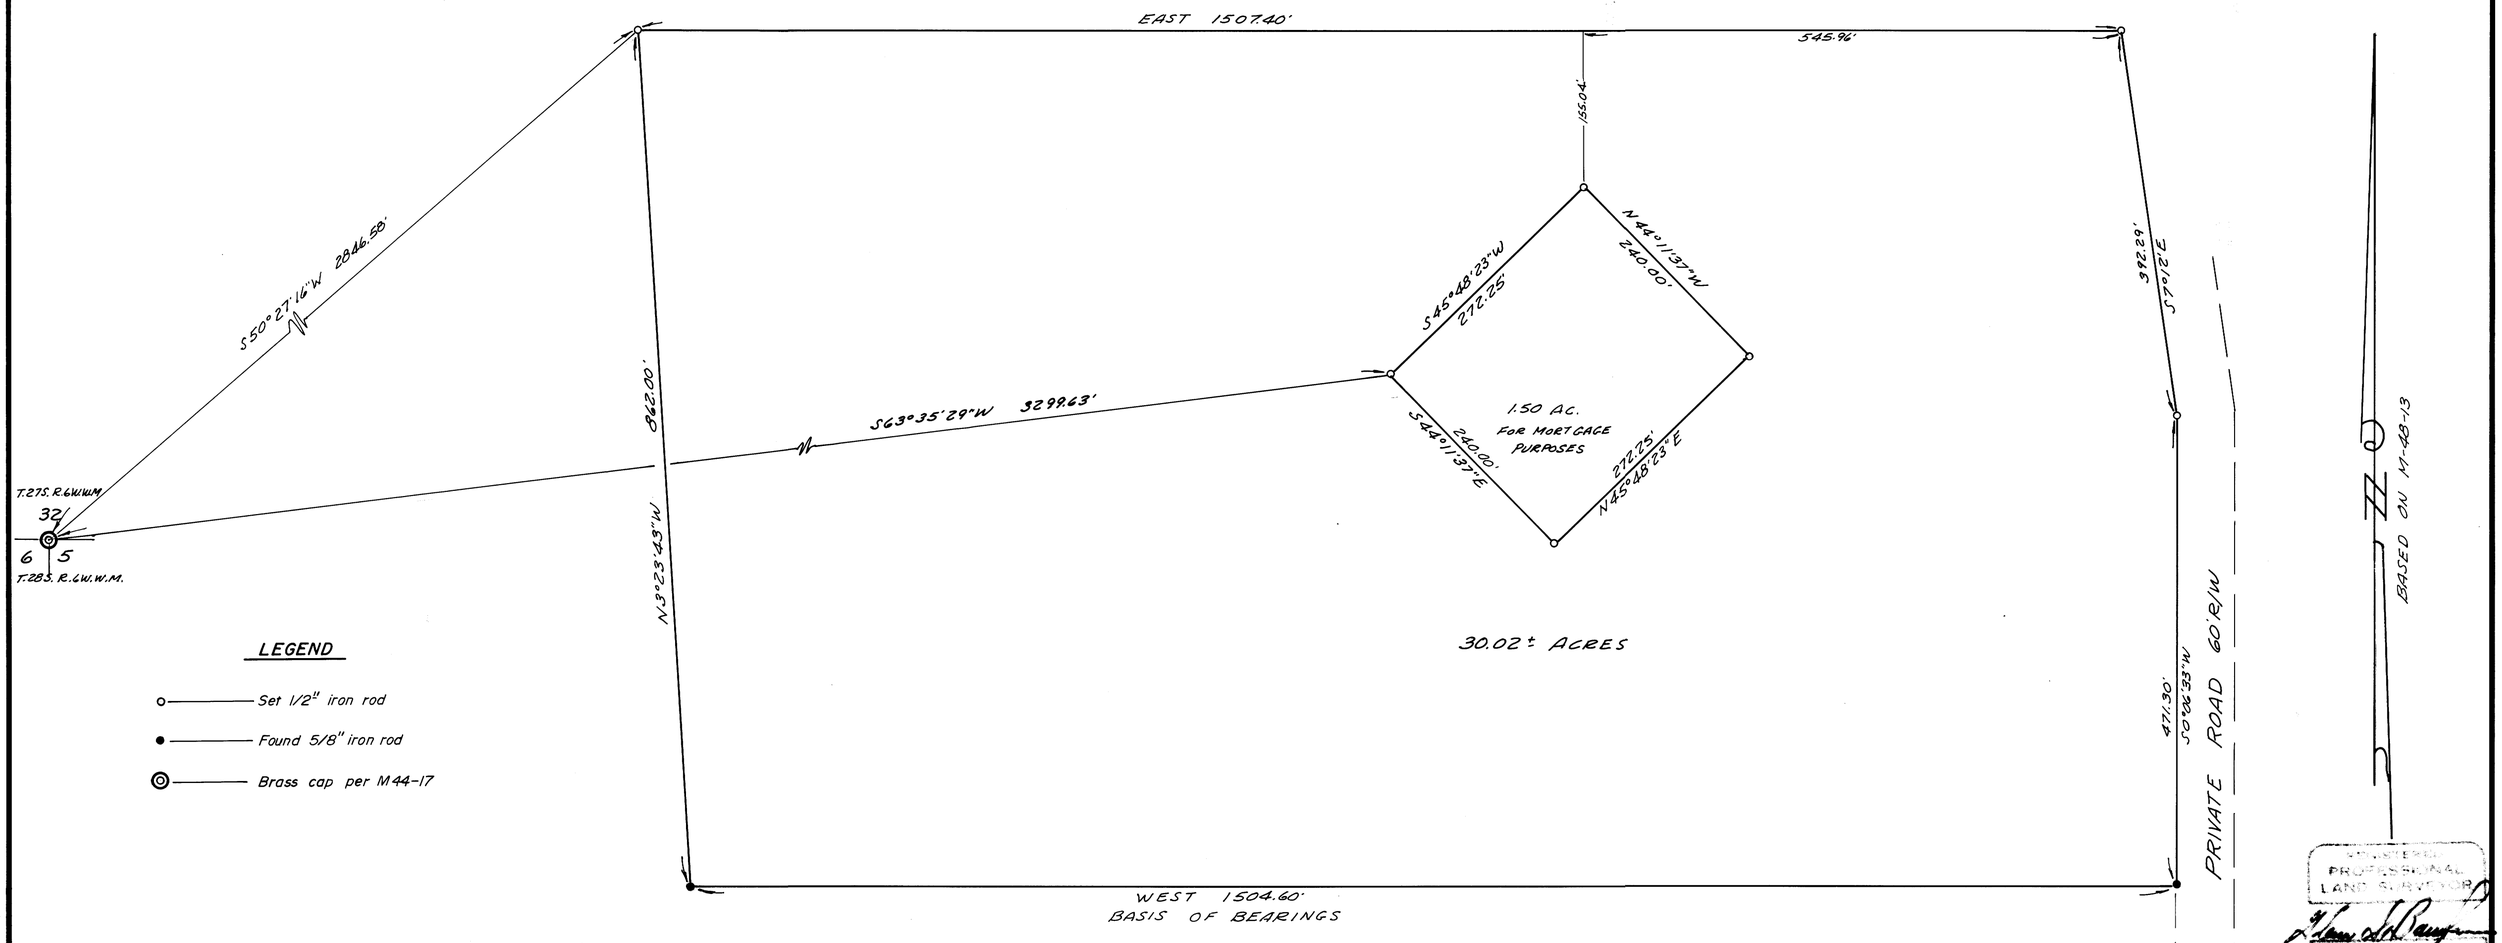

REGISTERED PROFESSIONAL LAND SURVEYOR

35499

M58-48