SURVEY FOR DESCRIPTION
IN SECTION 4, T.23S. R.5W.W.M.

YONCALLA, ORE. Devores Addn Bl 2 Lots 17-18-19

FOR: ASSEMBLY OF GOD CHURCH
BY: BAUGHMAN SURVEYING SERVICE

DECEMBER 1975
SCALE: 1"=60'

COUNTY SURVEYORS FILE DATA
DO NOT REMOVE FROM OFFICE

FILED
RECEIVED
JAN 18 1976
COUNTY SURVEYOR
DOUGLAS COUNTY, ORE.

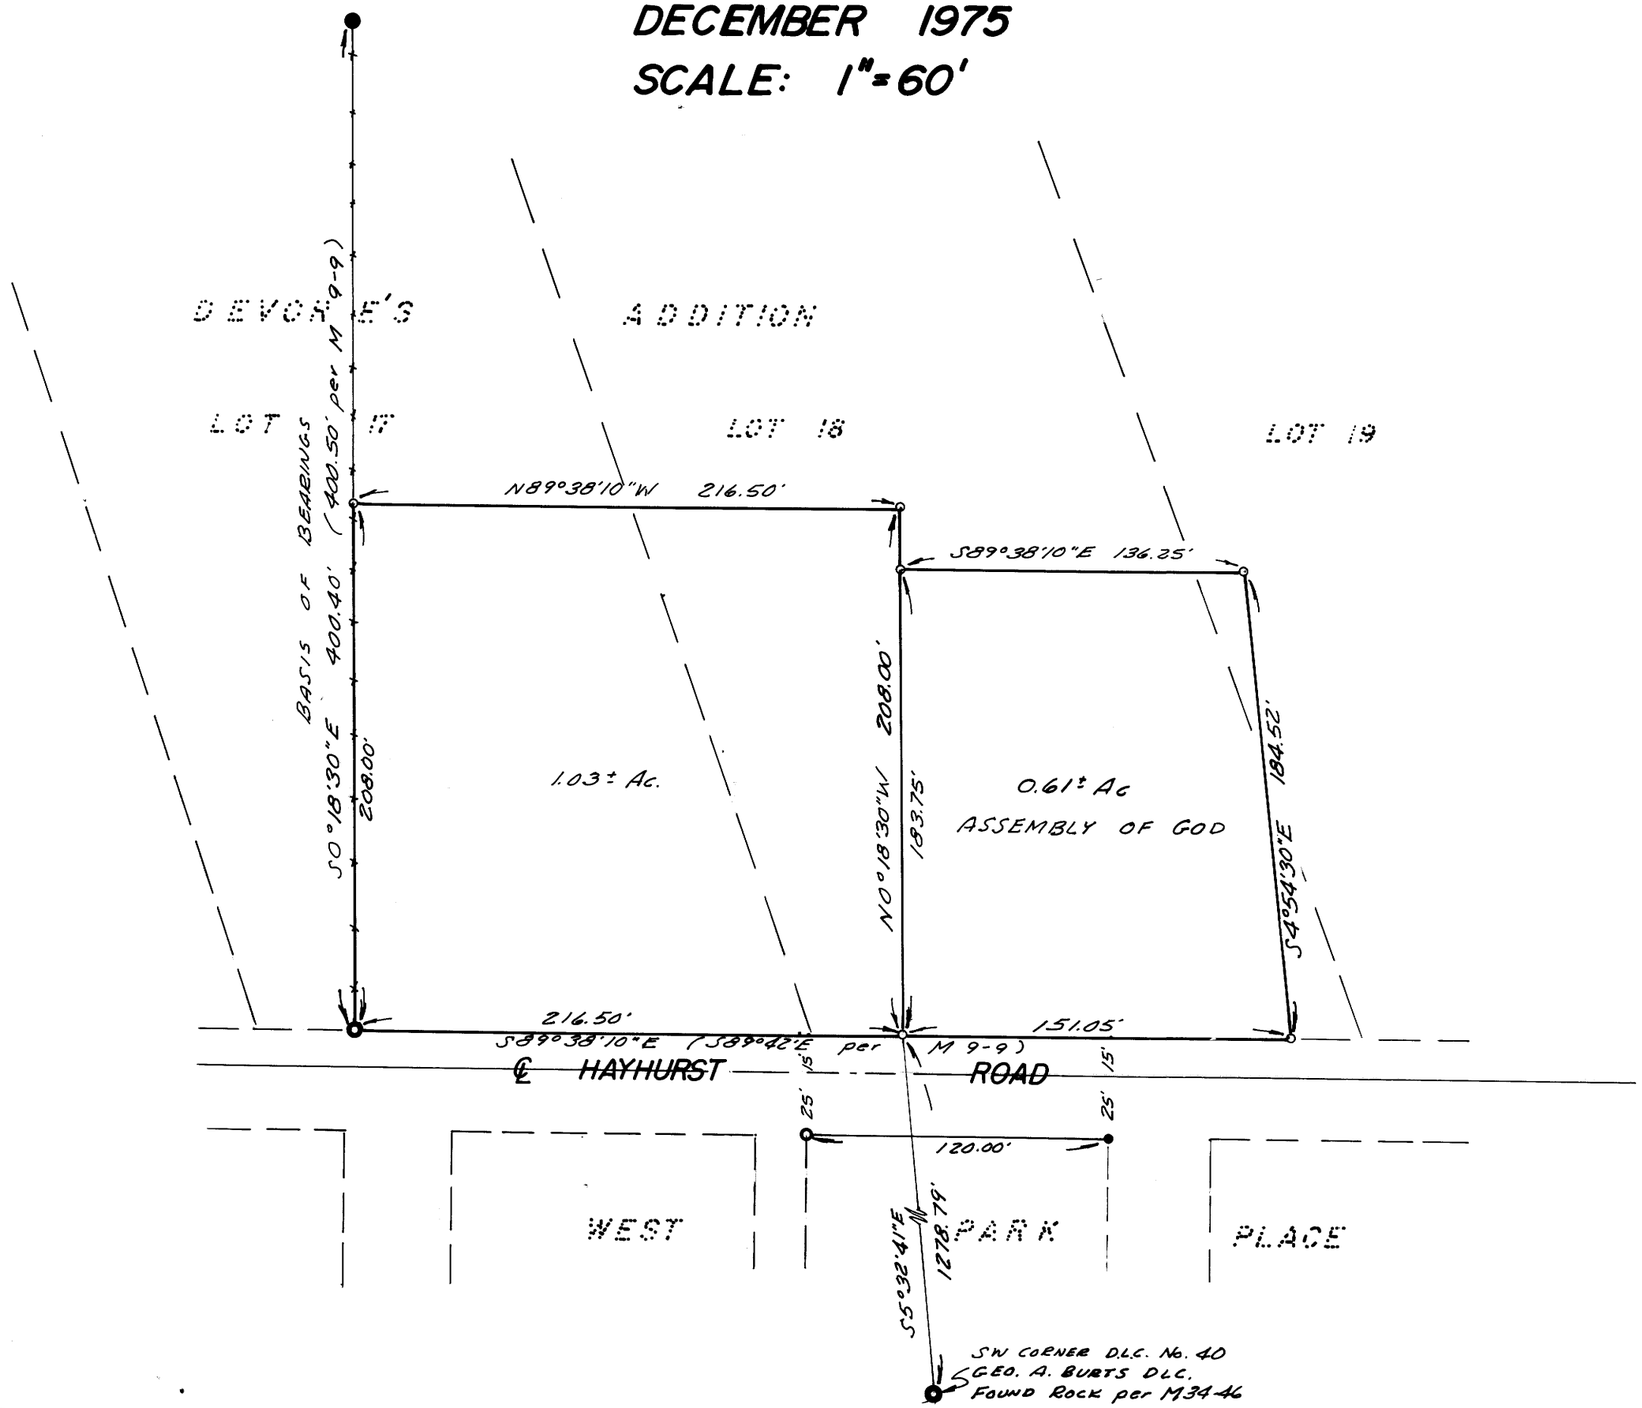

Based on M 9-9

LEGEND

- Set 1" iron pipe
- Found 1/2" iron pipe
- Found 1" iron pipe
- Found rock per M34-46
- Found 1-3/4" iron pipe
- Found 2" iron pipe

MAP FILE M52-1

36011