FILED
RECEIVED mg
JAN 19 1976
COUNTY SURVEYOR
DOUGLAS COUNTY, ORE.

DESCRIPTION OF MONUMENTS AND ACCESSORY TIES

(1) FOUND 1" PIN WITH PIECE OF IRON WELDED ON NORTHERLY SIDE, BESIDE ORIGINAL STONE:
FROM WHICH: A 15" LAUREL SHELL BEARS S 76°30' E 10.6', SCRIBE VISIBLE.
A 12" LAUREL BEARS N 11°E 10.8', SCAR VISIBE.
A 5" FIR BEARS N33°E 9.3', SCAR VISIBLE.
A 36" FIR BEARS S24°E 21.0', SCAR VISIBLE.
A 9" LAUREL BEARS S72°W 64.0', SCAR VISIBLE.

(2) FOUND 3/4" PIPE BESIDE ORIGINAL STONE:
FROM WHICH: A 14" CEDAR BEARS N17°W 27.8', SCRIBE VISIBLE.
A 10" FIR BEARS S 4°W 52.0', SHOWS SCARS.

(3) FOUND 3/4" PIPE BESIDE ORIGINAL STONE:
FROM WHICH: A 24" PINE BEARS N18°E 25.7', SHOWS SCARS.
A 24" FIR BEARS S47°W 24.8', SHOWS SCARS.
A 14" FIR BEARS N 34°W 20.4' SHOWS SCARS
A 6" CHINQUAPIN BEARS N 87°W 17.0' SHOWS SCAR
A 6" CHINQUAPIN BEARS N 69°W 25.8' SHOWS SCAR

(4) FOUND 1" PIPE WITNESS CORNER WITH 2 1/2" BRASS DISK TOP STAMPED:
COUNTY SURVEYORS OFFICE · T30S R2W WIT. COR. 5' SOUTH TO 1/4 S14 | S13 · 1968
FROM WHICH: A 15" CEDAR BEARS N 60°W 18.6' SCRIBE VISIBLE
A 18" FIR BEARS S 43°E 19.6' SHOWS SCARS
O.B.T. A 22" LAUREL NOW DOWN BEARS N 2°E
20.5' FROM 1/4 CORNER

(5) SET 2" PIPE WITH 3" DIA. BRASS DISK TOP STAMPED:
T30S R2W · C · C 1/4 S13 · C · PLS 961 1975
FROM WHICH: A 14" PINE BEARS S 17°W 37.0' SCRIBED C 1/4 S13 BT
A 11" CHINQUAPIN BEARS S 58°W 13.3' SCRIBED C 1/4 S 13 BT

(6) FOUND 1" PIPE WITH 2 1/2" BRASS DISK TOP STAMPED:
COUNTY SURVEYORS OFFICE · T 30 S · R 2 W · S13 | S18 · 1968
FROM WHICH: A 38" FIR BEARS S 10°E 5.3', SCRIBE VISIBLE
A 12" FIR BEARS N 30° W 10.8', SCRIBE VISIBLE

(7) SET 2" PIPE WITH 3" DIA. BRASS DISK TOP STAMPED:
T30S R2W · S1/16 · S14 | S13 · PLS 961 1975
FROM WHICH: A 15" FIR BEARS N 10°36'E 50.6' SCRIBED S 1/16 S13 BT.
A 16" FIR BEARS S16°20'W 19.0' SCRIBED S 1/16 S14 BT.

(8) SET 2" PIPE WITH 3" DIA. BRASS DISK TOP STAMPED:
T30S R2W · SW 1/16 · S 13 · PLS 961 1975
FROM WHICH: A 17" PINE BEARS N80°29'E 7.9' SCRIBED SW 1/16 S13 BT.
A 10" FIR BEARS S28°25'W 10.6' SCRIBED SW 1/16 S13 BT.

(9) FOUND 2" PIPE WITH 3" DIA. BRASS DISK TOP STAMPED:
U.S. CADASTRAL SURVEY · T30S R2W · S14 | S13 · S23 | S24 · 1963 · BUREAU OF LAND MAN.
FROM WHICH: A 36" OAK BEARS N 26°30'E 91.1' (O.B.T.)
A 15" OAK BEARS N 4°E 46.9' SCRIBE VISIBLE
A 28" FIR BEARS S 75°30' W 119.5' SHOWS SCARS
A 17" OAK BEARS N52°W 99.7' BARK SCRIBE VISIBLE
A 2'×4'×1' SANDSTONE WITH + ON TOP BEARS S 69°30'E 46.9'

(10) SET 2" PIPE WITH 3" DIA. BRASS DISK TOP STAMPED:
T30S R2W · W 1/16 · S13 · S24 · PLS 961 1975
FROM WHICH: A 17" FIR BEARS S67°23'E 36.7' SCRIBED W 1/16 S24 BT.
A 22" FIR BEARS N21°47'W 40.6' SCRIBED W 1/16 S13 BT.

(11) FOUND 1" PIPE WITH 2 1/2" BRASS DISK TOP STAMPED:
COUNTY SURVEYORS OFFICE · T30S R2W · 1/4 S13 S24 · 1968
FROM WHICH: A 28" D. FIR BEARS N 40°W 6.7' RECENT SCRIBE VISIBLE.
A 40" D. FIR BEARS S 10°E 41.0' RECENT SCRIBE VISIBLE.

(12) FOUND 1" PIPE WITH 2 1/2" BRASS DISK TOP STAMPED:
COUNTY SURVEYORS OFFICE · T30S R1W · S13 S18 · S24 S19 · R2W · 1968
FROM WHICH: A 24" FIR BEARS N 56°E 20.0', BARK SCRIBE VISIBLE
A 20" FIR BEARS S 53°30' E 14.8', BARK SCRIBE VISIBLE
A 18" FIR BEARS S 79°30' W 19.4', BARK SCRIBE VISIBLE
A 24" FIR BEARS N 62°30' W 48.2', BARK SCRIBE VISIBLE

(13) FOUND 3/4" PIPE EXP. 21". ORIG. STONE ALONGSIDE. 11 | 12 / 13
FROM WHICH: A 18" MADRONE WINDFALL BEARS N 41 1/2°E 27.7'
SCRIBE VISIBLE O.B.T.
FOUND RECENT B.T.'S PER RENEWAL C.S. FILE
NO. 42/421

(14) FOUND 3/4" PIPE, 1/4 CORNER SEC. 12 ONLY.
FROM WHICH: A 20" FIR, UPROOTED, BEARS N 40°E 5.9' O.B.T.
FOUND RECENT B.T.'S PER RENEWAL C.S. FILE
NO. 42/421

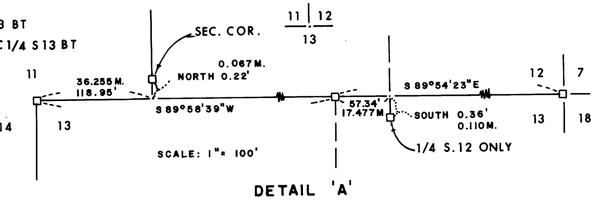

DETAIL 'A'

LEGEND:
□ = FOUND MONUMENT AS SHOWN.
O = SET MONUMENT AS SHOWN.
——— = TRUE LINE POSTED WITH STEEL FENCE POSTS AND GOVERNMENT PROPERTY SIGNS.

BASIS OF BEARINGS: POLARIS OBSERVATION.

FIELD BOOKS REFERENCED UNDER CONTRACT NO. 004938N, BOOKS NO. 4, 6, 8 & 10

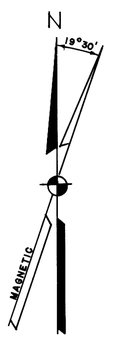

REGISTERED PROFESSIONAL LAND SURVEYOR
OREGON
JULY 16, 1971
LARRY J. FRIAR
961

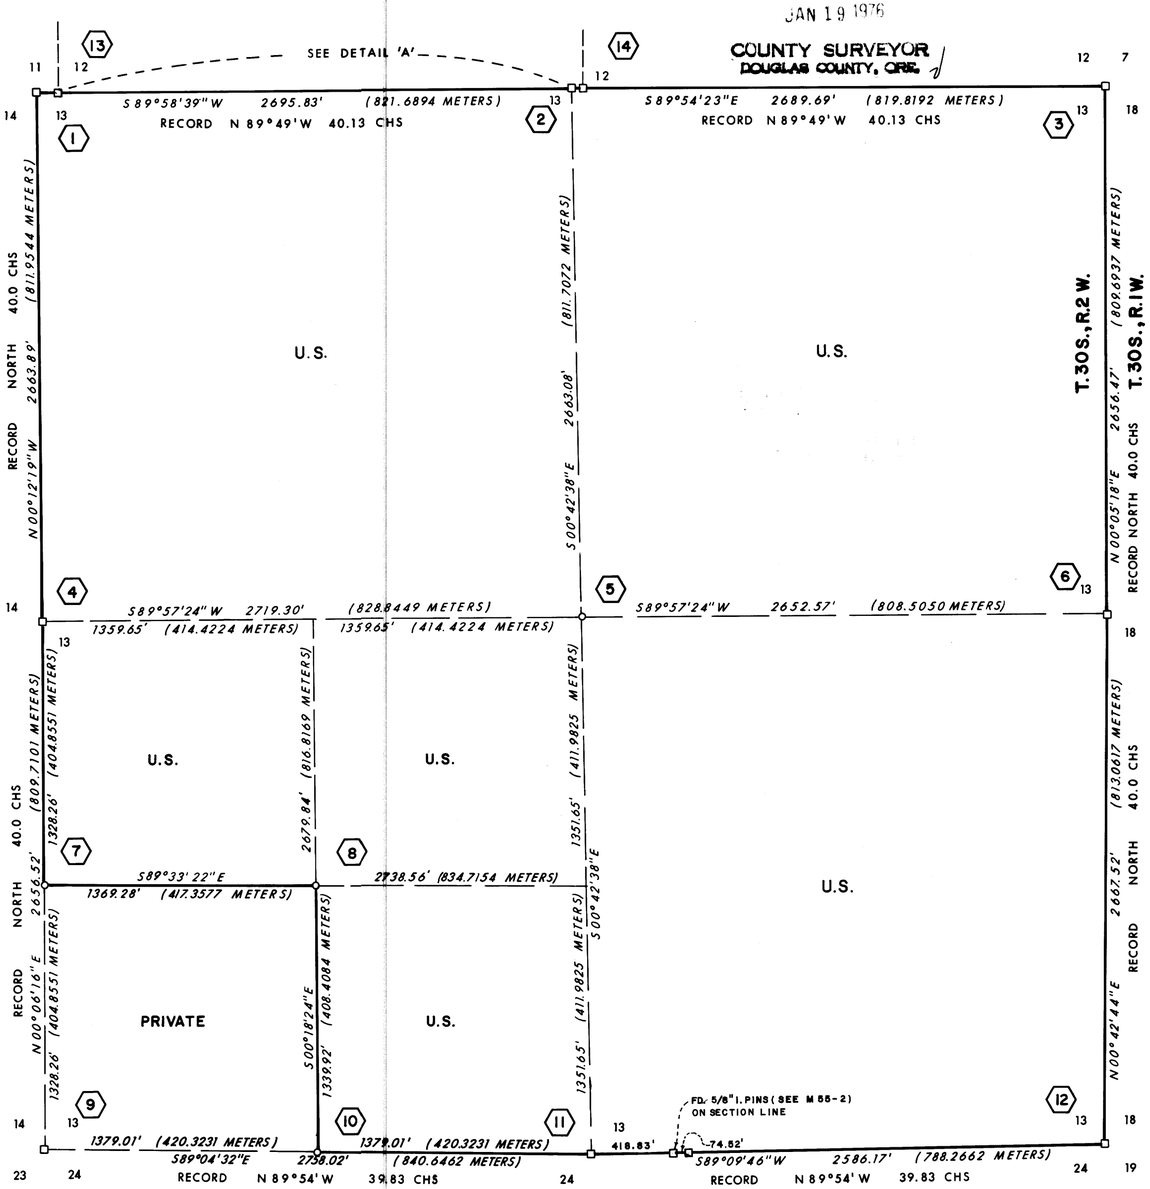

I, LARRY J. FRIAR, A REGISTERED LAND SURVEYOR IN THE STATE OF OREGON, HEREBY CERTIFY THAT THIS PLAT AND THE NOTES HEREON ARE A CORRECT REPRESENTATION OF A SURVEY I PREFORMED DURING DECEMBER, 1975, FOR THE U.S. FOREST SERVICE, IN ACCORDANCE WITH THE STATUTES OF THE STATE OF OREGON AND THE ARTICLES OF MY CONTRACT.

LARRY J. FRIAR
REGISTERED LAND SURVEYOR NO. 961

PLAT OF SURVEY
FOR
THE UNITED STATES DEPARTMENT OF AGRICULTURE
UMPQUA NATIONAL FOREST
CONTRACT NO. 004938N
BEING SECTION 13, T. 30S., R2W., W.M.
DOUGLAS CO. SCALE: 1"=500
OREGON DECEMBER, 1975
TILLER LAND SURVEY NO. 18
PREPARED BY
FRIAR-MOFFIT SURVEYING CO.
MEDFORD, OREGON

COUNTY SURVEYORS FILE DATA
DO NOT REMOVE FROM OFFICE

M 59-11
M 64-11