MAP FILE M60 - 10

SURVEY TO LOCATE PROPERTY CORNERS
IN SECTION 20, T.25S. R.5W.W.M.
FOR: JOSEPH NORRIS
BY: BAUGHMAN SURVEYING SERVICE

COUNTY SURVEYORS FILE DATA
DO NOT REMOVE FROM OFFICE

FILED
RECEIVED
MAY 7 1976
COUNTY SURVEYOR
DOUGLAS COUNTY, ORE.

APRIL 1976 SCALE: 1"=200'

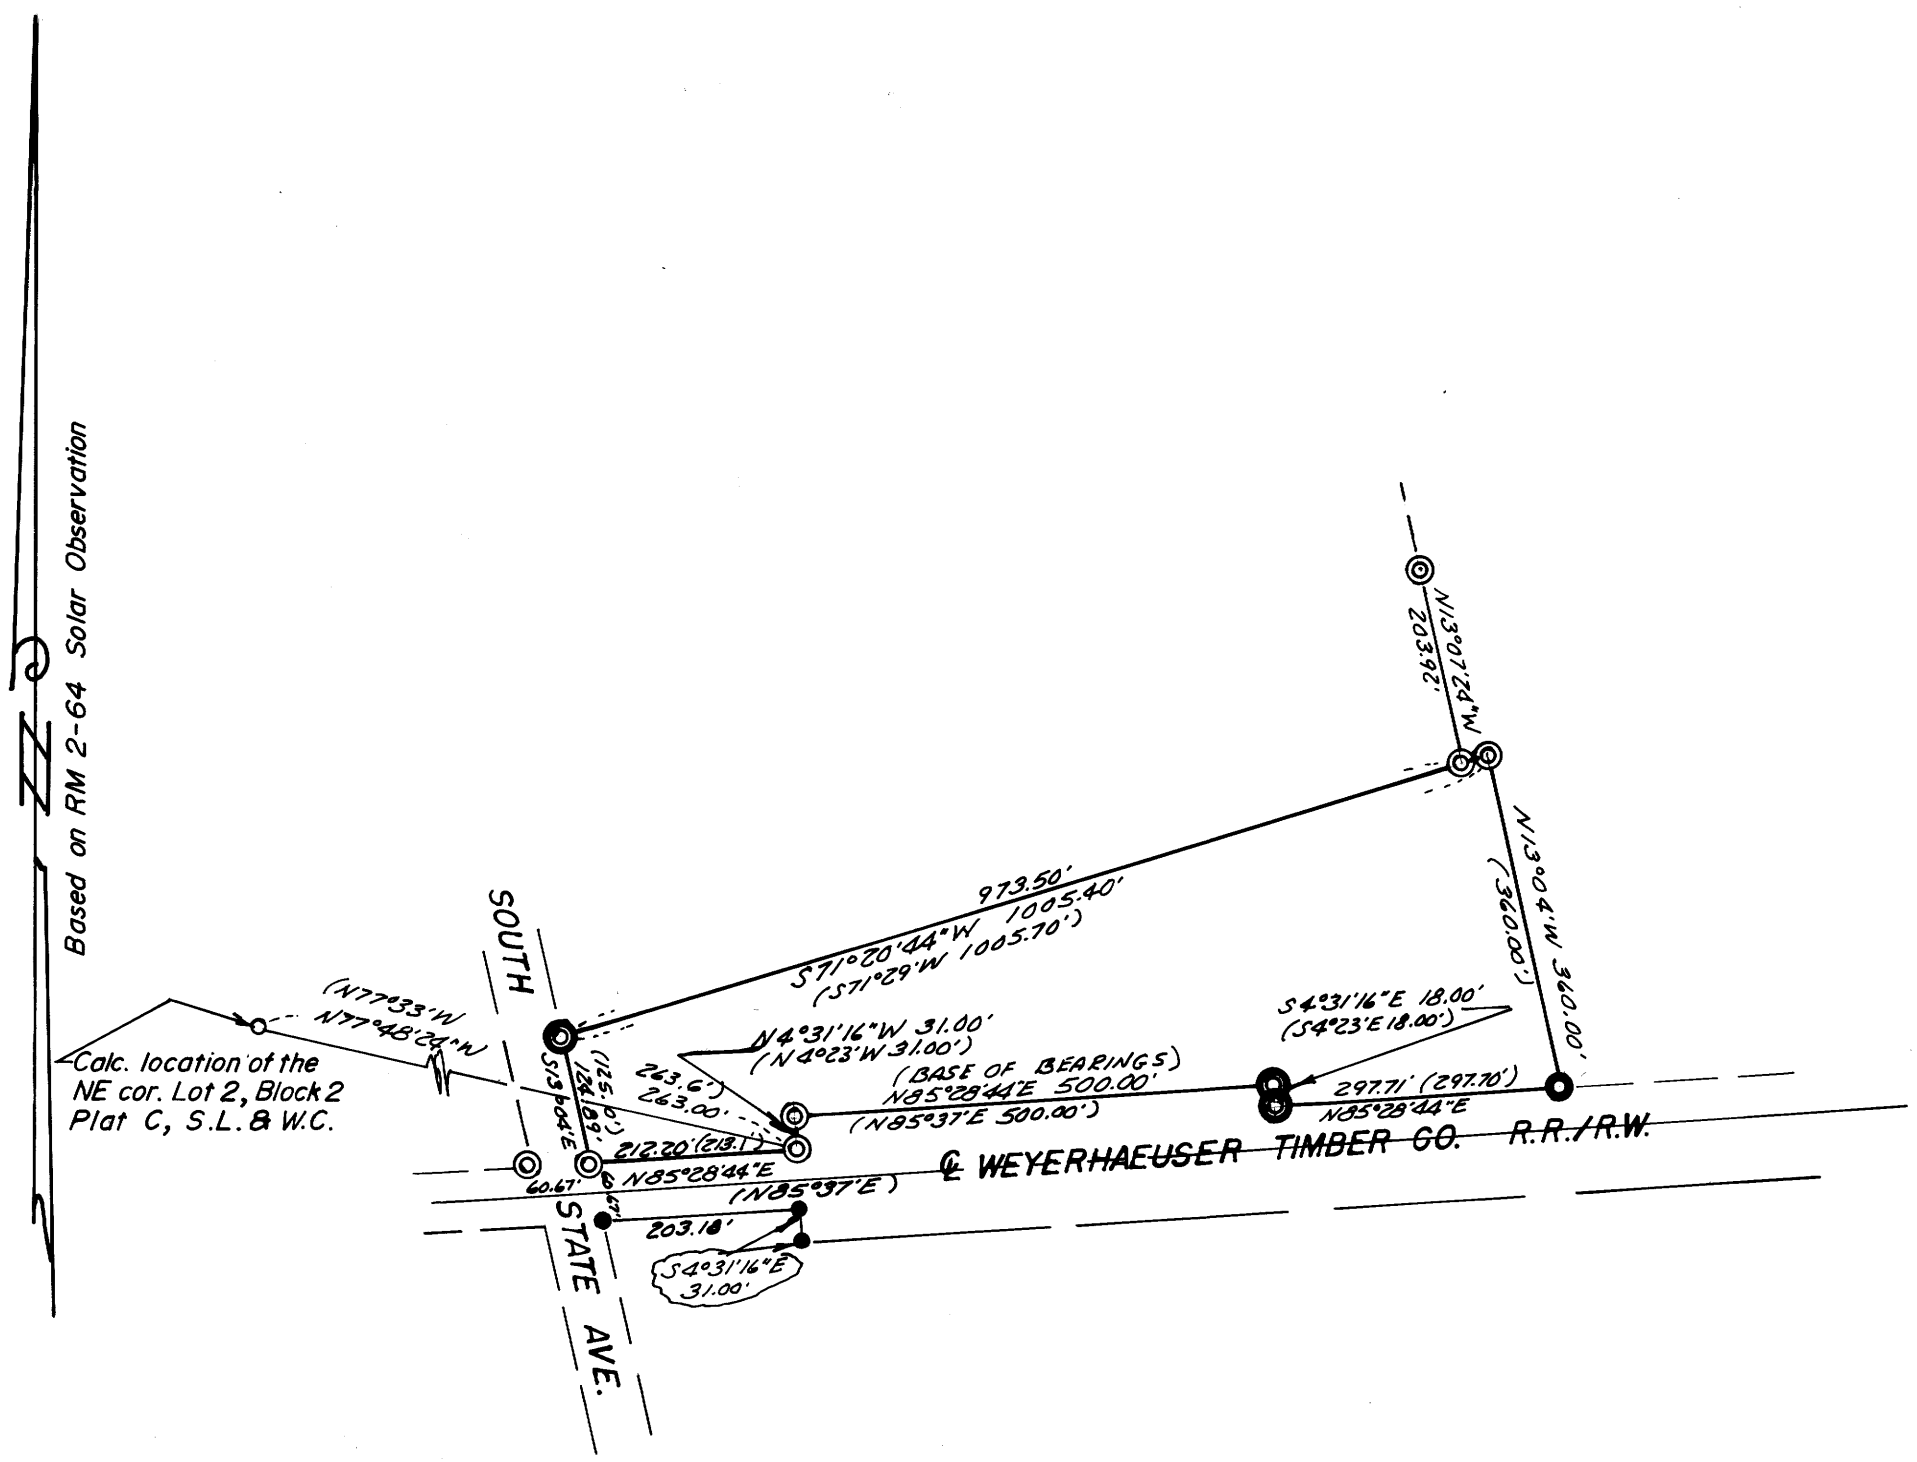

Eugene A. Baughman

LEGEND

- Found 1/2" iron rod
- Found 5/8" iron rod
- Found 3/4" iron pipe
- Found 1-1/2" iron pipe

Note: The above found points were either shown as found or set, per RM 2-71, DCSO.

36285

MAP FILE M60 - 10