FILED
RECEIVED
MAY 11 1976
COUNTY SURVEYOR
DOUGLAS COUNTY, ORE.

MAP FILE M60-13

Survey For Deed Description

Sect. 17, T. 22 S., R. 5 W. W. M.

Mills Mortuary Cottage Grove, Oreg.

Scale 1" = 40' May 1, 1976.

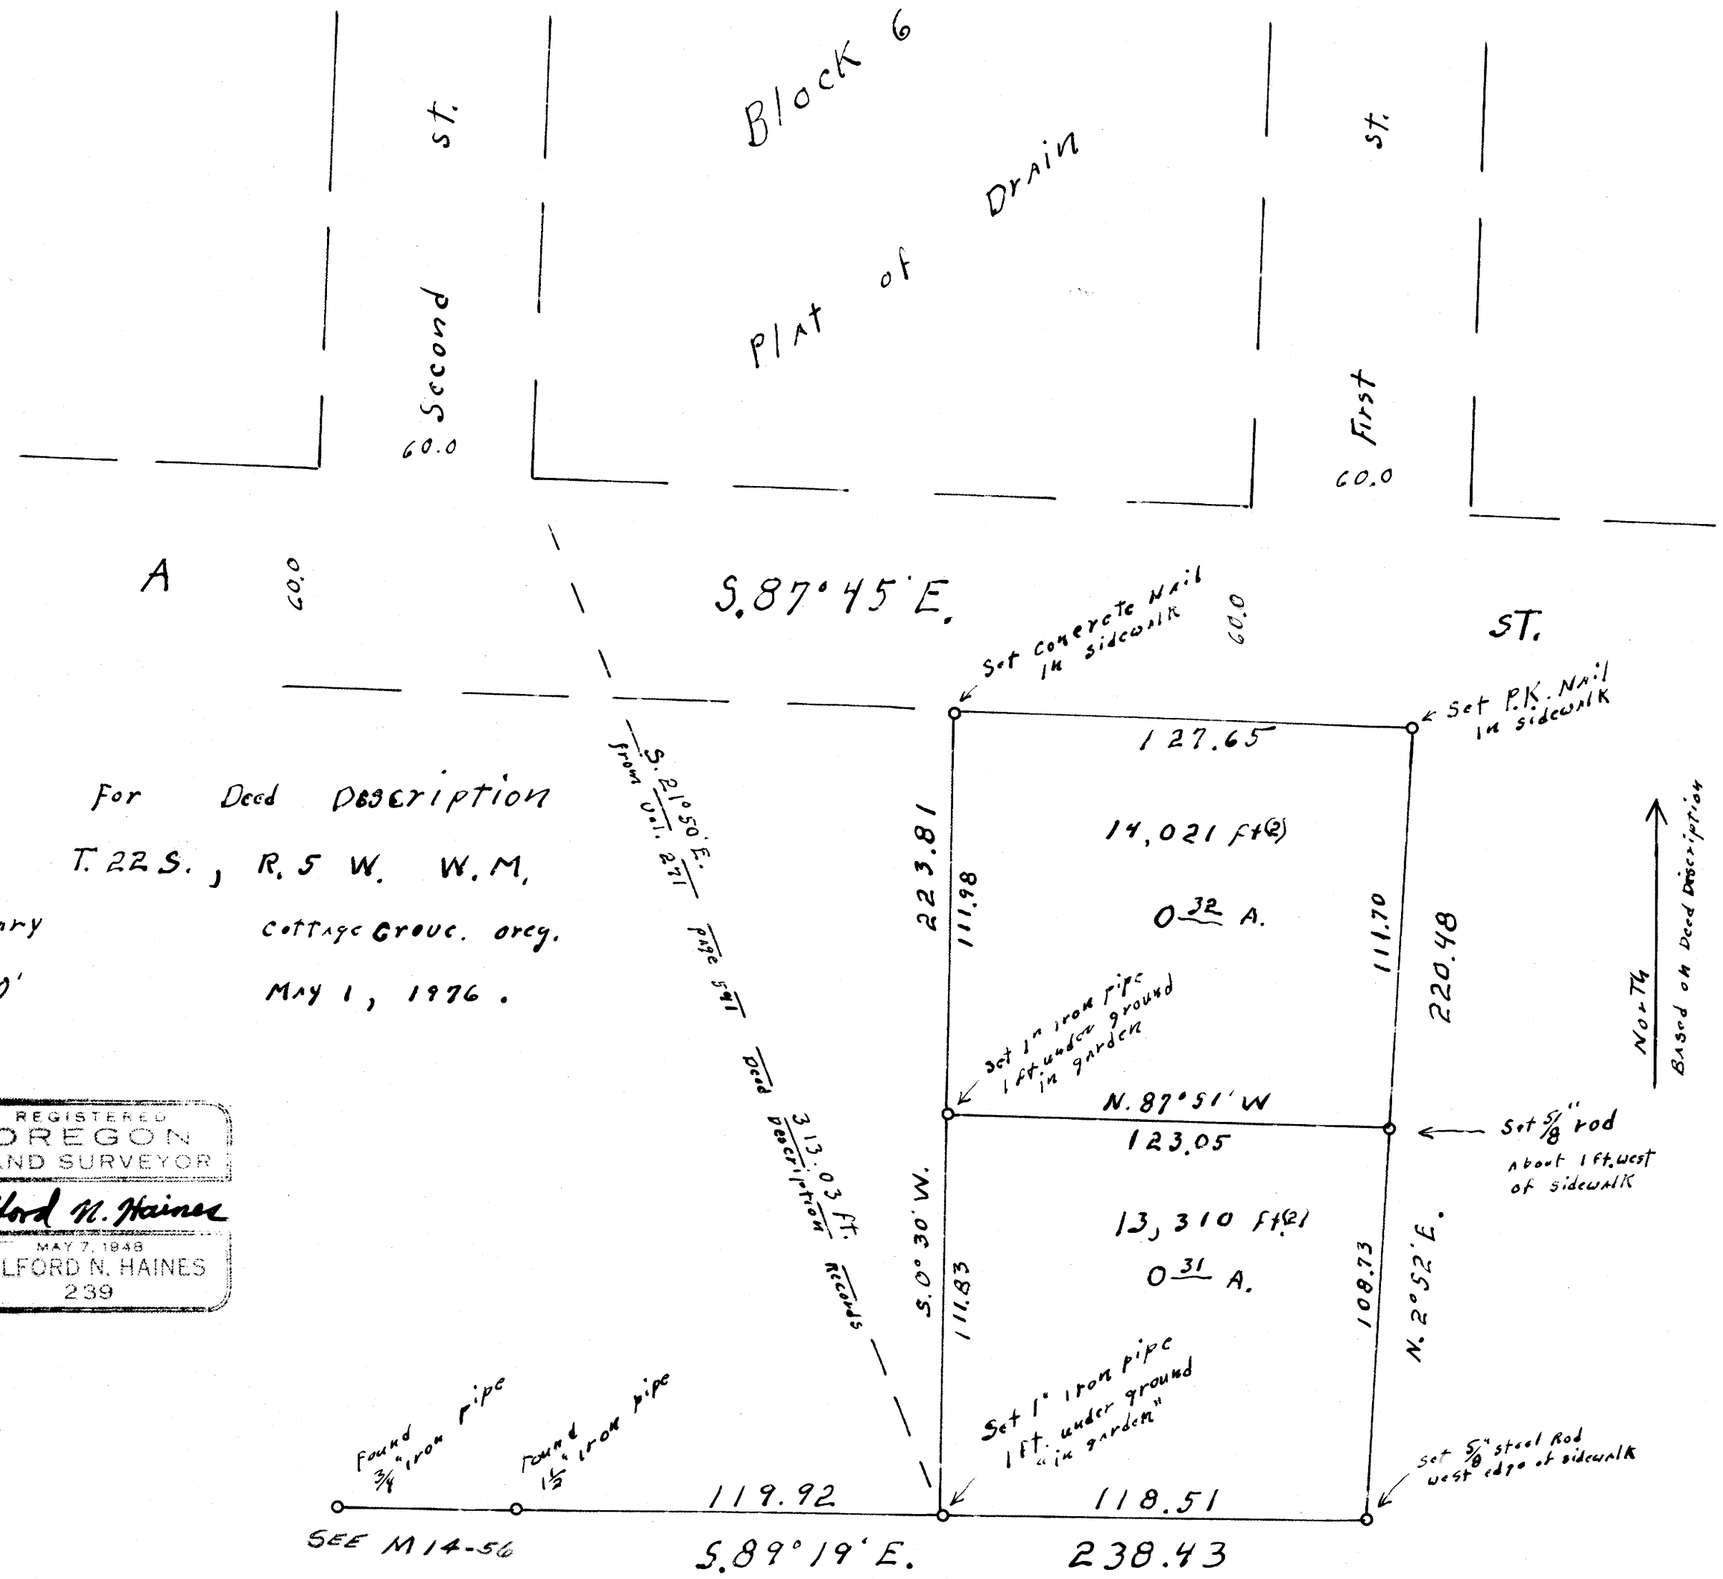

SEE M14-56

REGISTERED
OREGON
LAND SURVEYOR
Wilford N. Haines
MAY 7, 1948
WILFORD N. HAINES
239

COUNTY SURVEYORS FILE DATA
DO NOT REMOVE FROM OFFICE

MAP FILE M60-13