COUNTY SURVEYOR FILE MAP
DO NOT REMOVE FROM OFFICE

FILED
RECEIVED
JUN 02 1976
COUNTY SURVEYOR
DOUGLAS COUNTY, ORE.

MAP FILE M 60-31

# SURVEY TO SET CORNERS FOR PARCEL FOR 'FINANCING' IN SEC. 11, T.28S., R.7W., W.M. DOUGLAS CO., ORE FOR JAMES W. ODELL, RT. 4 BOX 721 ROSEBURG, ORE.

BY HERBERT L. NORTHCRAFT

SCALE 1" = 100'

MAY, 1976

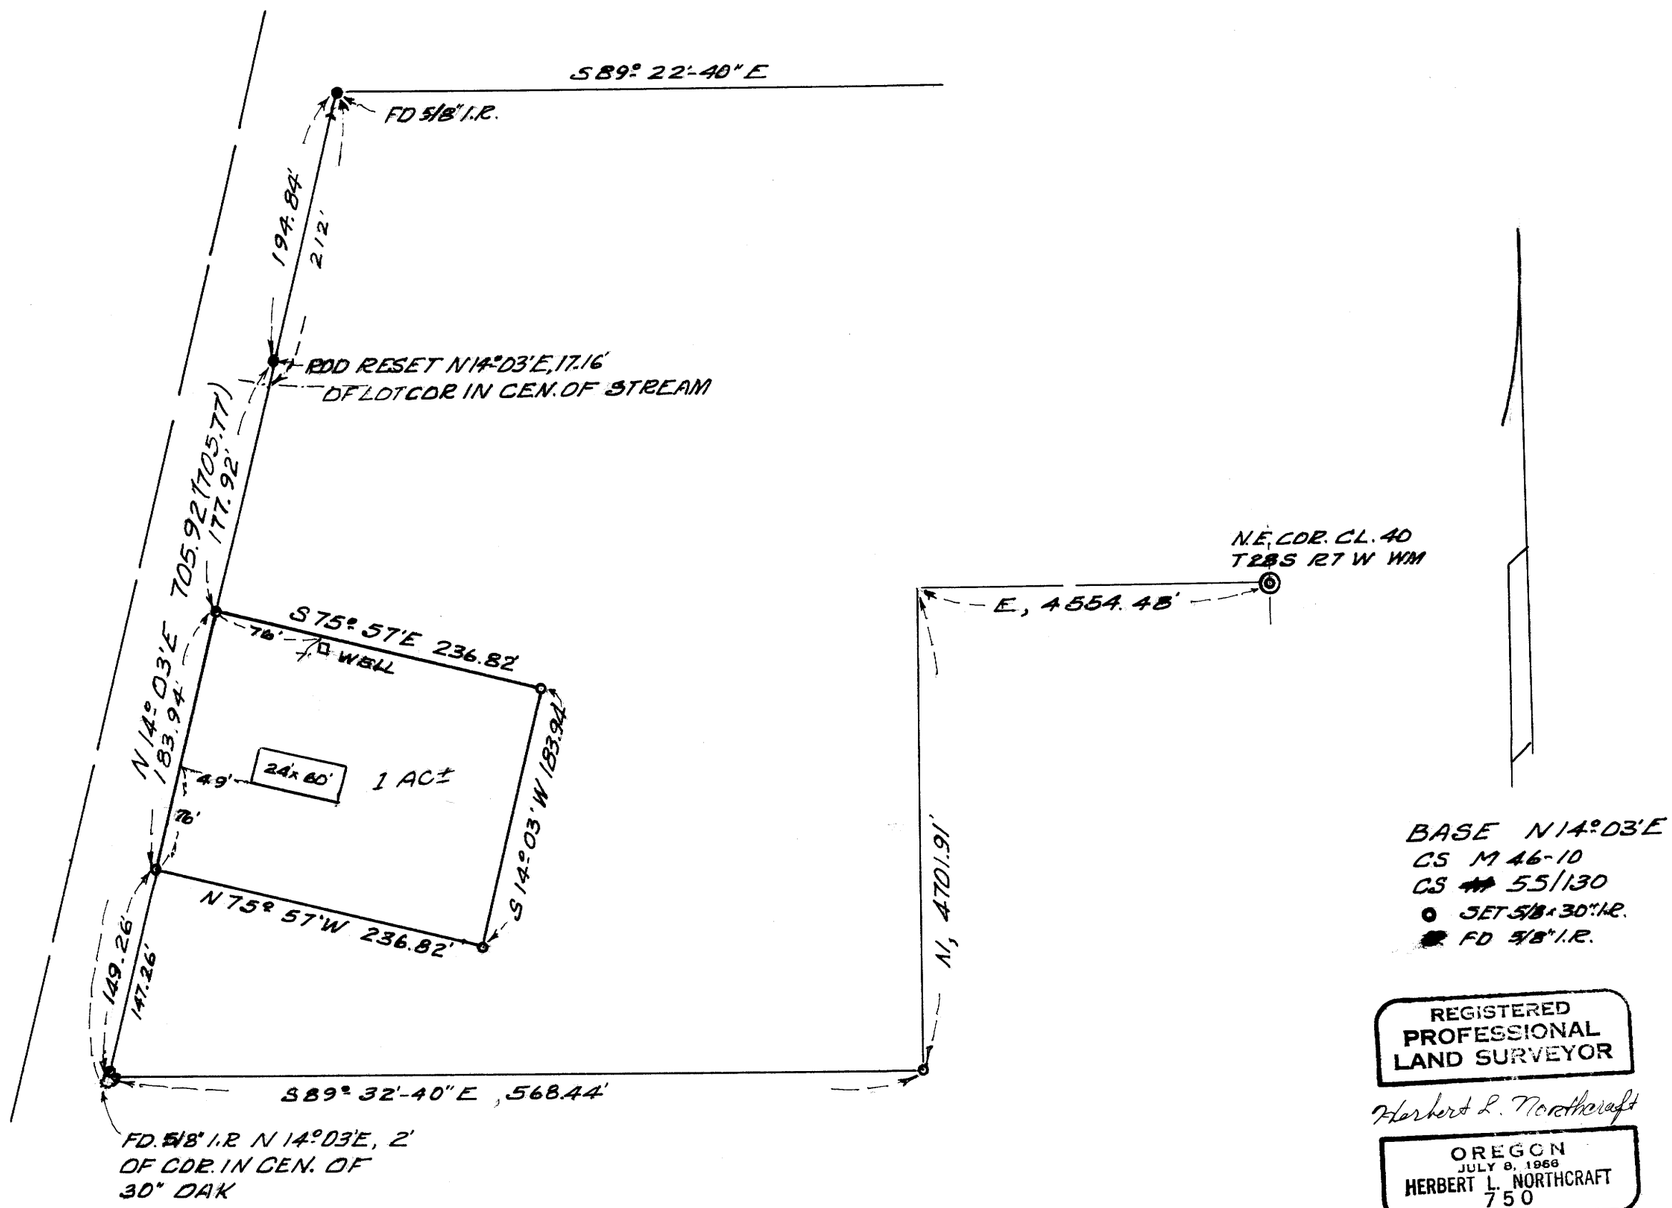


BASE N 14° 03'E
CS M 46-10
CS 55/130
○ SET 5/8 x 30" I.R.
● FD 5/8" I.R.

REGISTERED
PROFESSIONAL
LAND SURVEYOR

Herbert L. Northcraft

OREGON
JULY 8, 1966
HERBERT L. NORTHCRAFT
750

MAP FILE M 60-31