

Minor Land Partition of ^{Vol 2 pg 200} Lot 3, East Glide Subdivision in Sec. 17, T. 26 S., R. 3 W., W. M.

Partitioner:

United Bancorp
P. O. Box 1007
Roseburg, Ore. 97470
672-1691

Peter S. Leiken
P. O. Box 783
Winchester, Ore. 97495
672-4883

Legal Owner of Record:

United Bancorp
P. O. Box 1007
Roseburg, Ore. 97470
672-1691

Peter S. Leiken
P. O. Box 783
Winchester, Ore. 97495
672-4883

Total Number of Lots:

2

Water Supply:

Glide Water Assoc.

Sewer Disposal:

Holding tank

Map Prepared By:

Shaner Engineering, Inc.
P. O. Box 1430
Roseburg, Ore. 97470
672-4074

June 1976

FILED
RECEIVED

JUN 1 1976

COUNTY SURVEYOR
DOUGLAS COUNTY

COUNTY SURVEYORS FILE DATA
DO NOT REMOVE FROM OFFICE

LEGEND

Corner found (as noted) ●



Corner set (5/8" iron rod with aluminum cap) ○

Lot 3A Description


Beginning at a 3/4" iron pipe at the southwest corner of Lot 3 of the East Glide Subdivision, a subdivision in Section 17, T 26 S, R 3 W, W. M., Douglas County, Oregon; thence North a distance of 132.53 feet to a 5/8" iron rod at the northwest corner of said Lot 3; thence N58°10'E along the north boundary of said Lot 3 a distance of 117.68 feet to a 5/8" iron rod; thence leaving said north boundary of Lot 3 and bearing South a distance of 164.60 feet to a 5/8" iron rod; thence East a distance of 100.00 feet to a 5/8" iron rod on the east boundary of said Lot 3; thence South along said east boundary of Lot 3 a distance of 30.00 feet to a 5/8" iron rod at the southeast corner of said Lot 3; thence West along the south boundary of said Lot 3 a distance of 200.00 feet to the point of beginning, containing 0.45 acres, more or less, and all being situated in said Lot 3 of the East Glide Subdivision, a subdivision in Section 17, T 26 S, R 3 W, W. M., Douglas County, Oregon.

Lot 3B Description

Beginning at a 5/8" iron rod at the northeast corner of Lot 3 of the East Glide Subdivision, a subdivision in Section 17, T 26 S, R 3 W, W. M., Douglas County, Oregon; thence S58°10'W along the north boundary of said Lot 3 a distance of 117.67 feet to a 5/8" iron rod; thence leaving said north boundary of Lot 3 and bearing South a distance of 164.60 feet to a 5/8" iron rod; thence East a distance of 100.00 feet to a 5/8" iron rod on the east boundary of said Lot 3; thence North along said east boundary of Lot 3 a distance of 226.66 feet to the point of beginning, containing 0.45 acres, more or less, and all being situated in Lot 3 of the East Glide Subdivision, a subdivision in Section 17, T 26 S, R 3 W, W. M., Douglas County, Oregon.

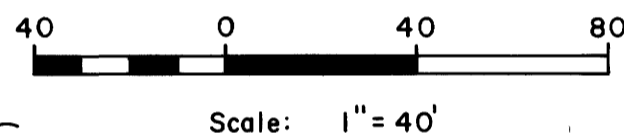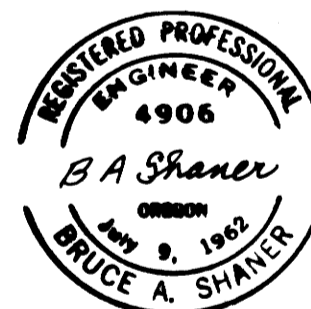

Basis of Bearings:
Subd. Plat

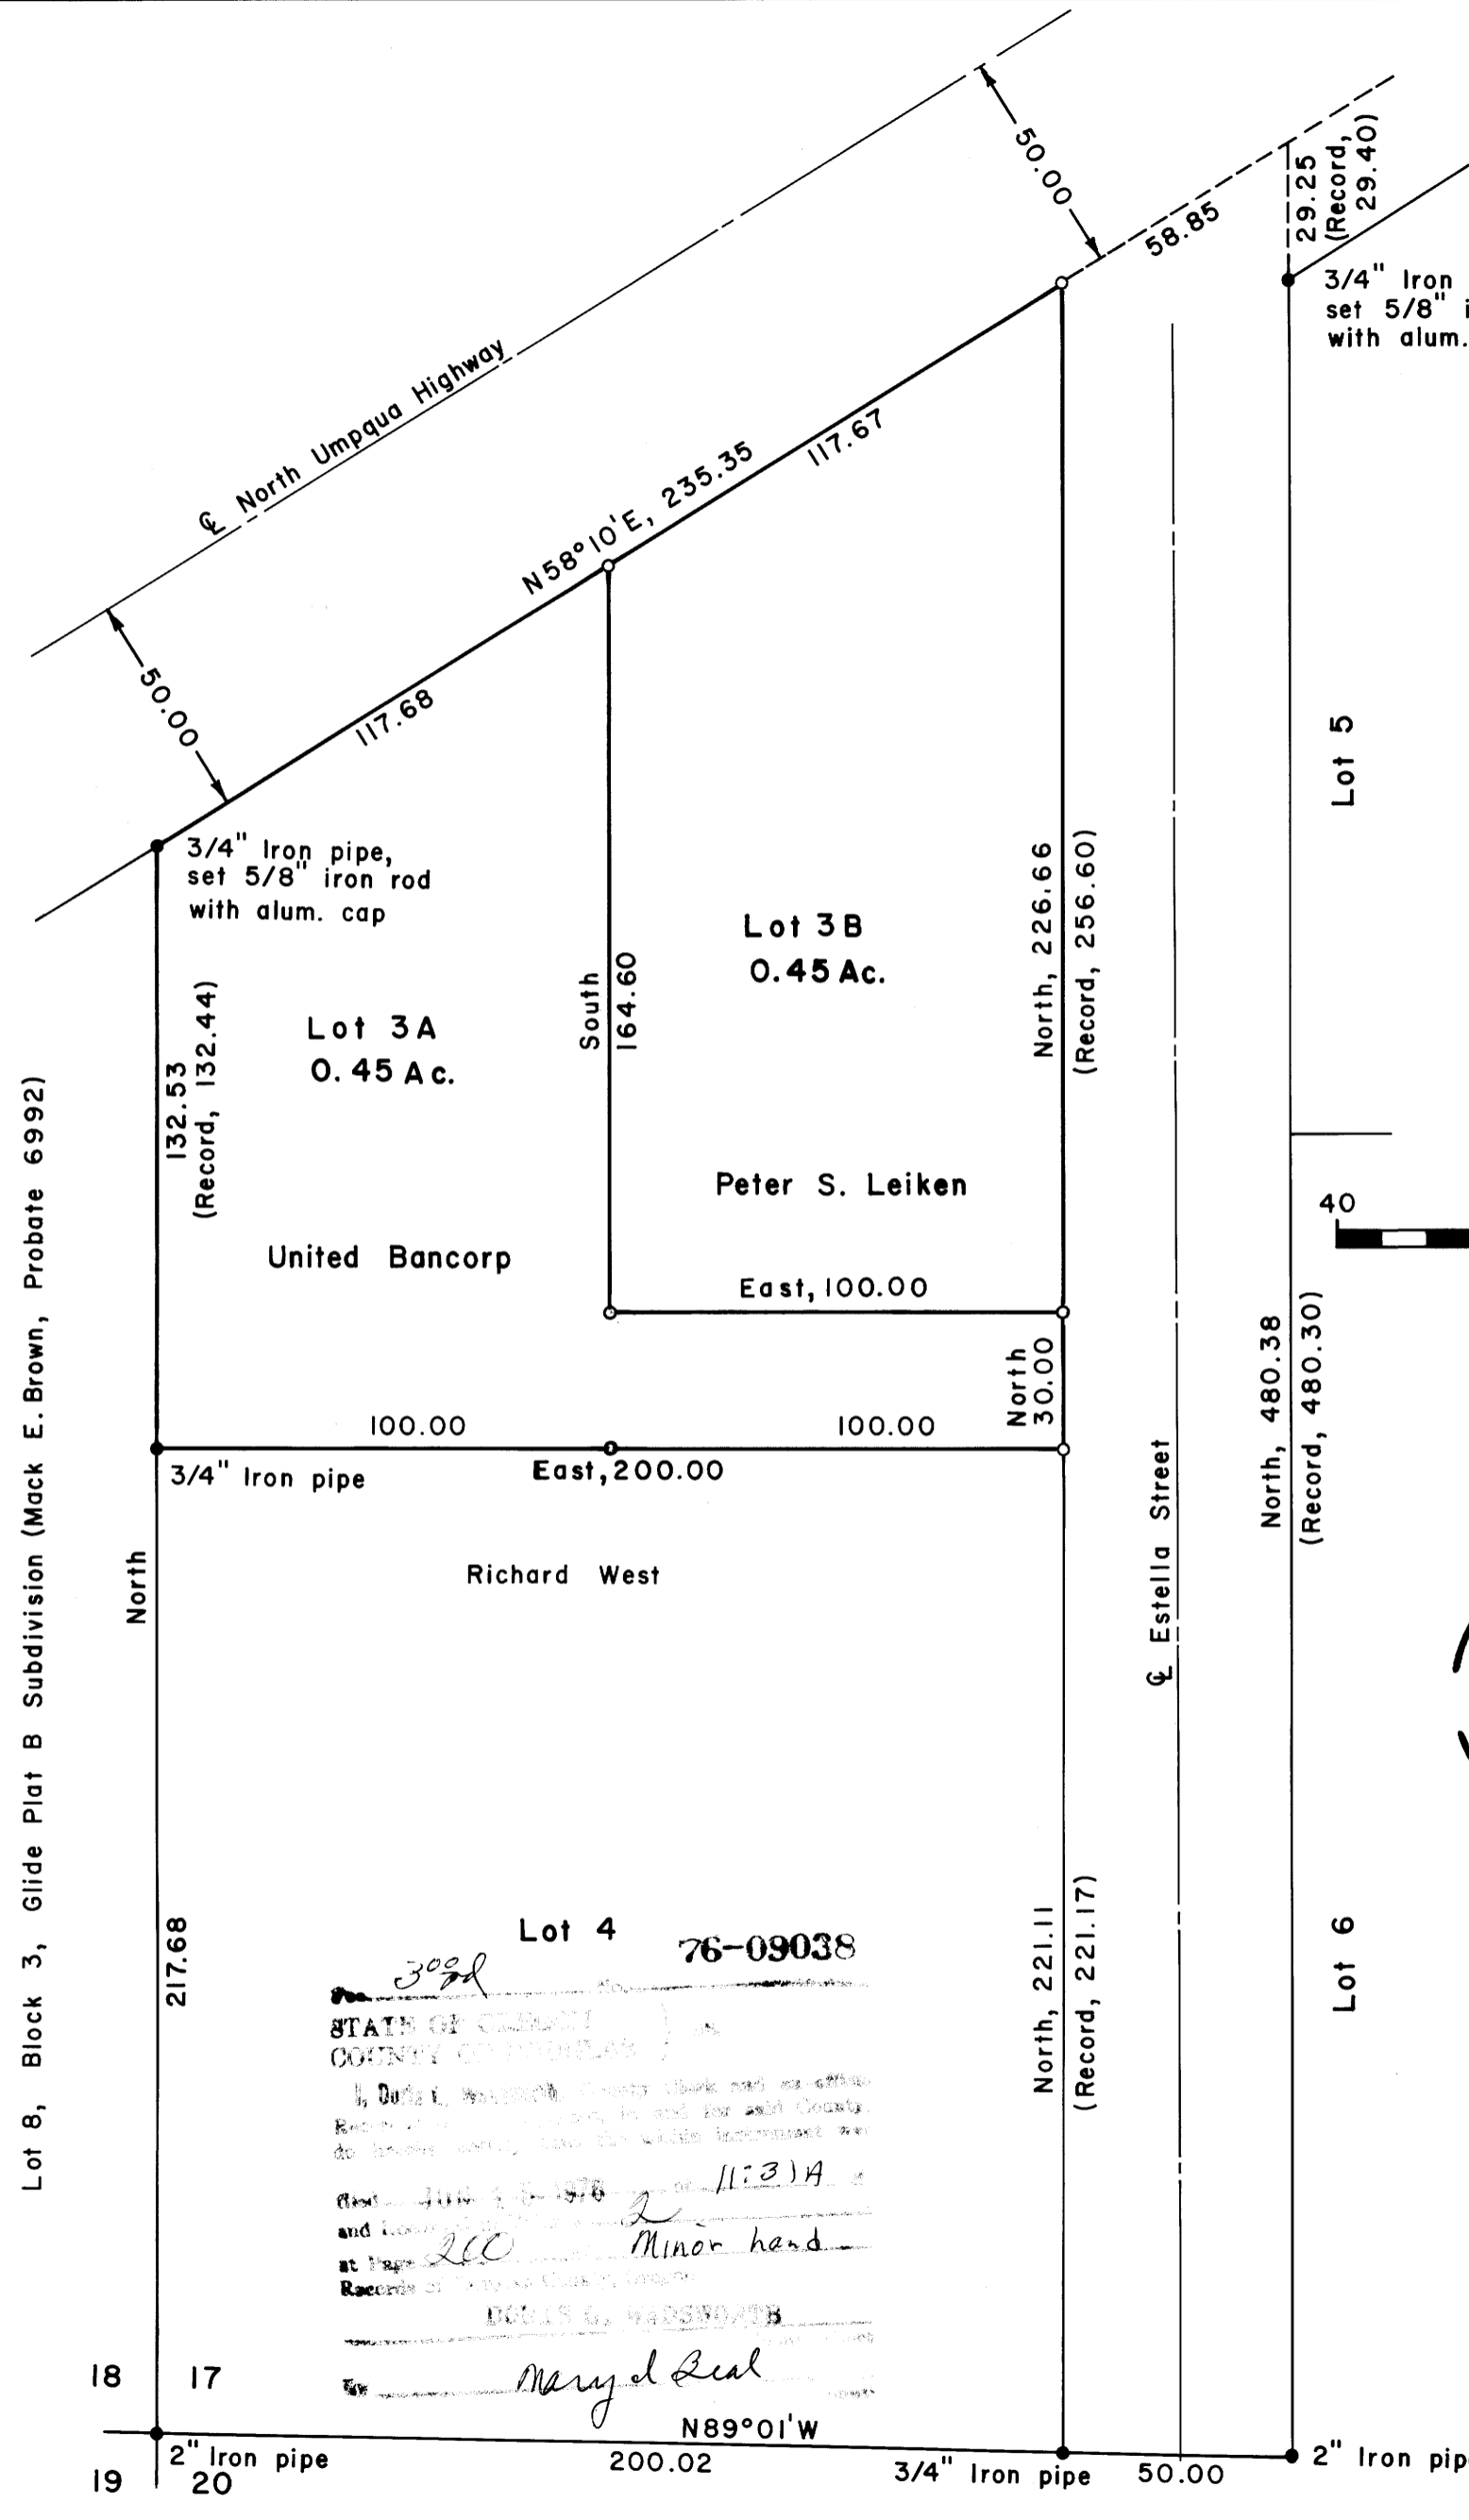

Lot 4 76-09038
STATE OF OREGON
COUNTY OF DOUGLAS
Mary d Seal

Richard Reynolds June 11, 1976
PLANNING COMMISSION Date

Francis L. Ingram 6-14-76
COUNTY SURVEYOR Date

MAP FILE 7160-47

M 60-47