MAP FILE M 6 Q - 6

COUNTY SURVEYORS FILE DATA
DO NOT REMOVE FROM OFFICE

SURVEY FOR DESCRIPTION IN LOT 22, BLOCK 20,- PLAT-O, S.L. & W. CO. SECTION 18, T.25S. R.5W. W.M. - SUTHERLIN, ORE.

FOR: GERALD TUCKER
BY: BAUGHMAN SURVEYING SERVICE

MAY 1976 SCALE: 1"=50'

FILED
RECEIVED
MAY 7 1976
COUNTY SURVEYOR
DOUGLAS COUNTY, ORE.

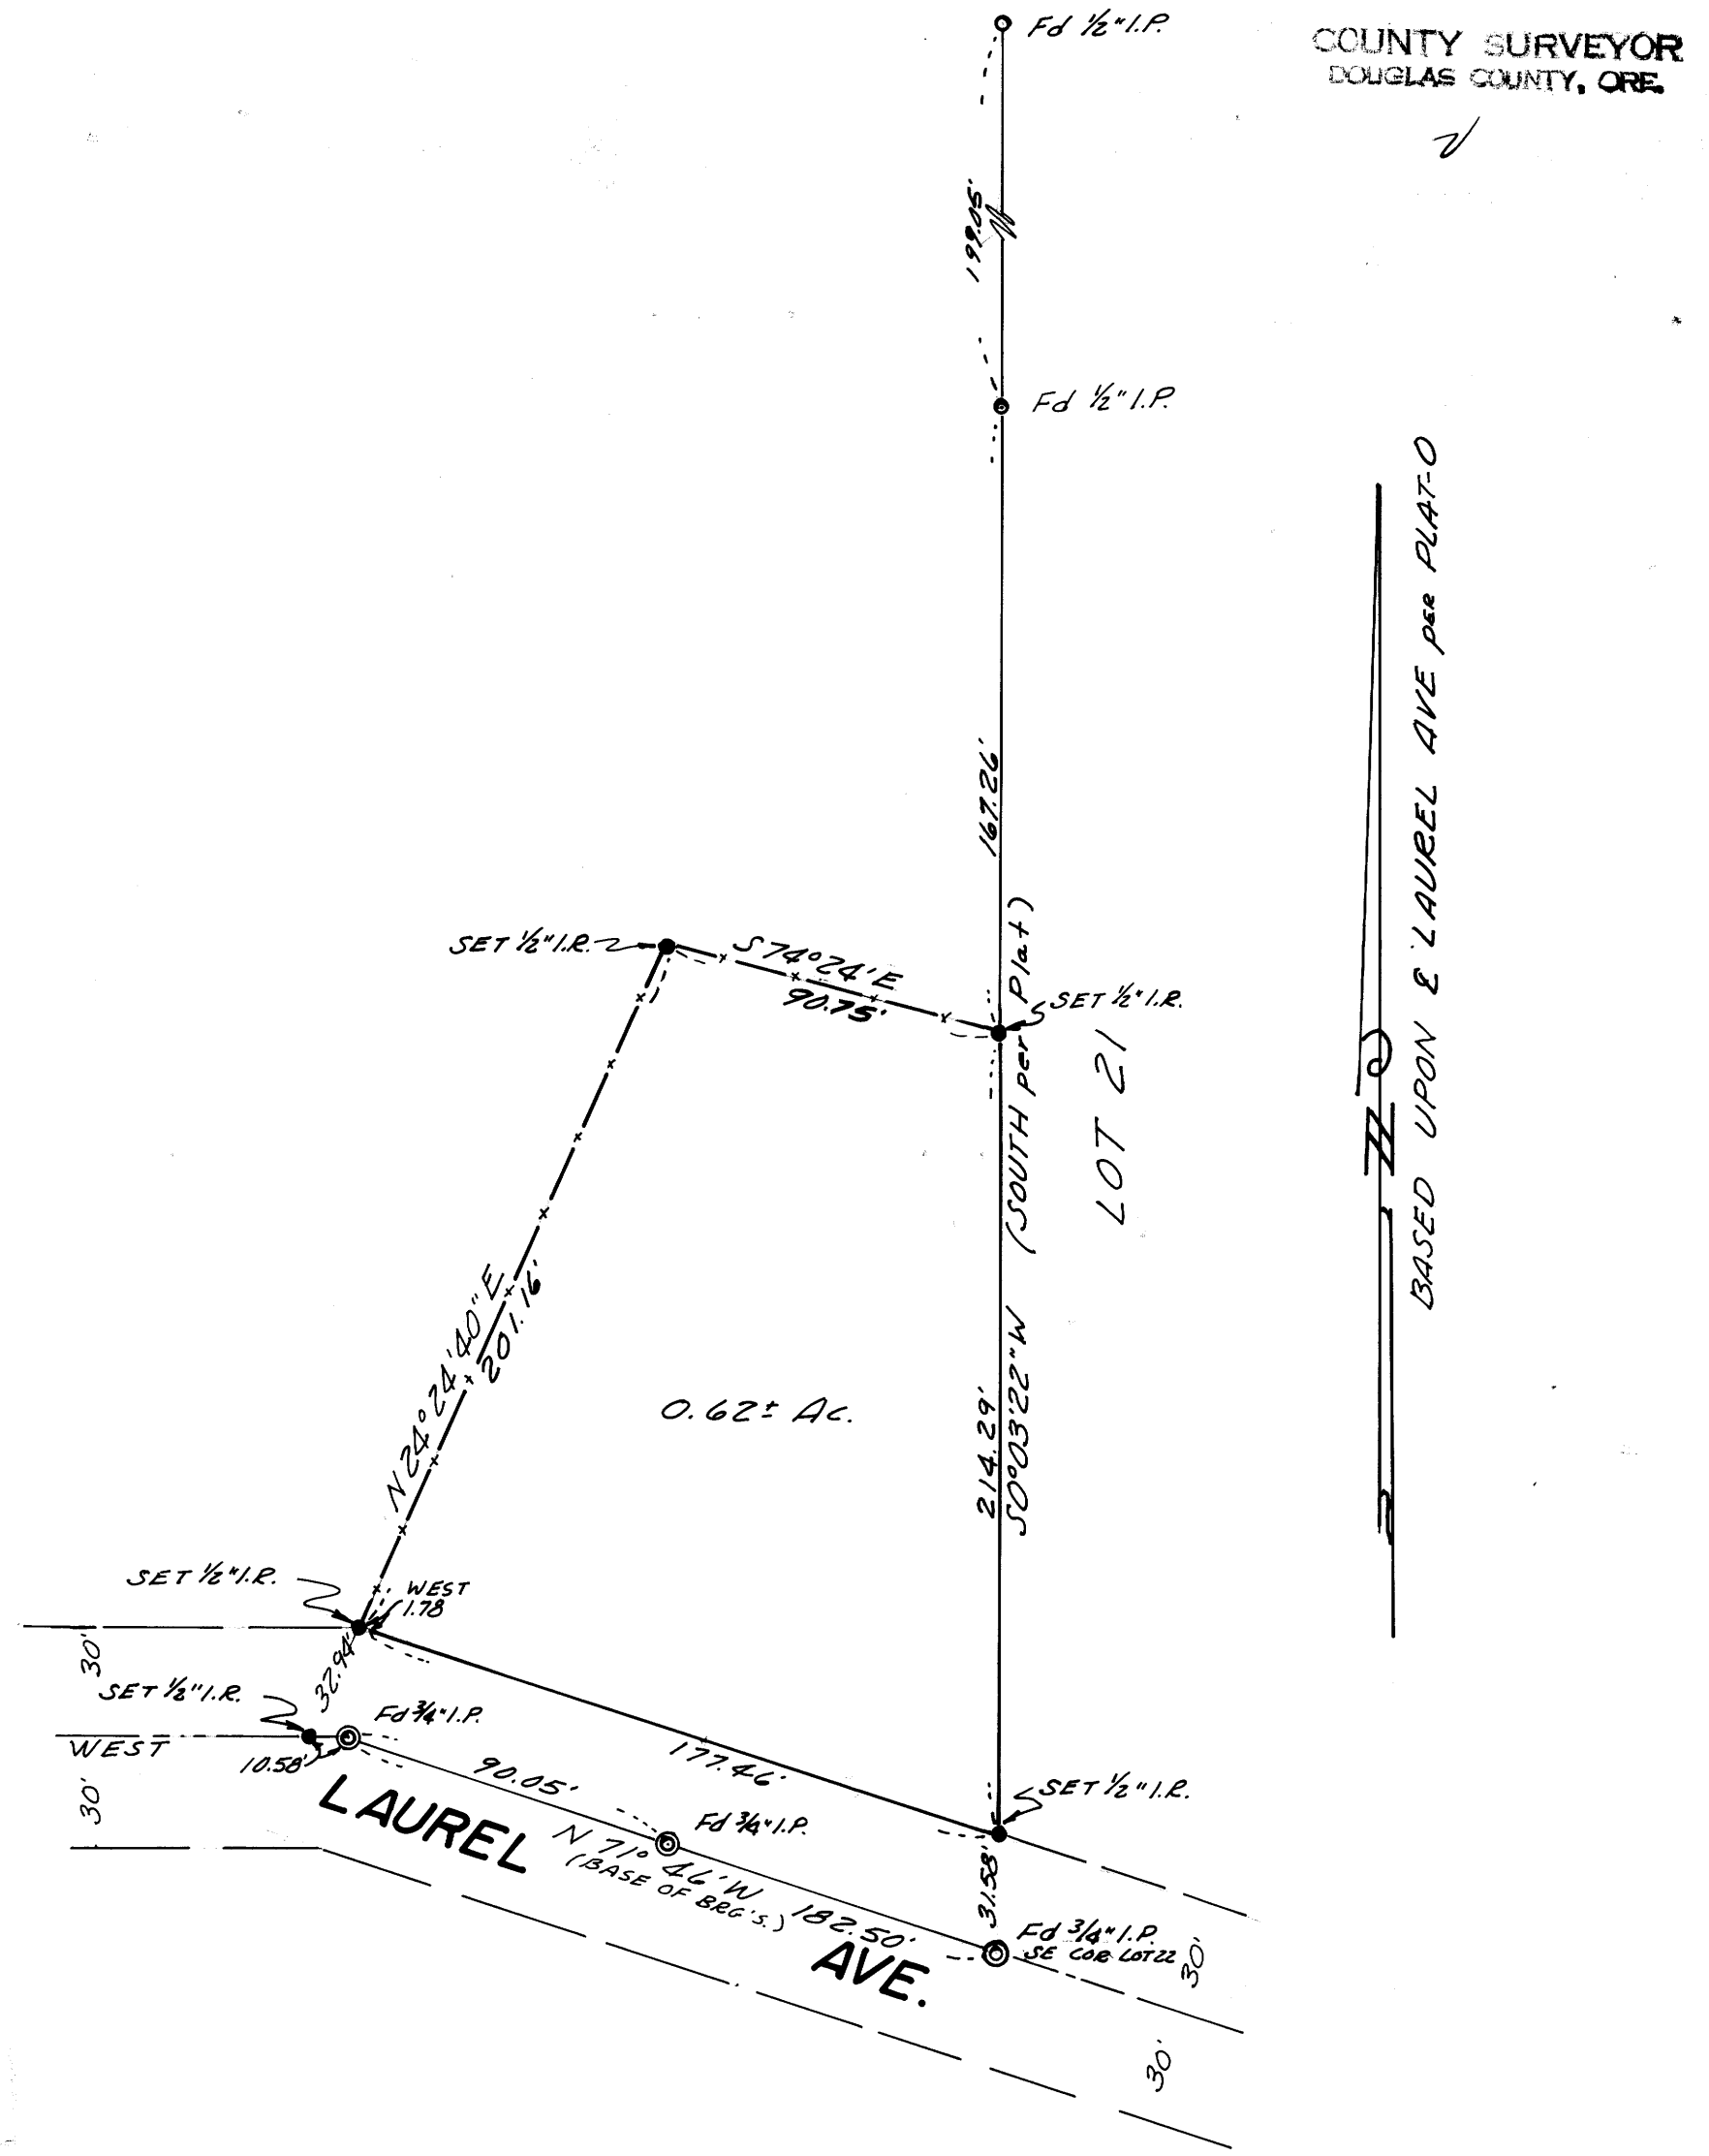

REGISTERED
PROFESSIONAL
LAND SURVEYOR

Eugene A Bloom

OREGON
MAY 18 1960
EUGENE A. BLOOM
392

36355

MAP FILE M 6 Q - 6