COUNTY SURVEYORS FILE DATA
DO NOT REMOVE FROM OFFICE

FILED
RECEIVED
JUL 1 1976
COUNTY SURVEYOR
DOUGLAS COUNTY, ORE.

M 60 - 60

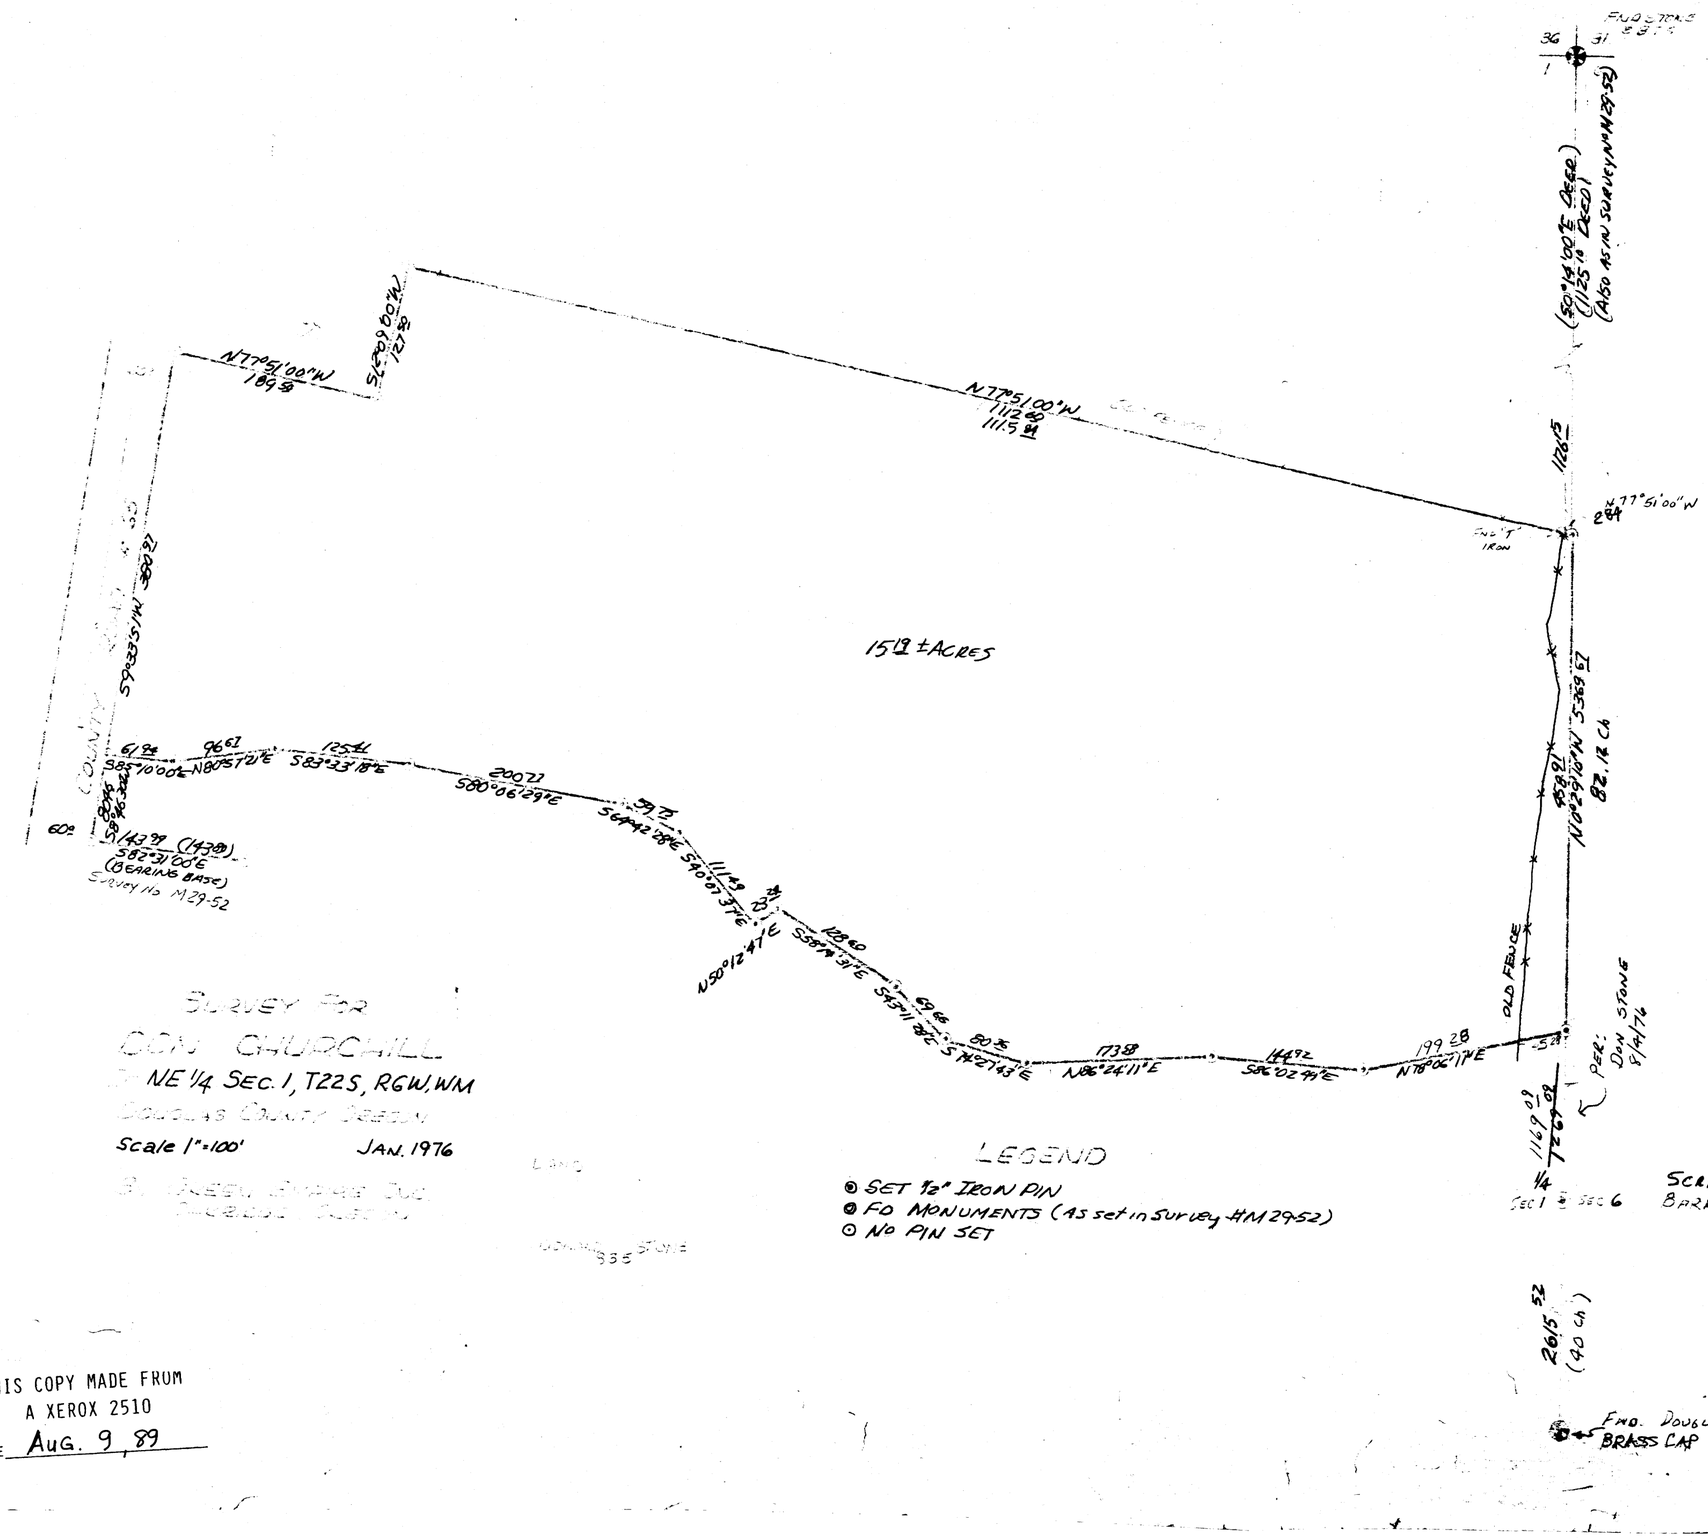

THIS COPY MADE FROM
A XEROX 2510
DATE Aug. 9, 89

60 - 60