MAP FILE M64-7

COUNTY SURVEYORS FILE DATA
DO NOT REMOVE FROM OFFICE

FILED
RECEIVED
JUL 19
COUNTY SURVEYOR
DOUGLAS COUNTY, ORE.

SURVEY IN D.L.C. NO. 40

IN SEC.S 17 & 20, T 24 S., R 4 W. W.M.

SURVEYED FOR - LEONARD BRECK MAY 1976
SURVEYED BY - W.S. BARNES

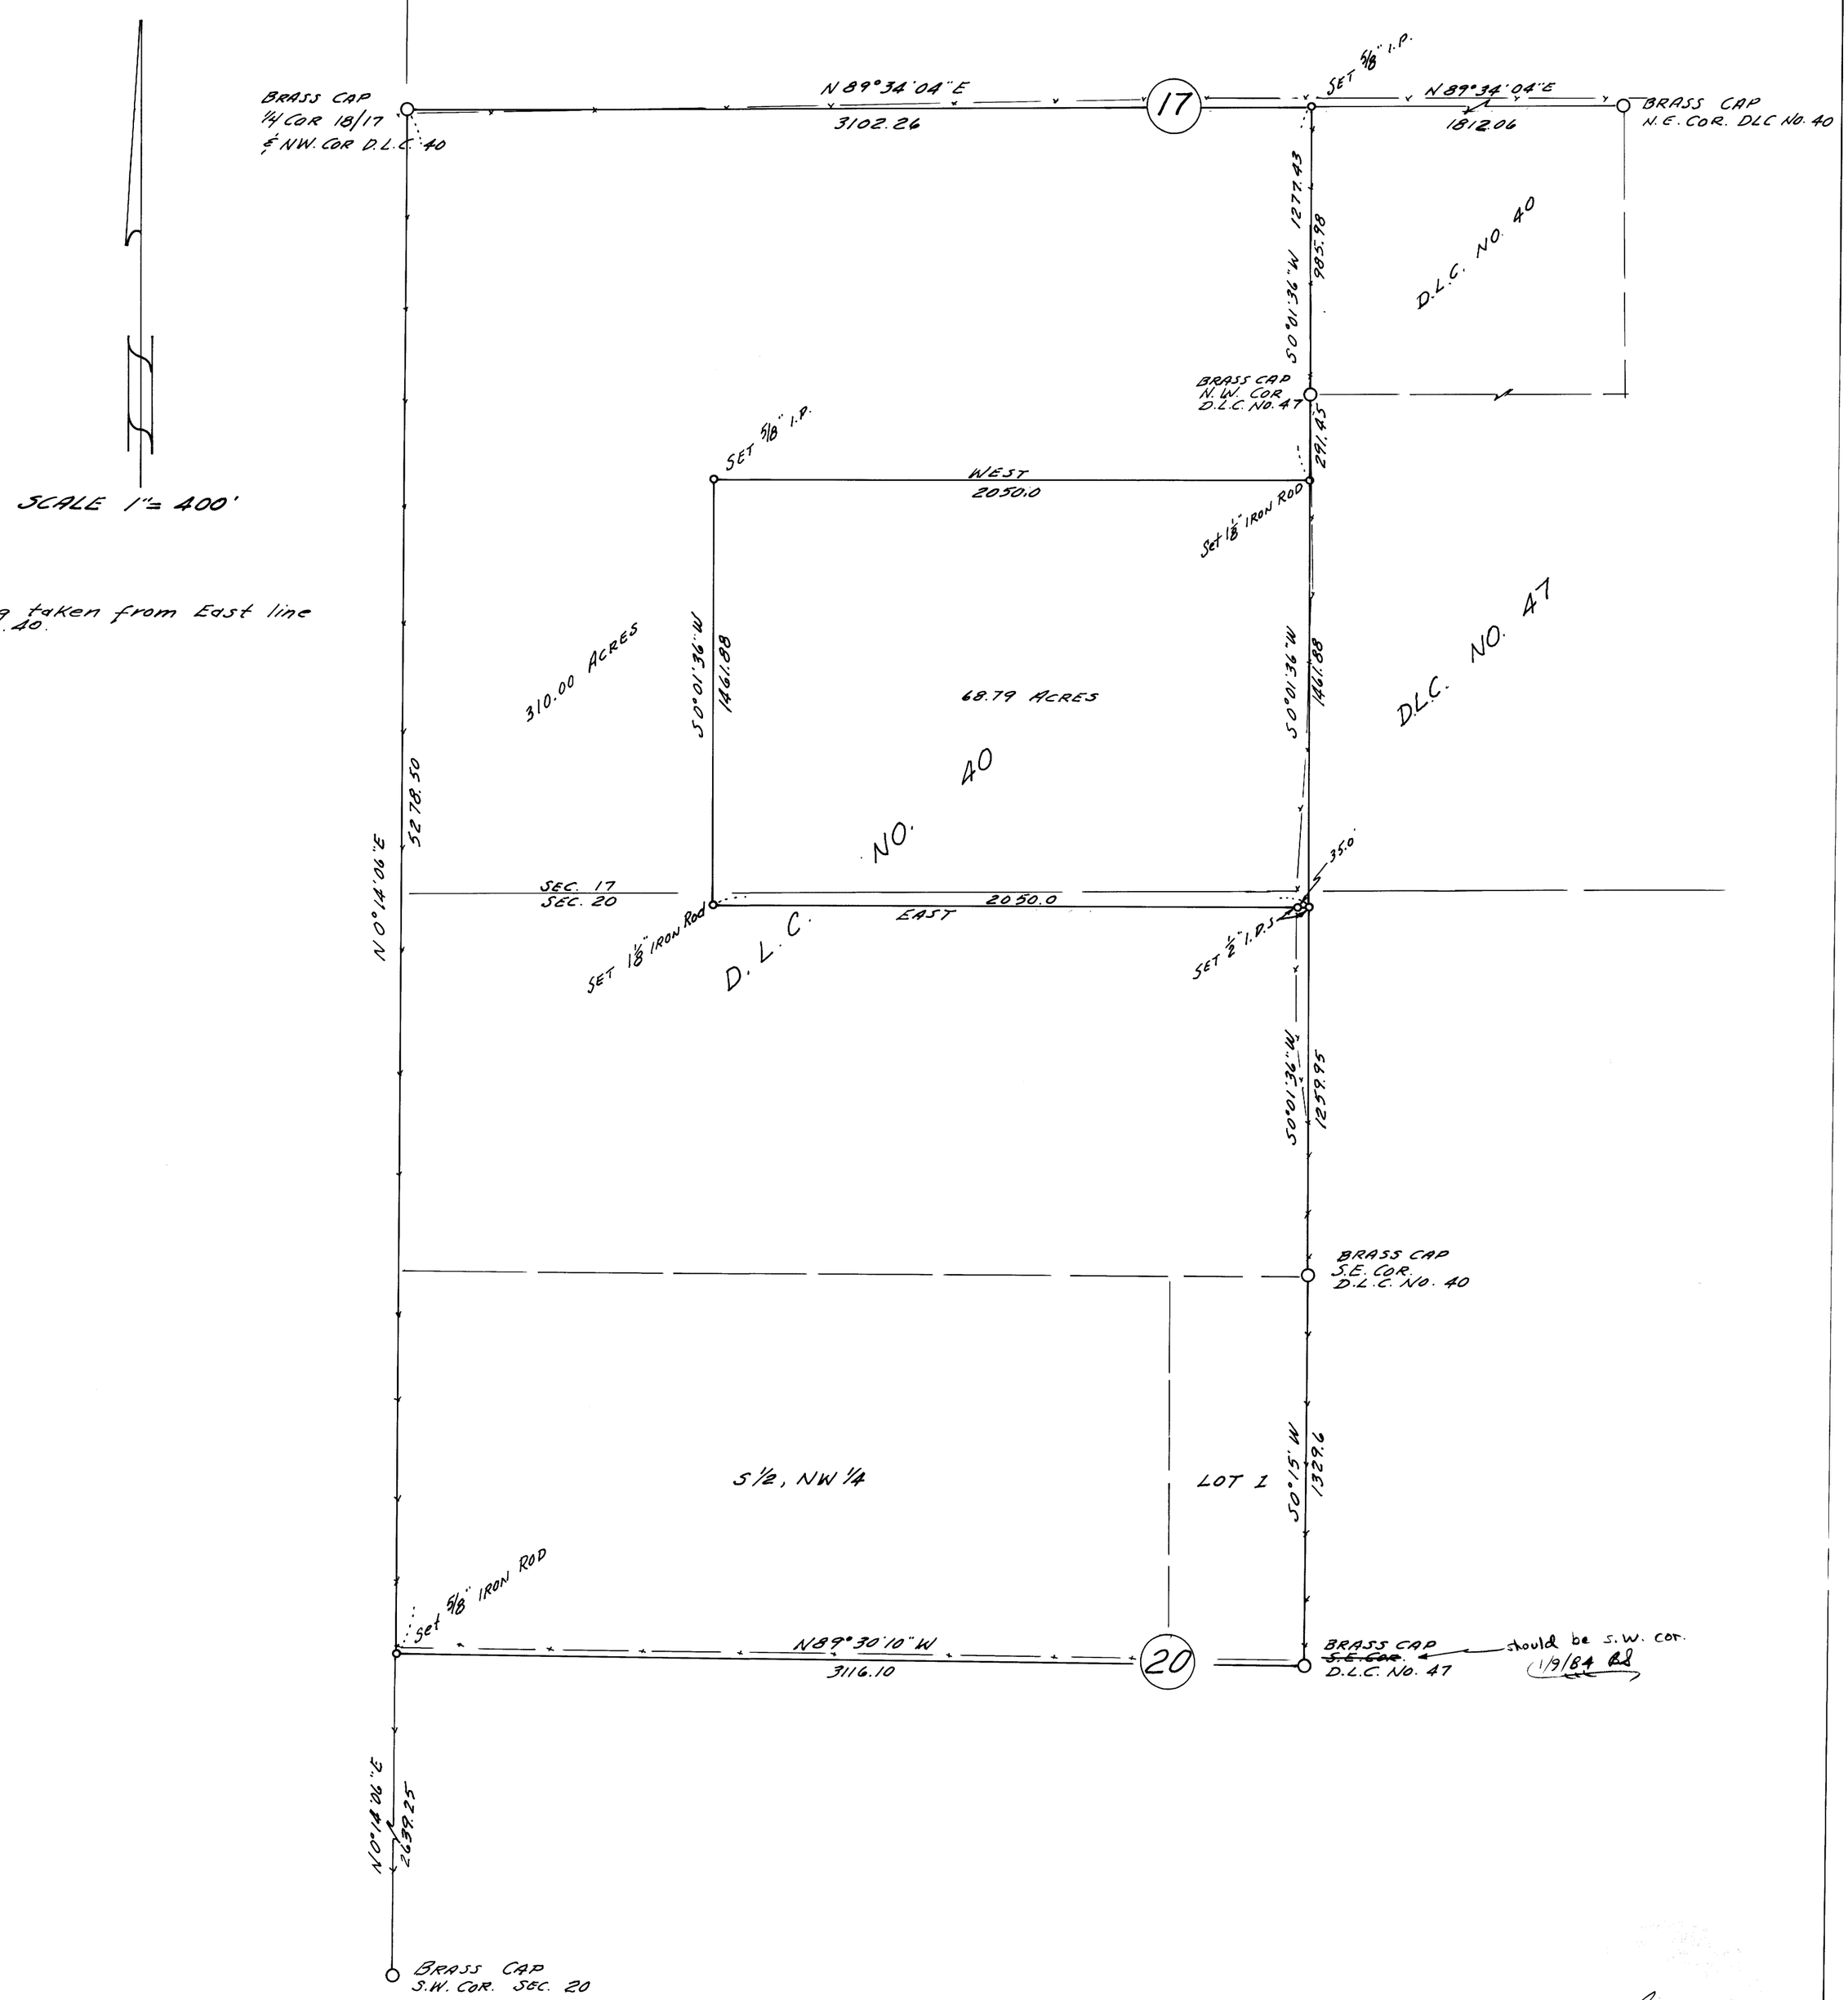

W. S. Barnes

MAP FILE M64-1