FILED
RECEIVED
APR 20 1976
COUNTY SURVEYOR
DOUGLAS COUNTY, ORE.
MAP FILE M61-2

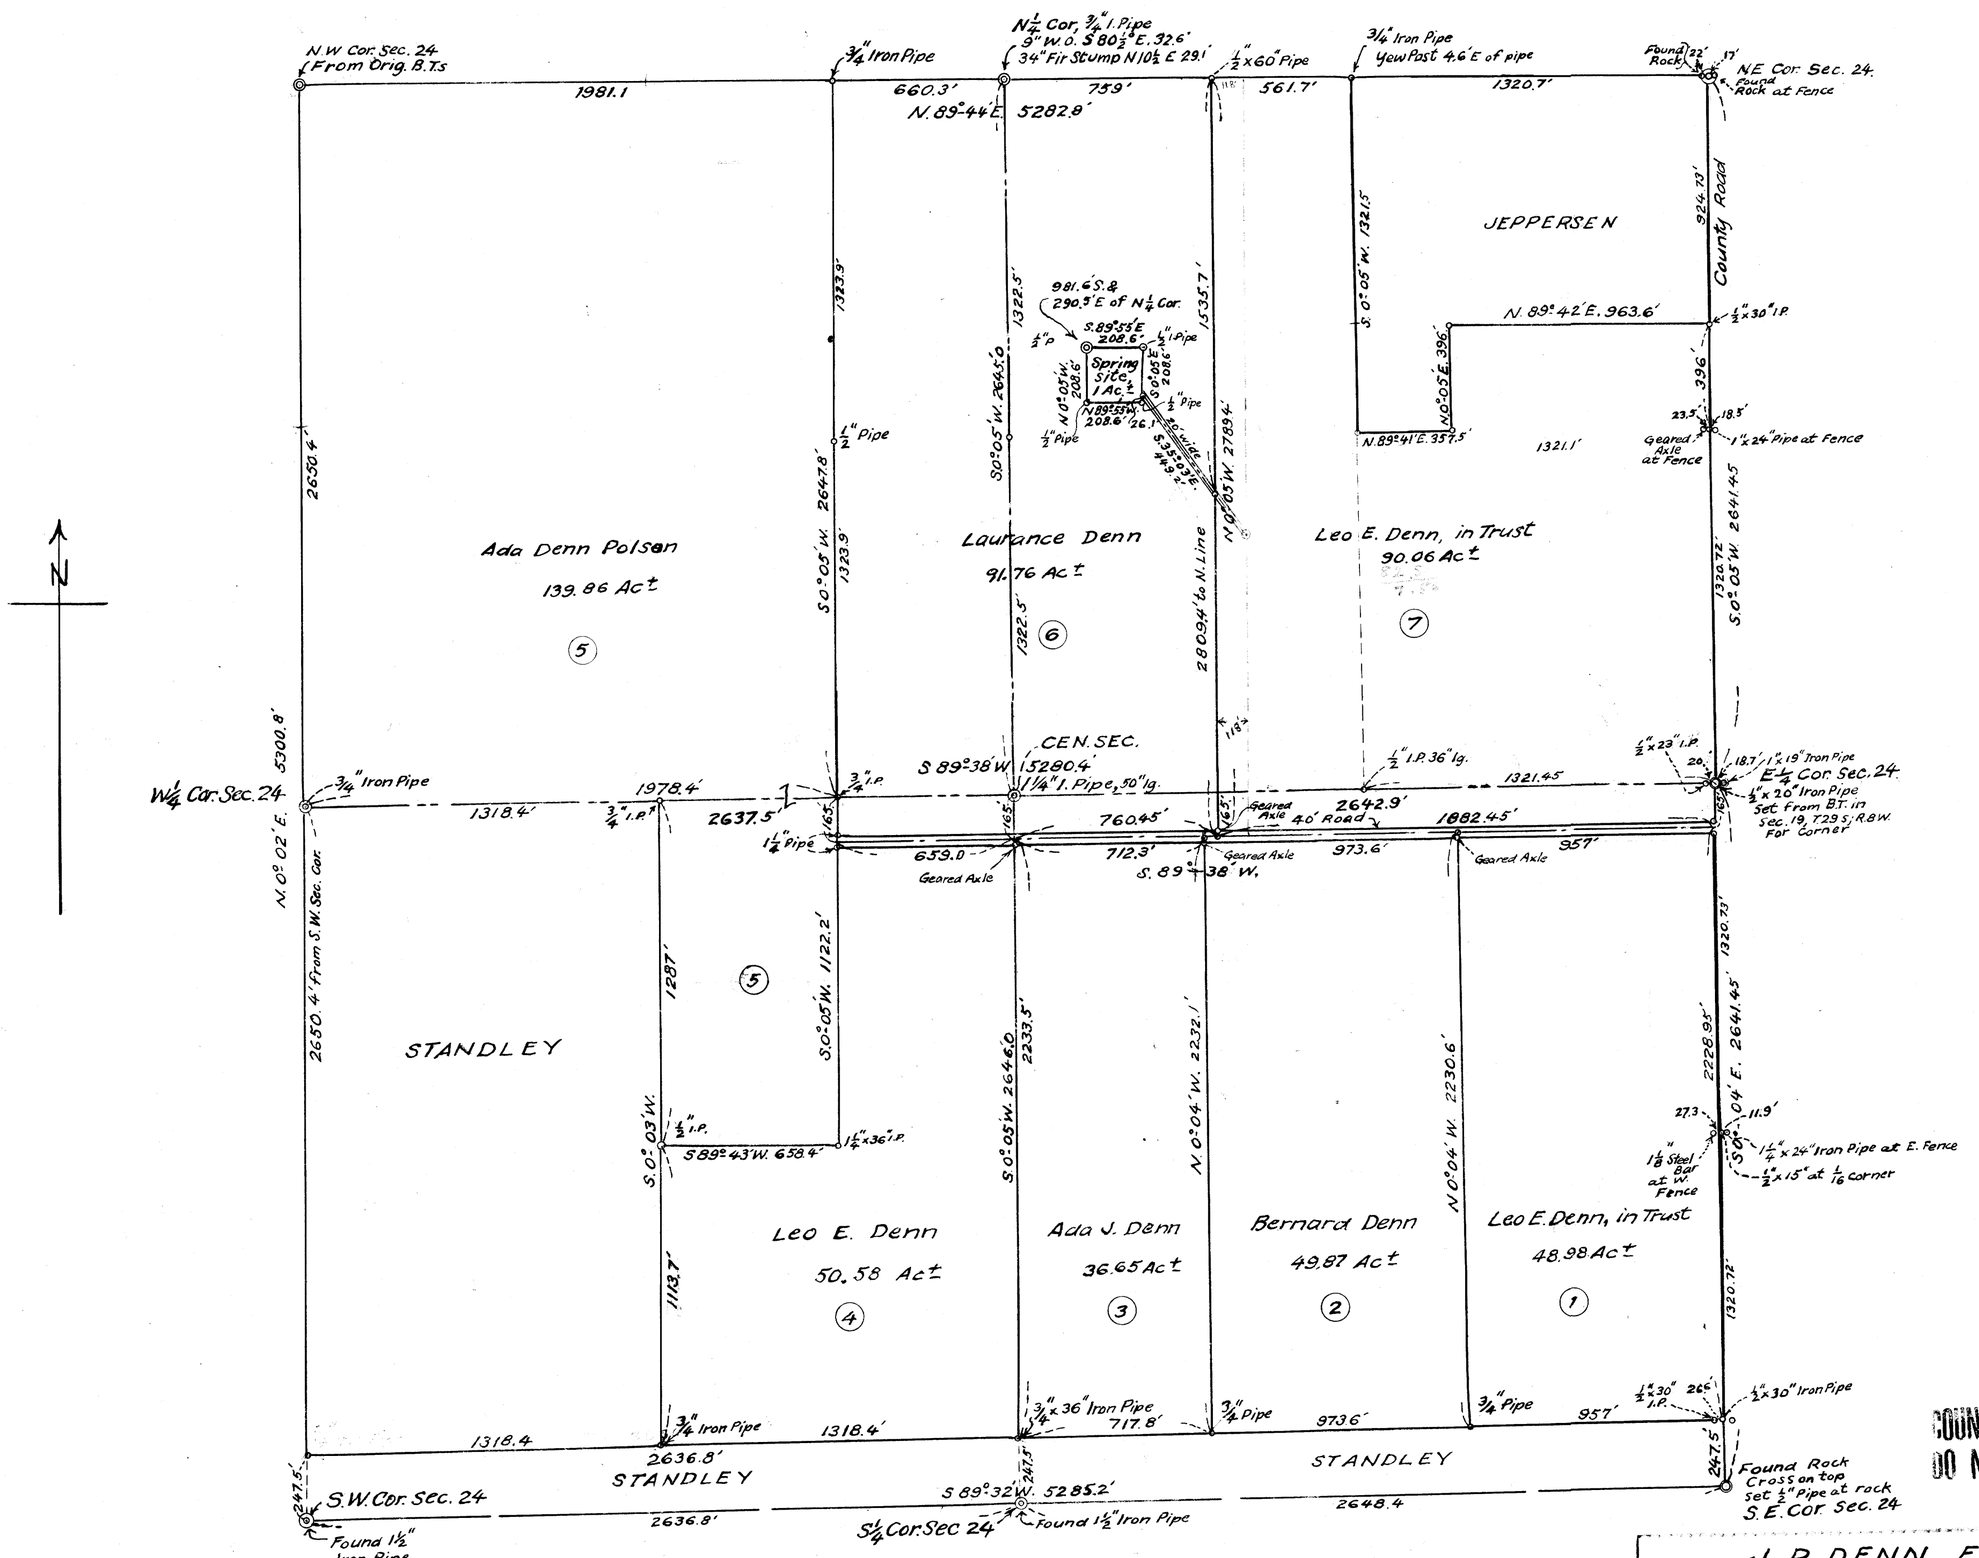

COUNTY SURVEYORS FILE DATA
DO NOT REMOVE FROM OFFICE

J. P. DENN ESTATE
CAMAS VALLEY, ORE.
SEC. 24, T.29 S., R.9 W., WIL. MER.
DOUGLAS COUNTY, ORE.
FEB. 1955 D. Boyer. 1" = 400'

MAP FILE M61-2