COUNTY SURVEYORS FILE DATA
DO NOT REMOVE FROM OFFICE

FILED
RECEIVED
AUG 16 1976
COUNTY SURVEYOR
DOUGLAS COUNTY, ORE.

SURVEY IN SEC. 30, T24S, R5W. W.M.

SURVEYED BY - W. S. BARNES AUG. 1976
SURVEYED FOR - KEITH PEDERSEN

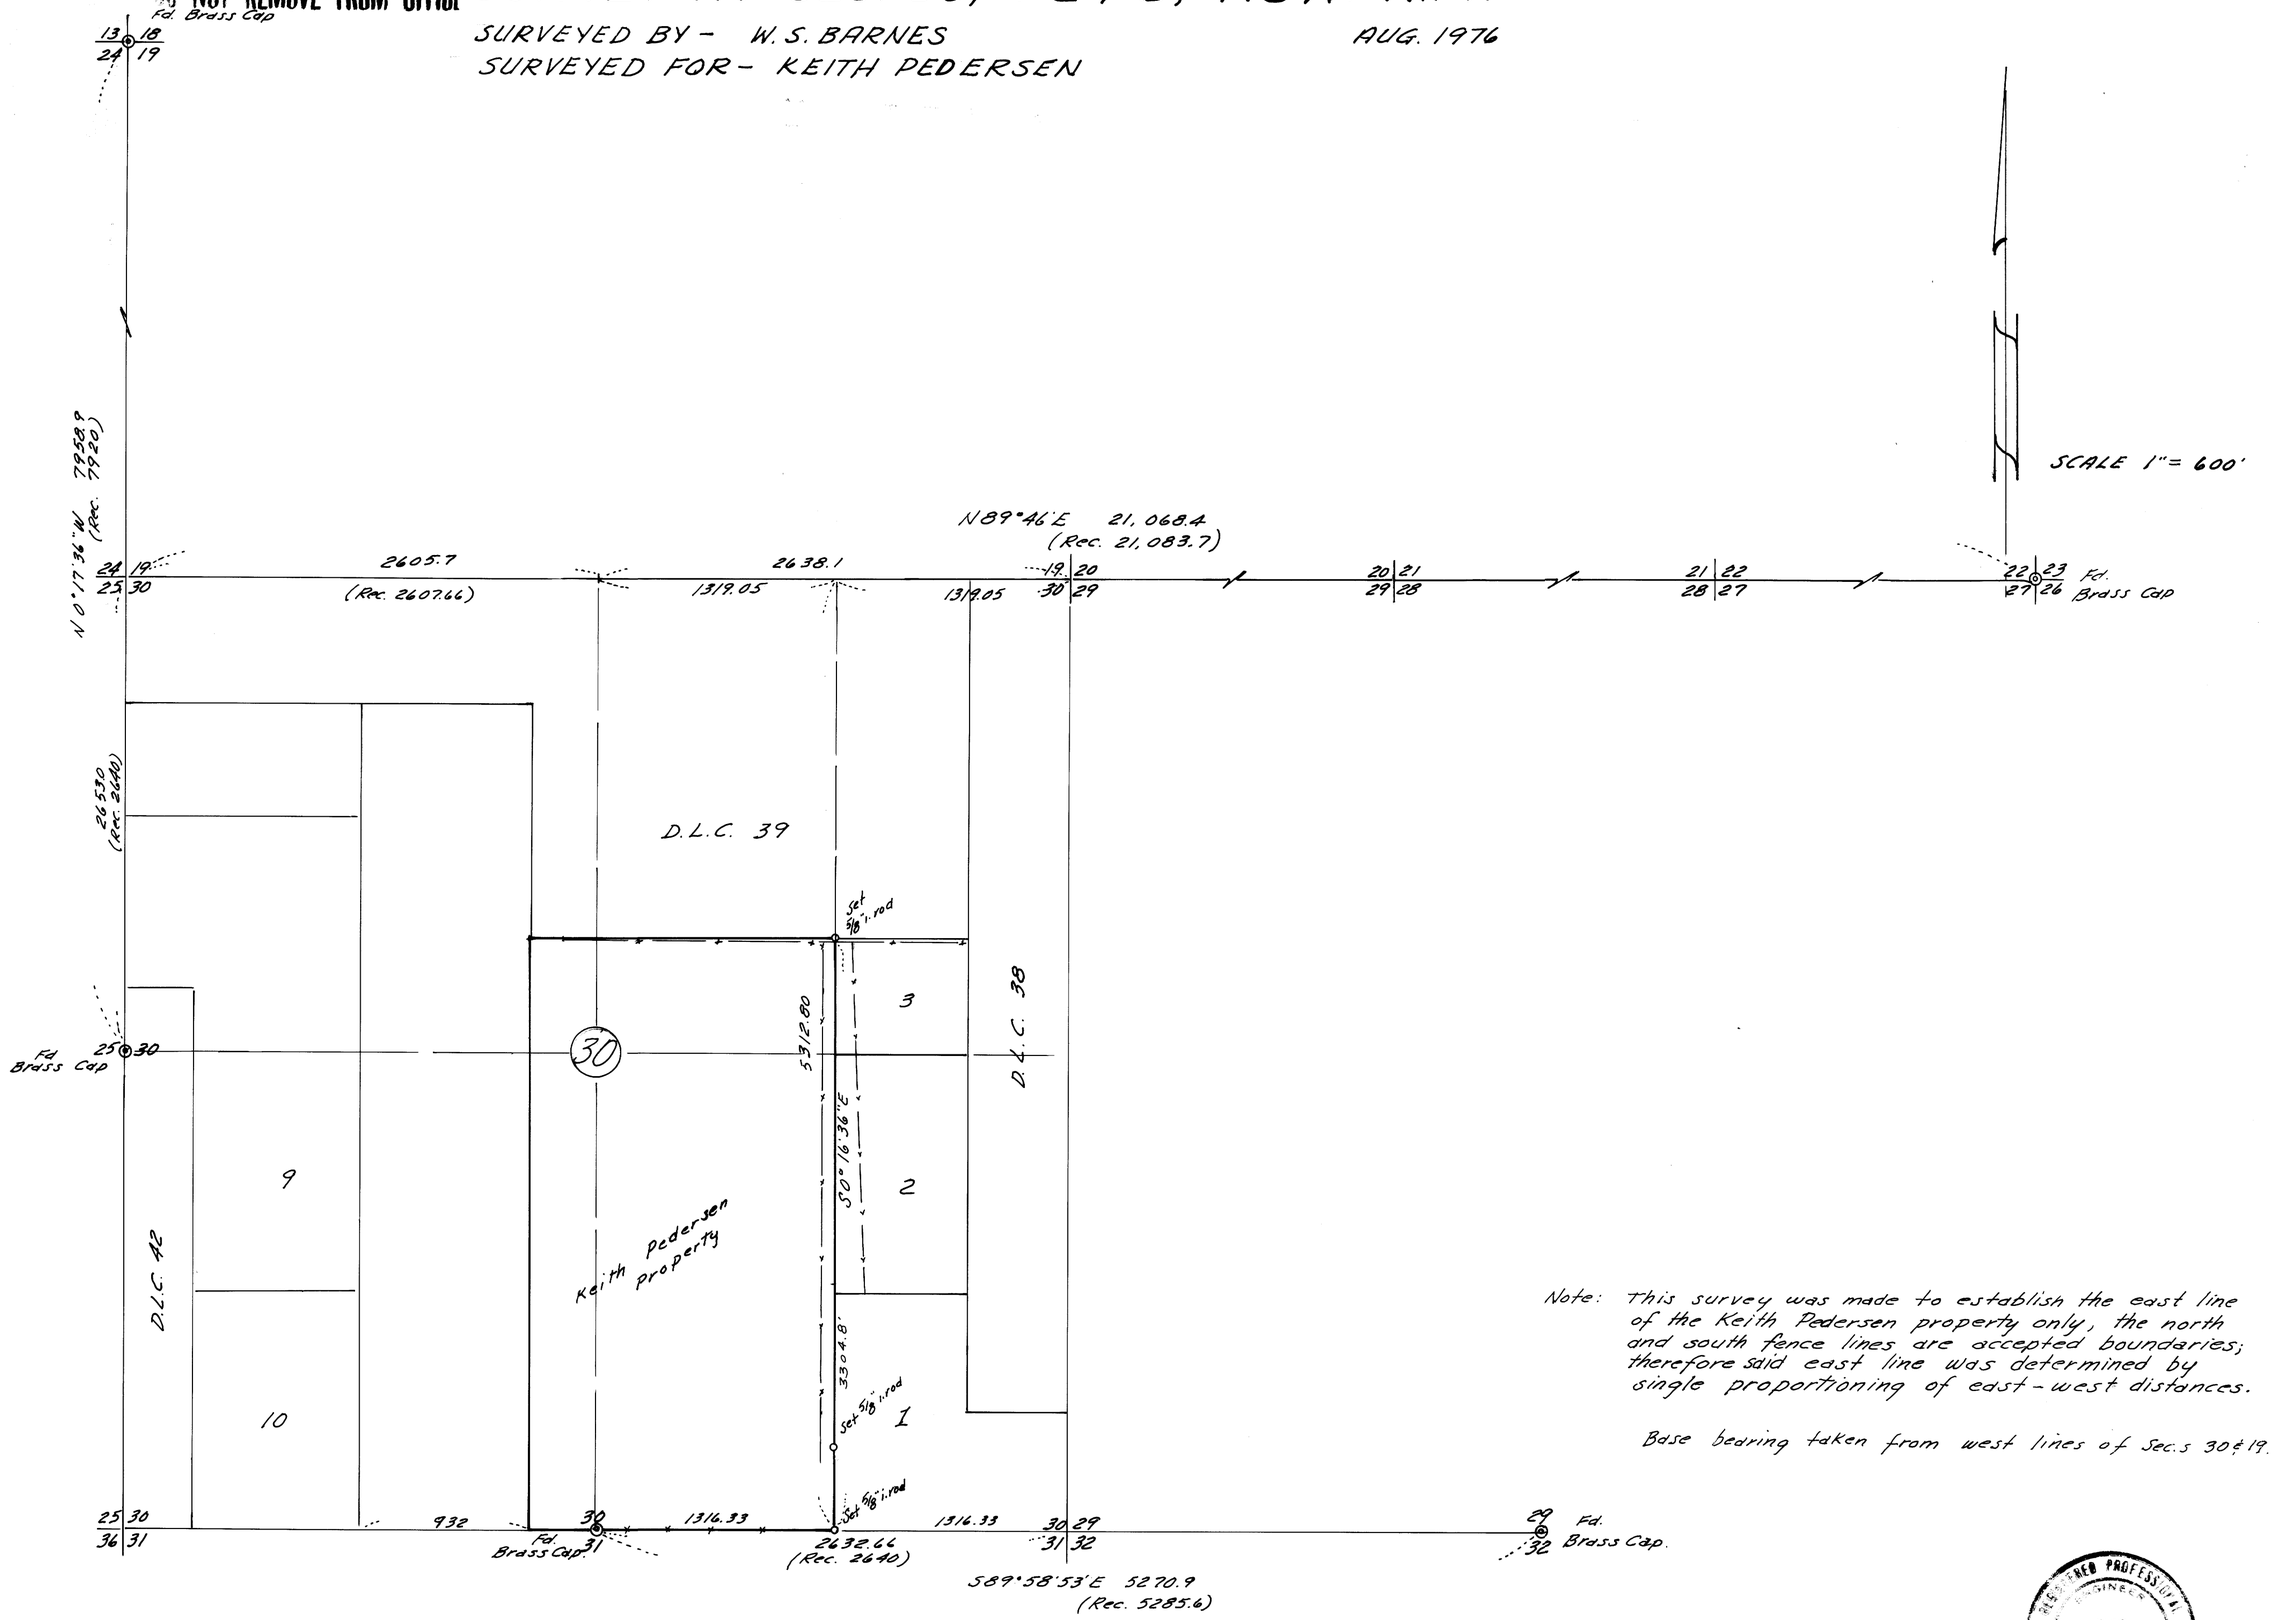

Note: this survey was made to establish the east line of the Keith Pedersen property only, the north and south fence lines are accepted boundaries; therefore said east line was determined by single proportioning of east-west distances.

Base bearing taken from west lines of Sec.s 30 & 19.

MAP FILE M16L-20