MAP FILE M61-31

COUNTY SURVEYORS FILE DATA
DO NOT REMOVE FROM OFFICE

FILED
RECEIVED
AUG 30 1976
COUNTY SURVEYOR
DOUGLAS COUNTY, ORE.

SUBDIVISION OF SECTION 36 T. 20 S., R. 10 W. W.M.

For: International Paper Company
Bearings shown: True-determined from Solar observations.
Monuments found shown: Brass Caps set in the 1951 BLM Survey. ◎
Monuments set shown: 5/8" X 40" Ref. Rods. o
Scale: 1" = 400 ft. Date: August 25, 1976.
Note: The South line of N½SE¼ was blazed and painted Red and flagged.
The East line of NW¼NW¼ was blazed and painted Red and flagged.
All BTs were Tagged with International Paper Co. tags showing bearing and dist. to Corner.
The map below is the result of a closed traverse transit & tape survey.

REGISTERED
OREGON
LAND SURVEYOR
OCTOBER 24, 1966
FORREST T. HALES
453

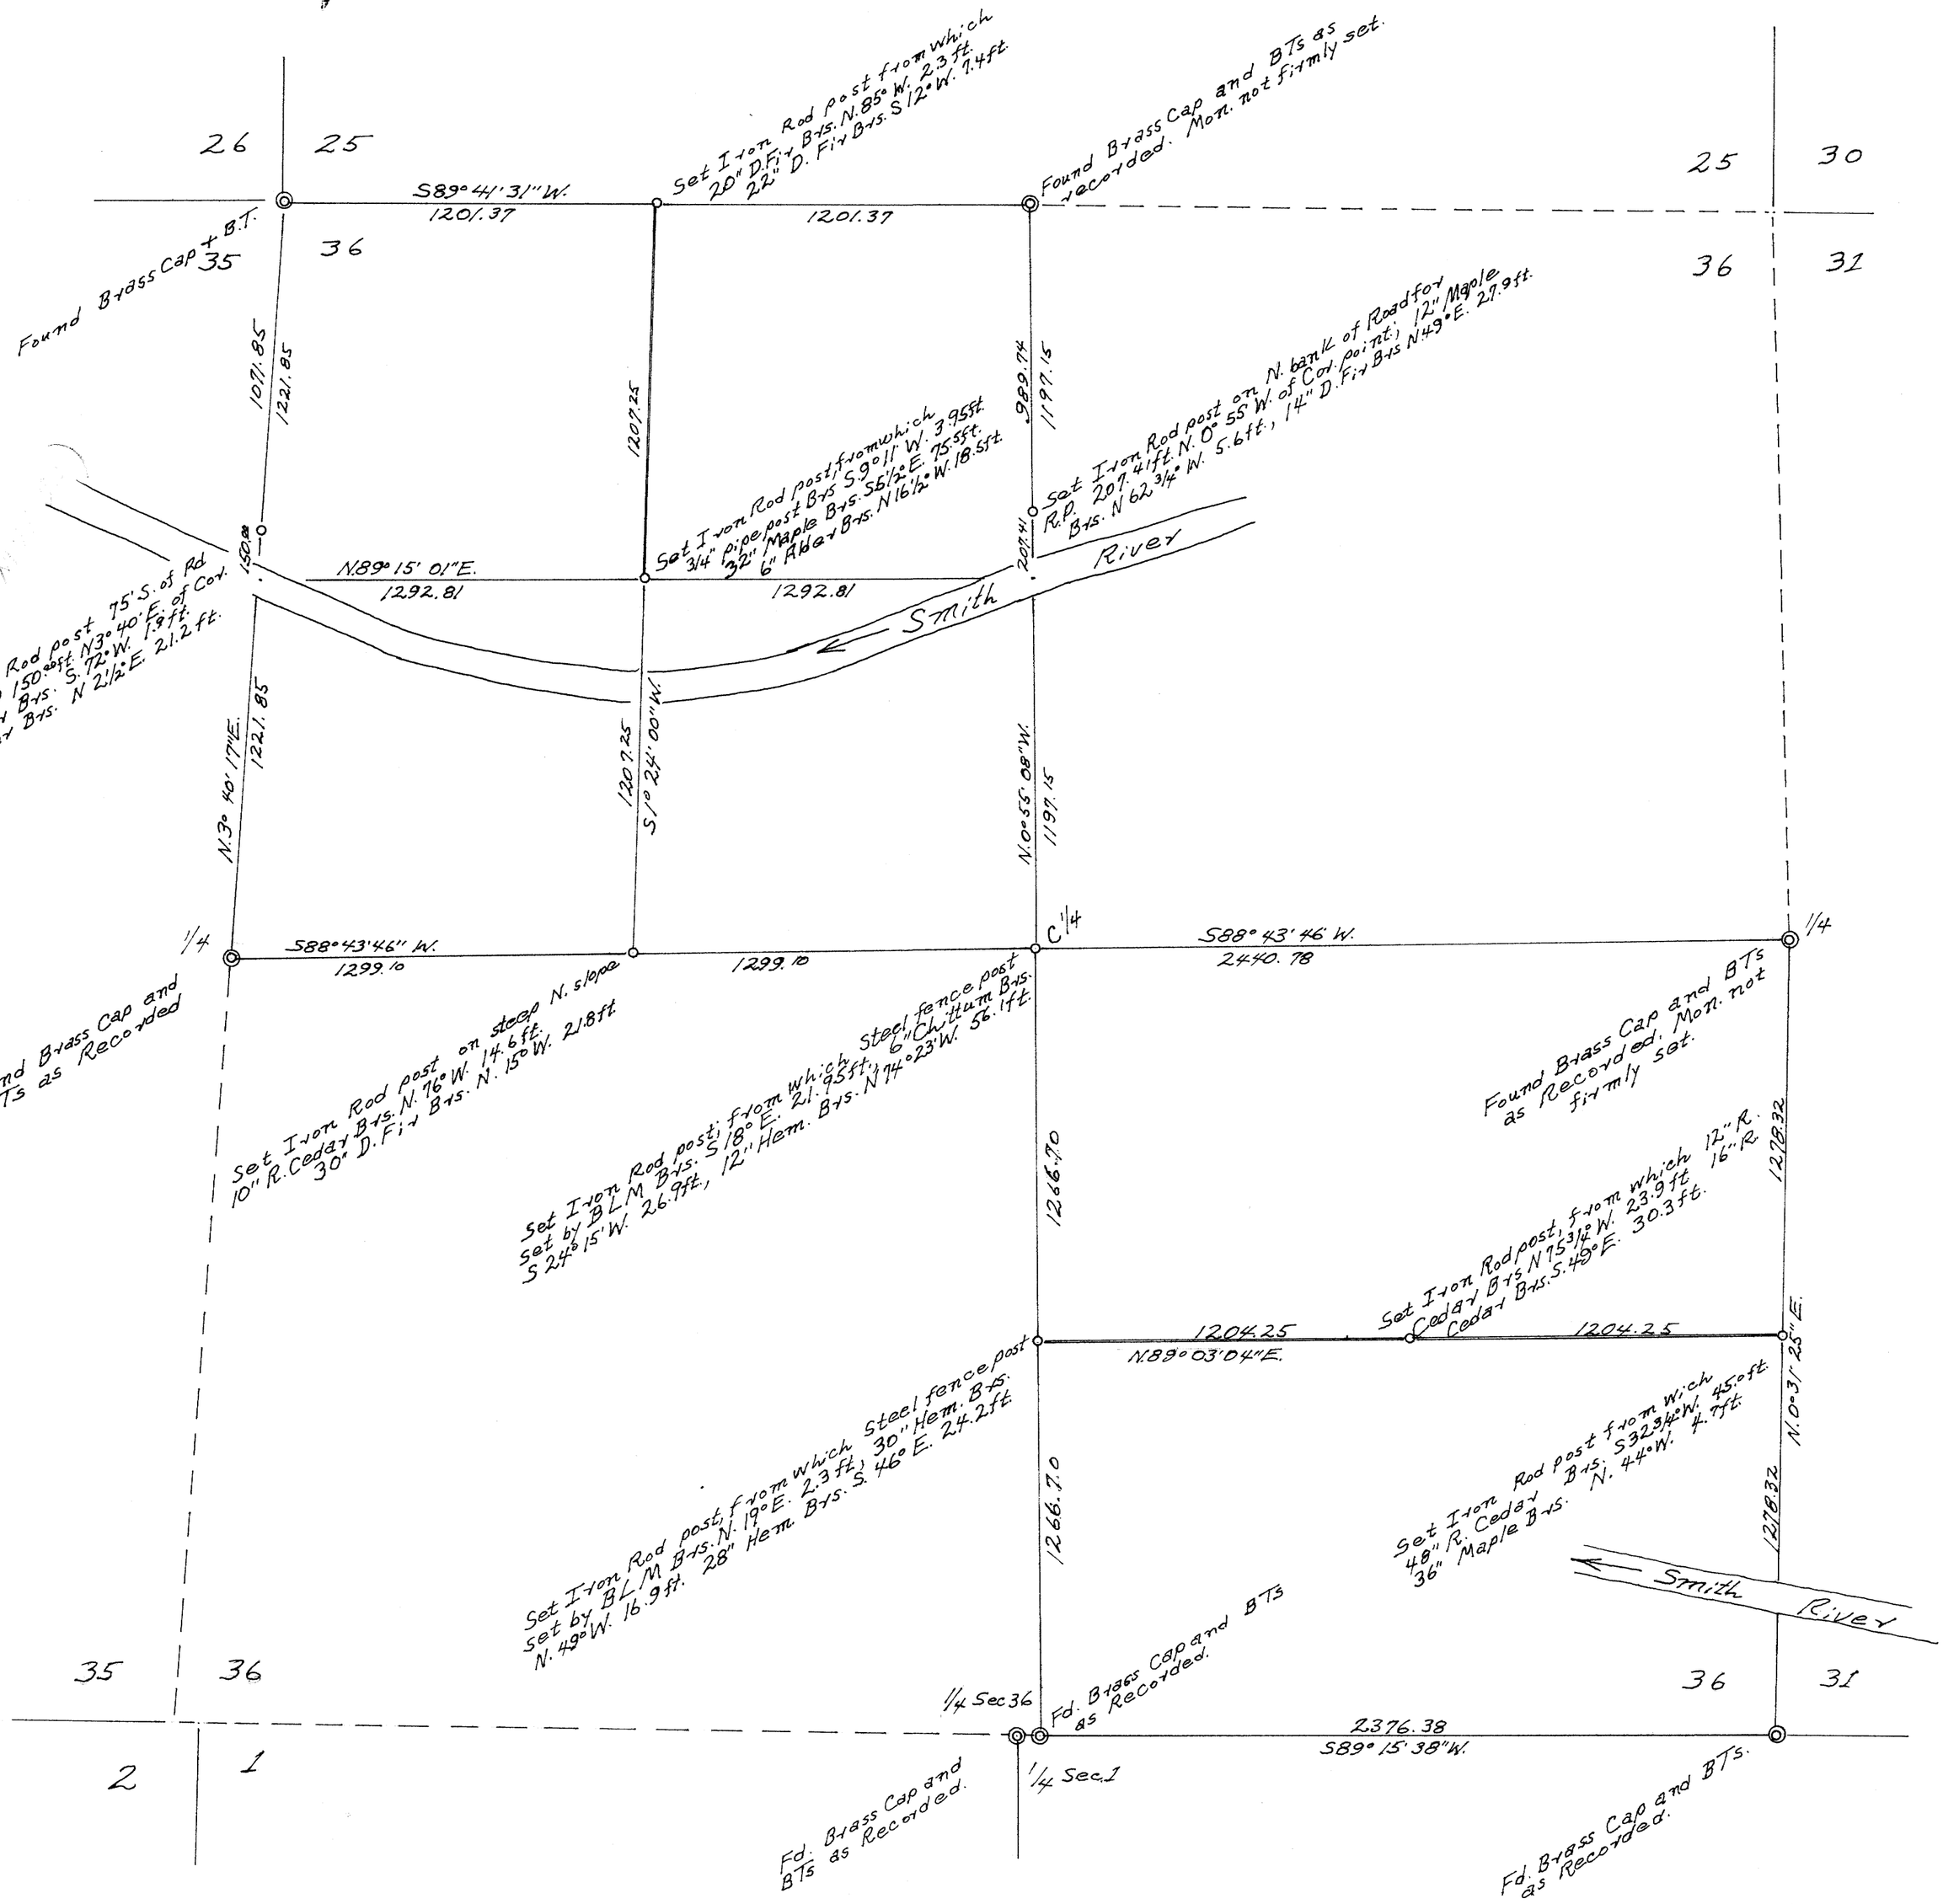

MAP FILE M61-31