COUNTY SURVEYORS FILE
DO NOT REMOVE FROM OFFICE

FILED
RECEIVED
AUG 28 1976
COUNTY SURVEYOR
DOUGLAS COUNTY, ORE.

MAP FILE M 61-32

SURVEY OF PARCEL IN BLOCK 2, AMENDED PLAT OF DIXONS ADDITION TO FRUITVALE, IN SEC. 12, T. 27 S., R. 6 W., W.M. DOUGLAS CO., ORE. FOR L. J. HEWITT ESTATE Mrs E.S. BOOTH, N.W. GARDEN VALLEY RD., ROSEBURG, ORE.

BY HERBERT L. NORTHCRAFT SCALE 1" = 60' AUG. 1976

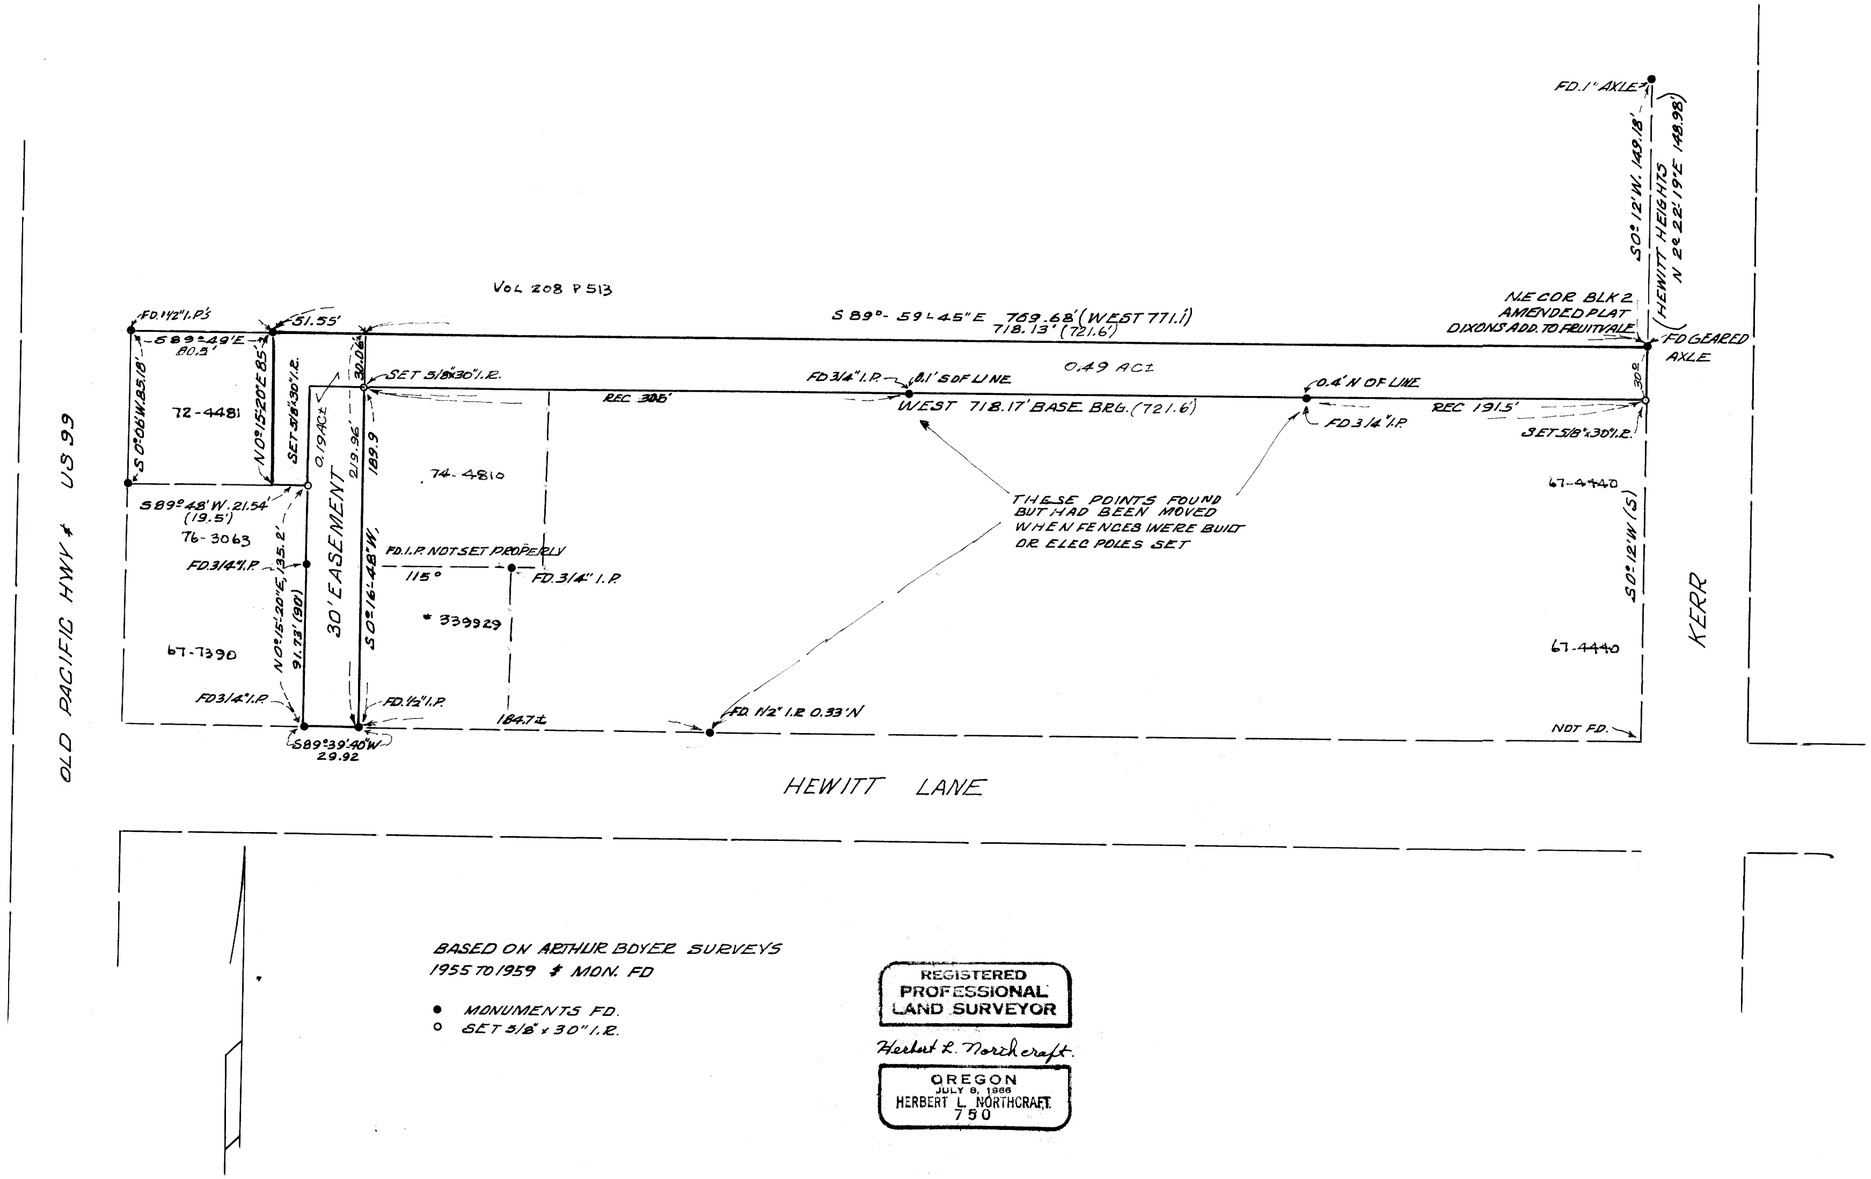

BASED ON ARTHUR BOYER SURVEYS 1955 TO 1959 & MON. FD

- ● MONUMENTS FD.
- ○ SET 5/8" x 30" I.R.

REGISTERED PROFESSIONAL LAND SURVEYOR

Herbert L. Northcraft

OREGON
JULY 8, 1966
HERBERT L. NORTHCRAFT
750

MAP FILE M 61-32