MAP FILE M61-4

COUNTY SURVEYORS FILE DATA
DO NOT REMOVE FROM OFFICE

COUNTY SURVEYOR
DOUGLAS COUNTY, ORE.

SURVEY FOR LEGAL DESCRIPTION
IN BL. 3, MARION ACRES, WINSTON, ORE., SEC. 21, T28S, R6W, W.M.

Surveyed for Dr. M.L. Fletcher by Victor M. McLind

July 21, 1976 Scale: 1" = 100'

● ~ Indicates found 3/4" Iron Rod, unless otherwise noted

○ ~ Indicates Set 5/8" x 30" Iron Rod

Note: This map replaces M60-43

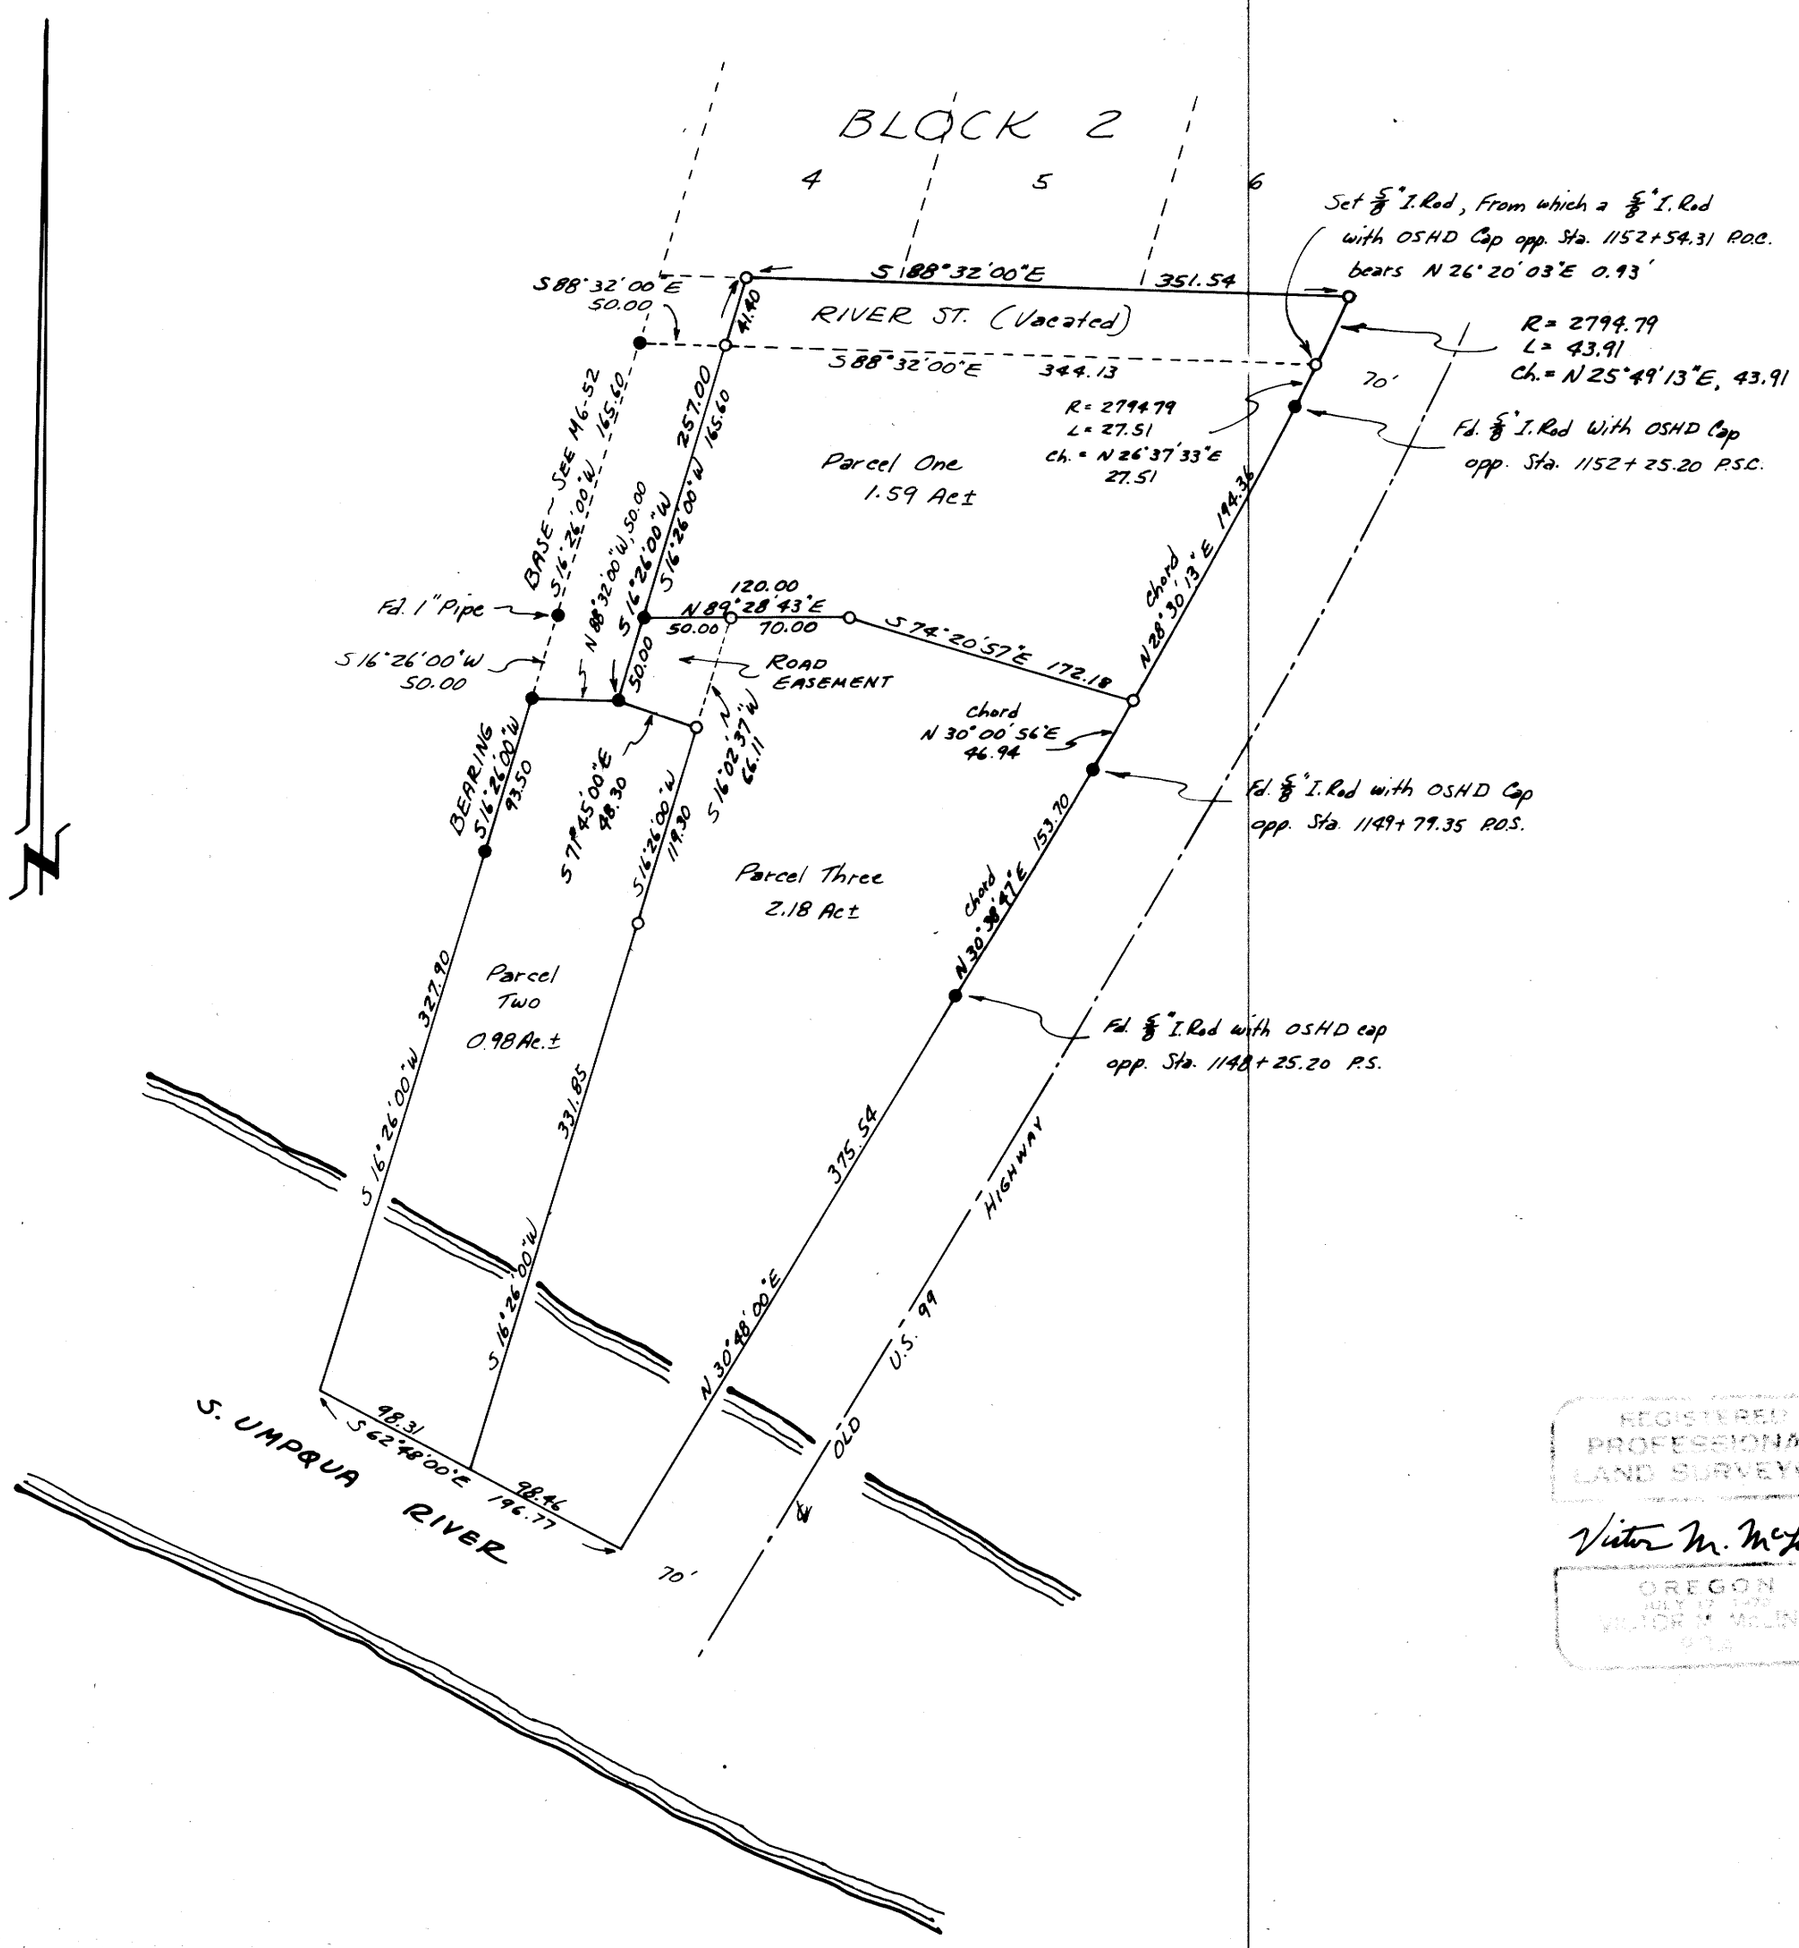

REGISTERED PROFESSIONAL LAND SURVEYOR

Victor M. McLind

OREGON JULY 17, 1974 VICTOR M. MCLIND 2126

MAP FILE M61-4