MAP FILE M61-51

COUNTY SURVEYORS FILE DATA
DO NOT REMOVE FROM OFFICE

FILED
RECEIVED
SEP 29 1976
COUNTY SURVEYOR
DOUGLAS COUNTY, ORE.

SURVEY IN SEC. 33, T 31 S, R 4 W. W. M.

SURVEYED FOR – WALLIS SCOTT
SURVEYED BY – W. S. BARNES

SEPT. 1976

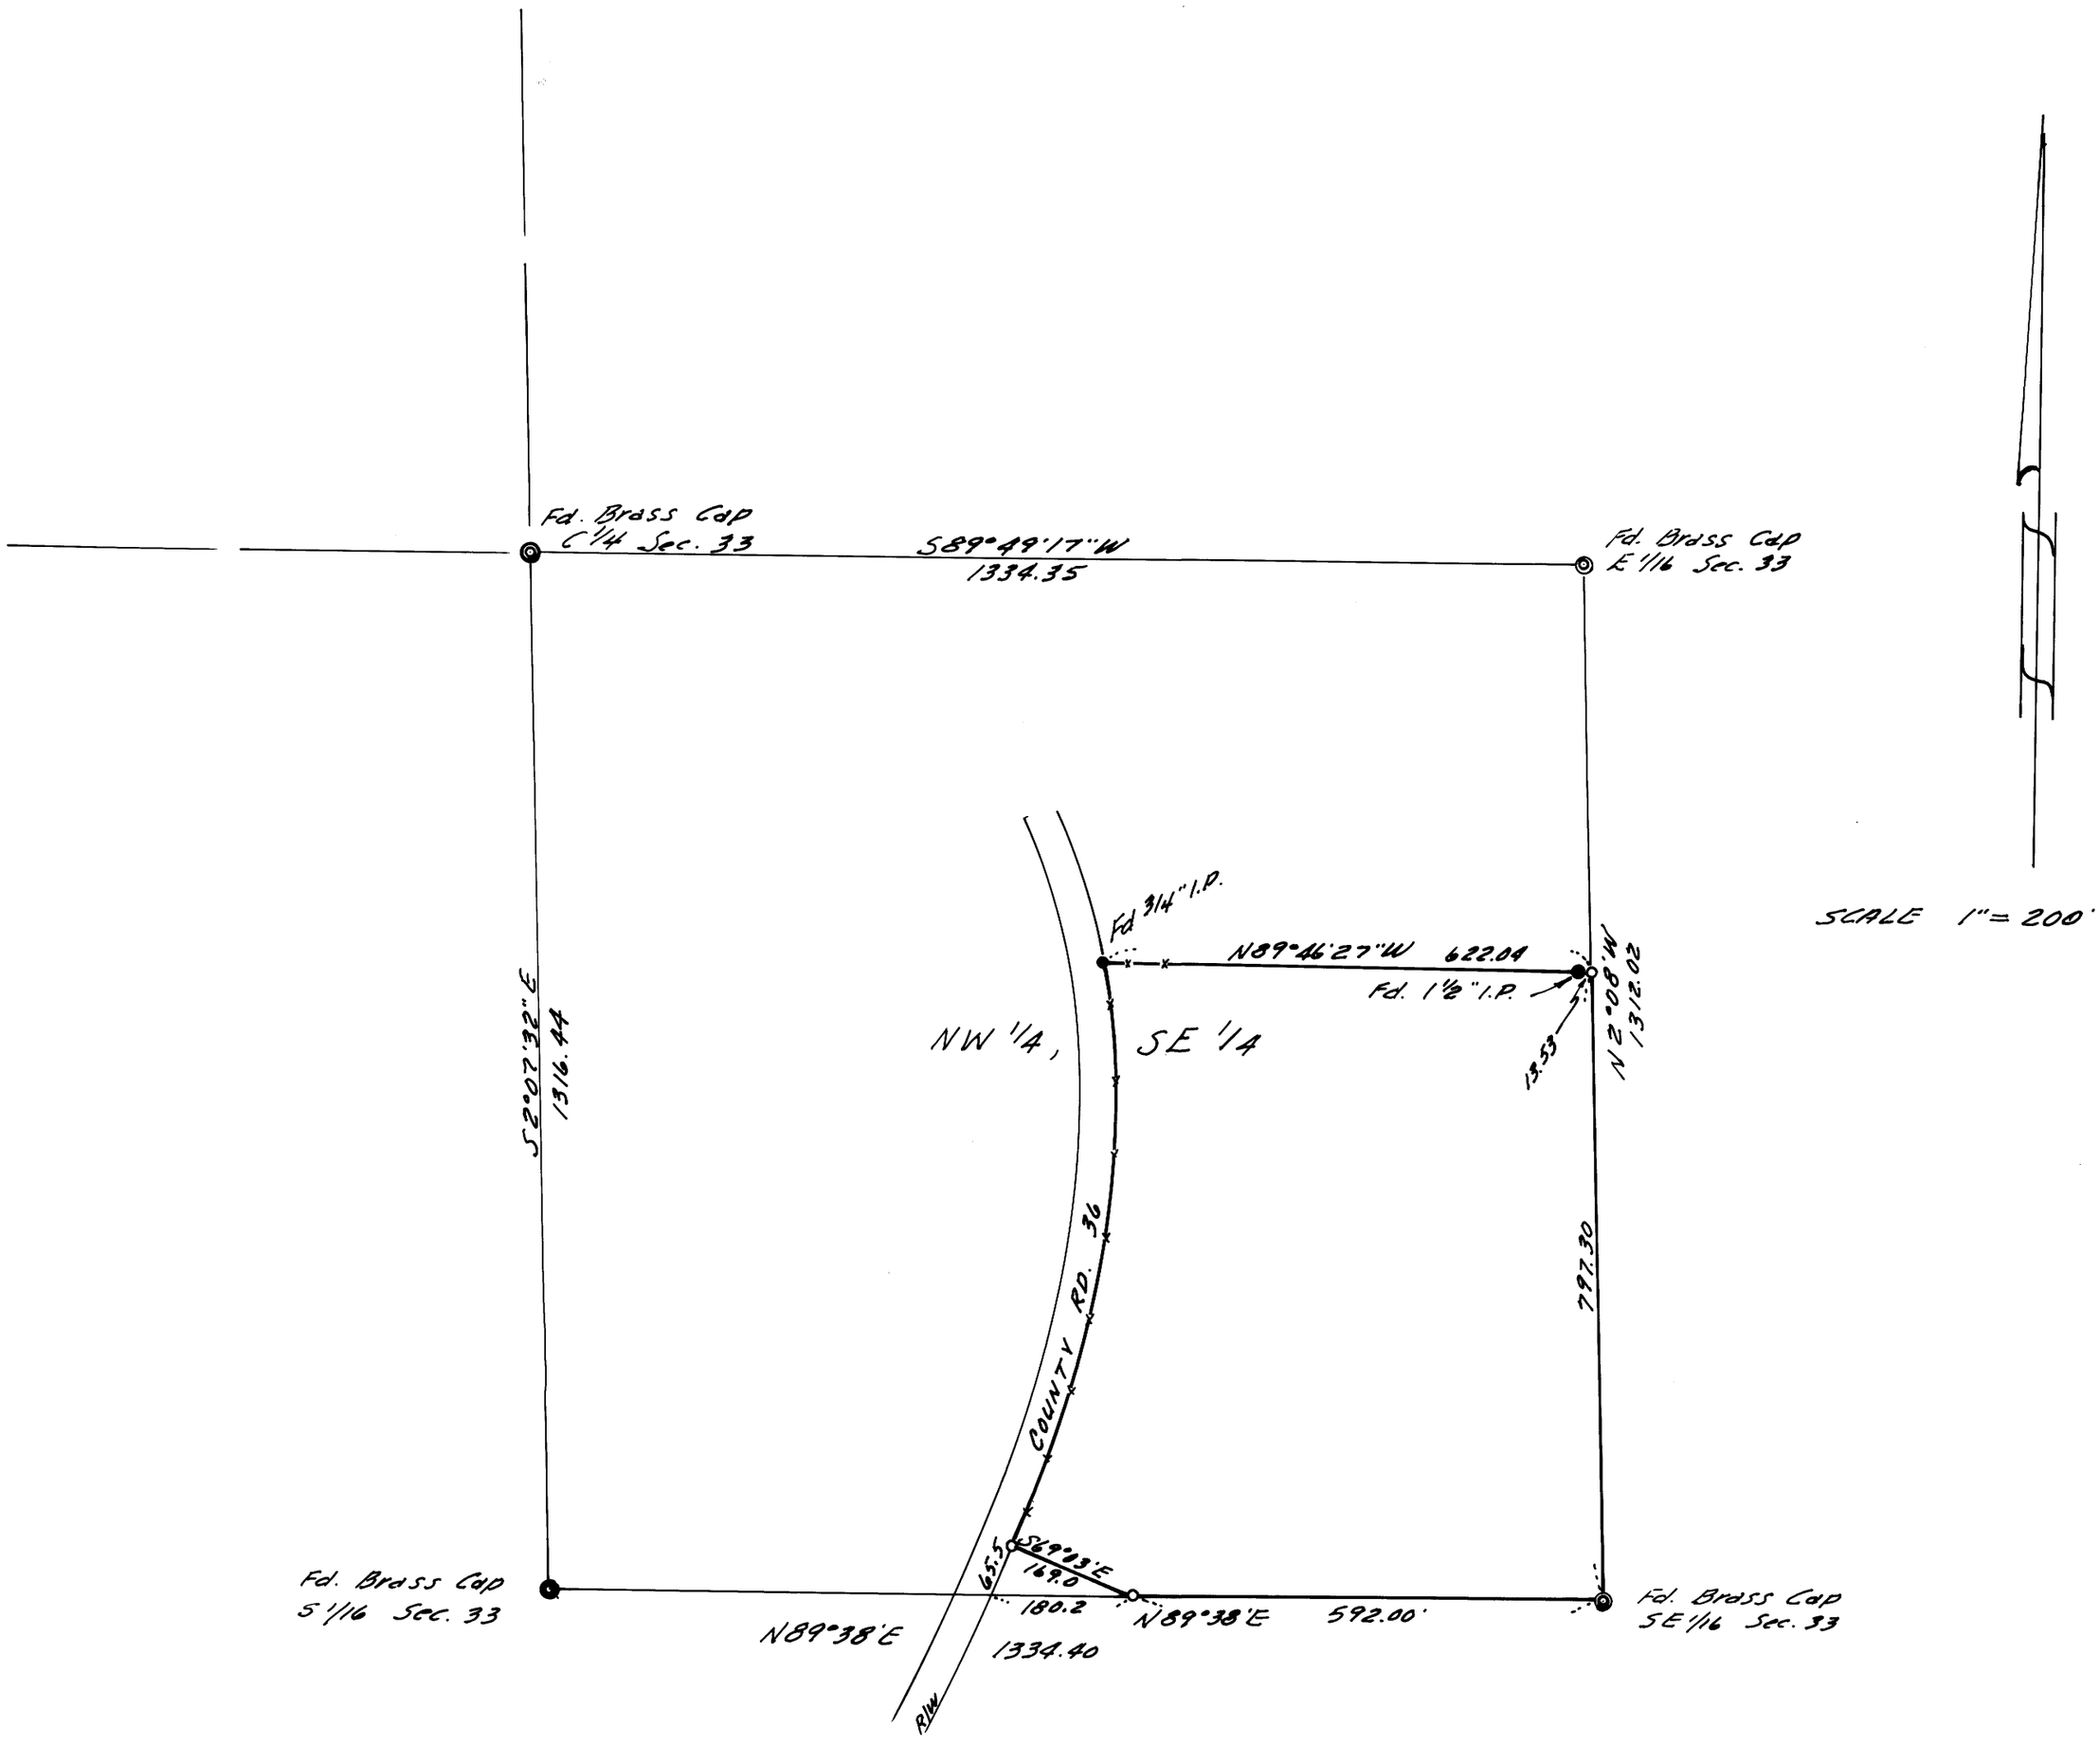

SCALE 1" = 200'

○ 5/8" Iron rods set.

Base bearing taken from south line of NW 1/4, SE 1/4, Sec. 33.

REGISTERED PROFESSIONAL ENGINEER
2128
William S. Barnes
OREGON
SEPT 5, 1941
William S. Barnes

MAP FILE M61-51