MAP FILE M61 - 58
COUNTY SURVEYORS FILE DATA
DO NOT REMOVE FROM OFFICE

SURVEY IN SEC. 30, T24S, R5W. W.M.

SURVEYED FOR - KEITH PEDERSEN
SURVEYED BY - W.S. BARNES

SEPT. 1976
SCALE 1" = 600'

FILED
RECEIVED SF
OCT 5 1976
COUNTY SURVEYOR
DOUGLAS COUNTY, ORE.

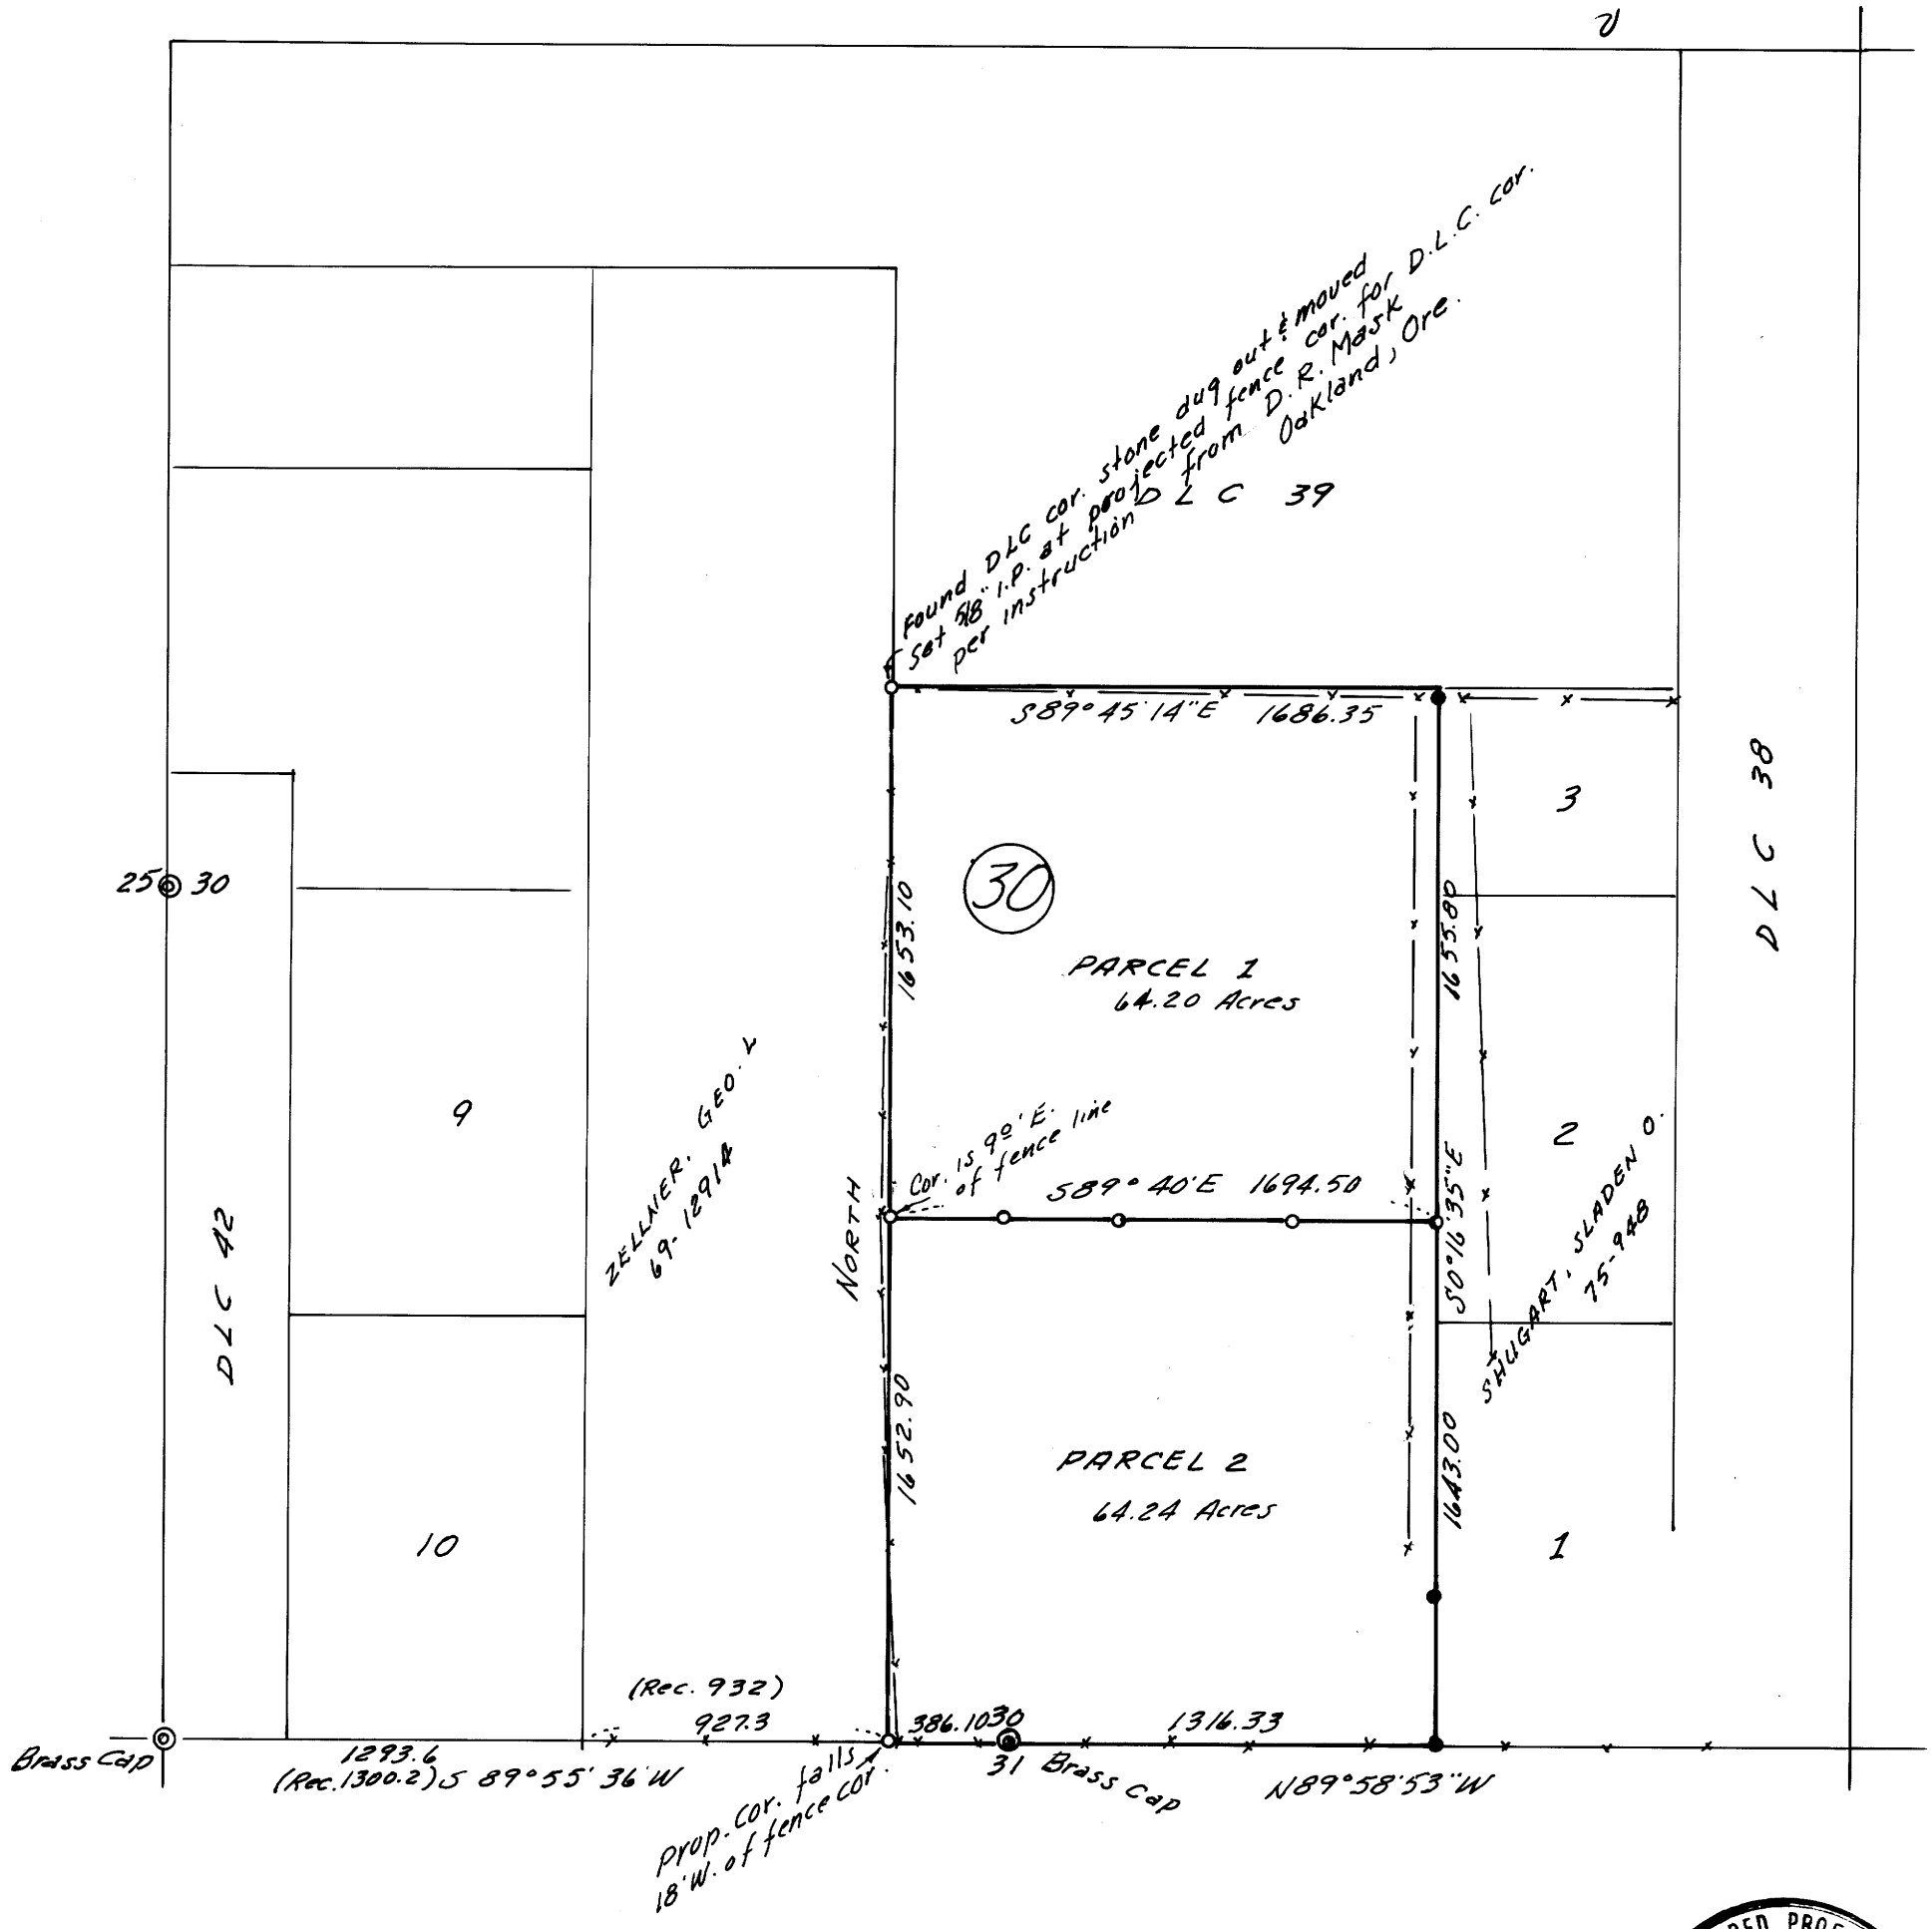

- ● Monuments found
- ○ 5/8" iron rods set.

Base bearing taken from south line of Sec. 30

Refr. Map M61-20

REGISTERED PROFESSIONAL ENGINEER 2128 OREGON SEPT 5, 1941 William S. Barnes

W S Barnes

MAP FILE M61 - 58