MAP FILE M61 - 60

Survey in Sec. 12, T28S, R7W, W.M. & Sec. 7, T28S, R6W, W.M.

For: Charles Wuergler
By: BHW Eng. & Surveying, Inc.
Date: October 1976

COUNTY SURVEYORS FILE DATA
DO NOT REMOVE FROM OFFICE

FILED
RECEIVED
OCT 8 1976
COUNTY SURVEYOR
DOUGLAS COUNTY, ORE.

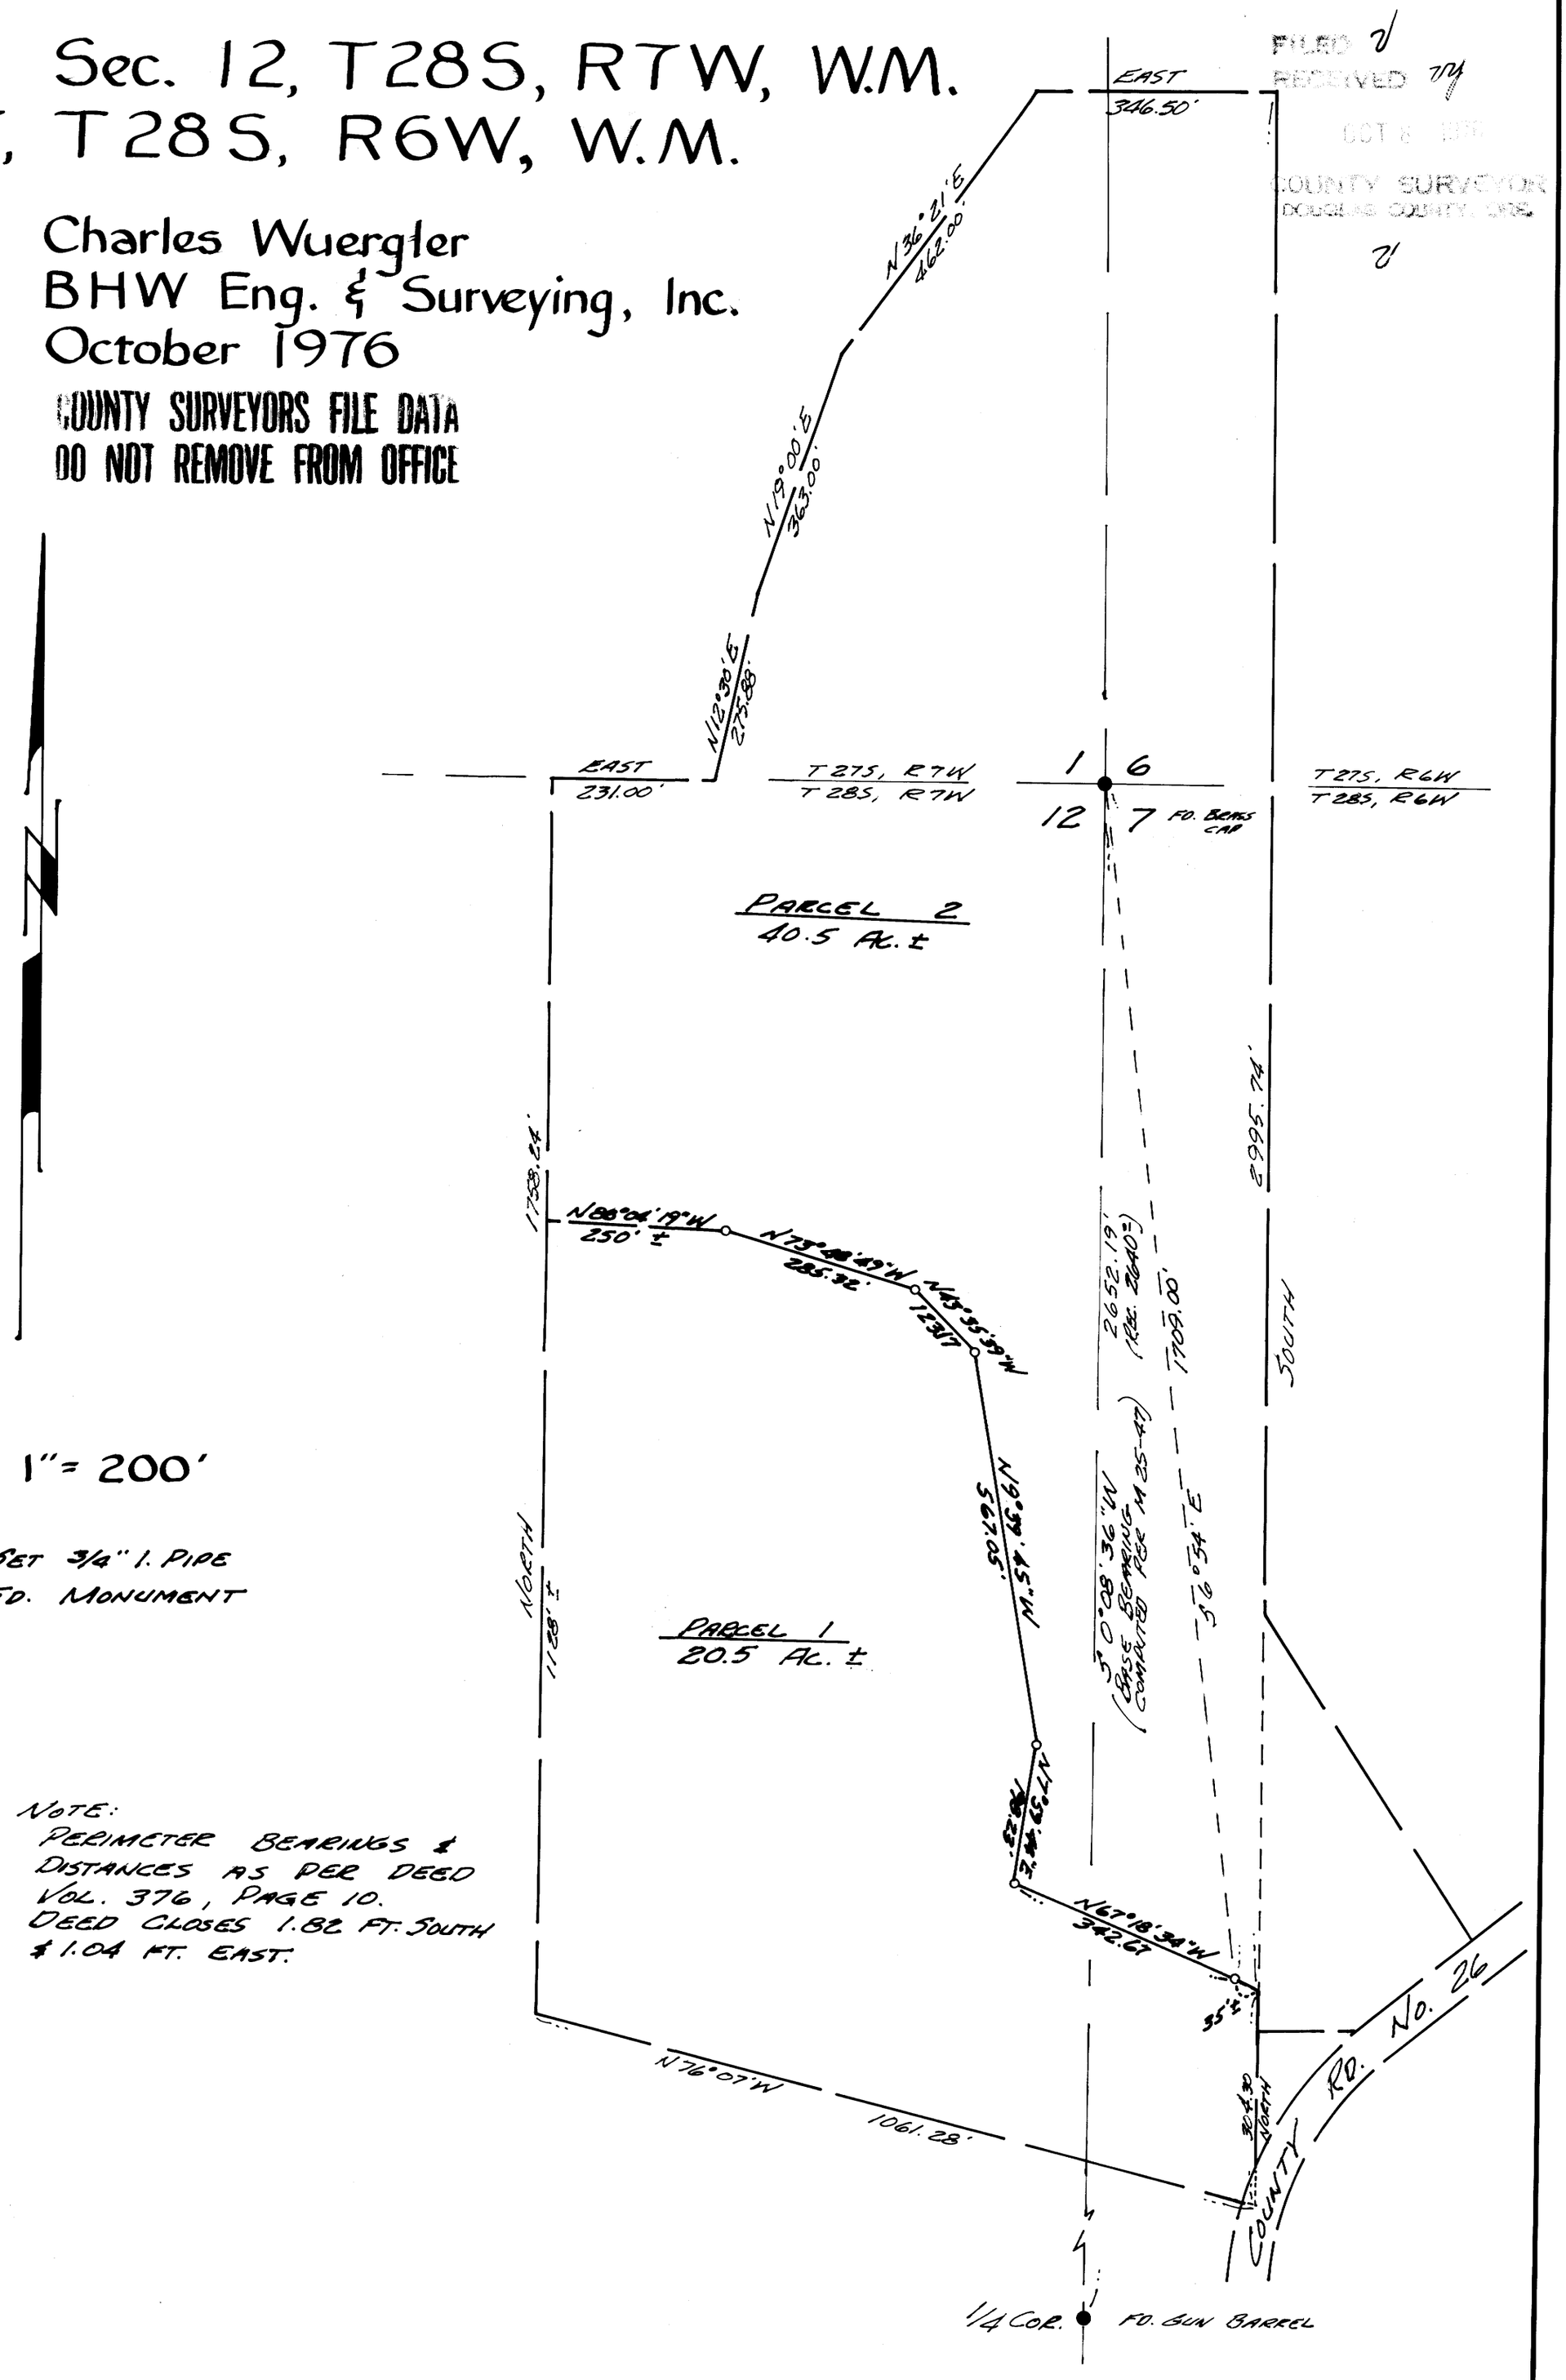

Scale 1" = 200'

○ — SET 3/4" I. PIPE
● — FD. MONUMENT

REGISTERED PROFESSIONAL LAND SURVEYOR
Romanso E. Ware
OREGON
NOV. 16, 1973
ROMANSO E. WARE
1005

NOTE:
PERIMETER BEARINGS & DISTANCES AS PER DEED VOL. 376, PAGE 10.
DEED CLOSES 1.82 FT. SOUTH & 1.04 FT. EAST.

MAP FILE M61 - 60