MAP FILE M61 - 73

SURVEY FOR DESCRIPTION
IN SECTION 13, T.27S. R.7W.W.M.
FOR: ELMER GILES
BY: BAUGHMAN SURVEYING SERVICE

SEPTEMBER 1976 SCALE: 1"=100'

COUNTY SURVEYOR FILE DATA
DO NOT REMOVE FROM OFFICE

FILED
RECEIVED
JUL 1 1 1986
COUNTY SURVEYOR

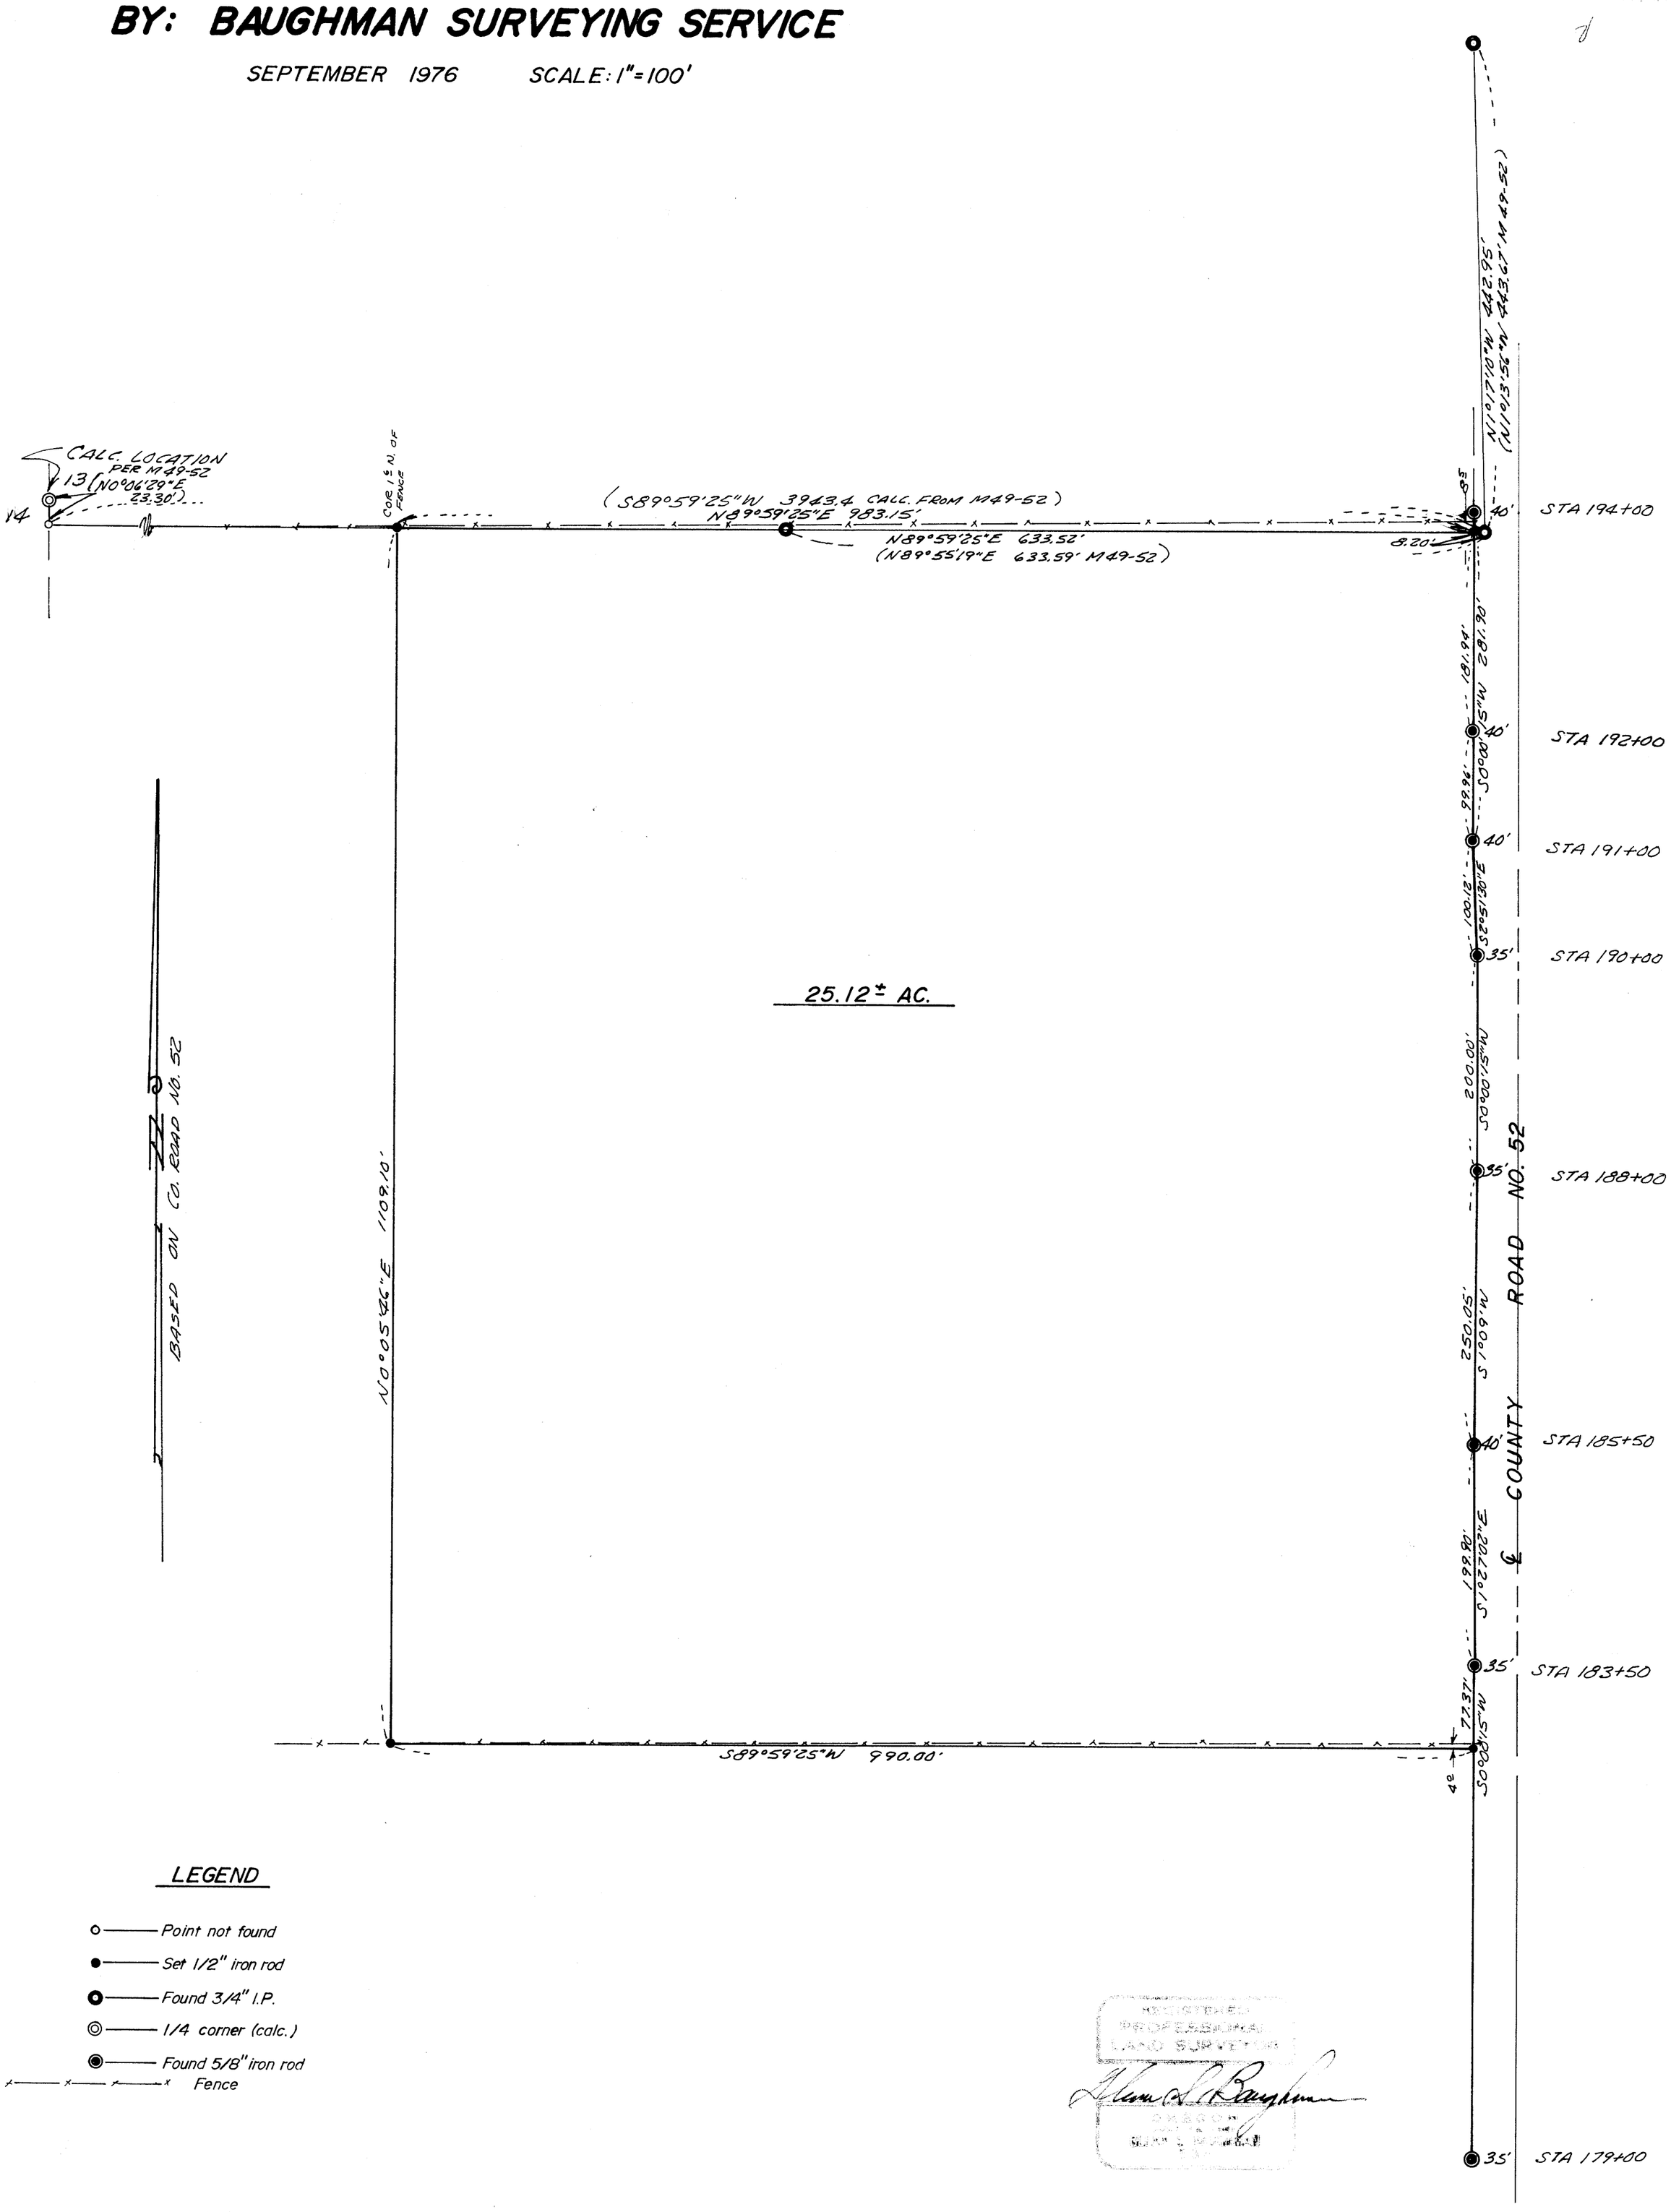

LEGEND

- Point not found
- Set 1/2" iron rod
- Found 3/4" I.P.
- 1/4 corner (calc.)
- Found 5/8" iron rod
- Fence

REGISTERED PROFESSIONAL LAND SURVEYOR
OREGON
JULY 9, 1986

36-569

MAP FILE M61 - 73