COUNTY SURVEYORS FILE DATA
DO NOT REMOVE FROM OFFICE

MAP FILE M62-17

FILED
RECEIVED
NOV 15 1976
COUNTY SURVEYOR
DOUGLAS COUNTY, ORE.

SURVEY

Sec. 30, T. 28 S., R. 7 W., W.M.
Douglas County, Oregon

November 1976 Scale: 1" = 200'

For: Frederick Standley
Ed Schultz

By: S & J Engineering

REGISTERED PROFESSIONAL ENGINEER
8706
Leonard L. Smith
OREGON
FEBRUARY 13, 1976
LEONARD L. SMITH

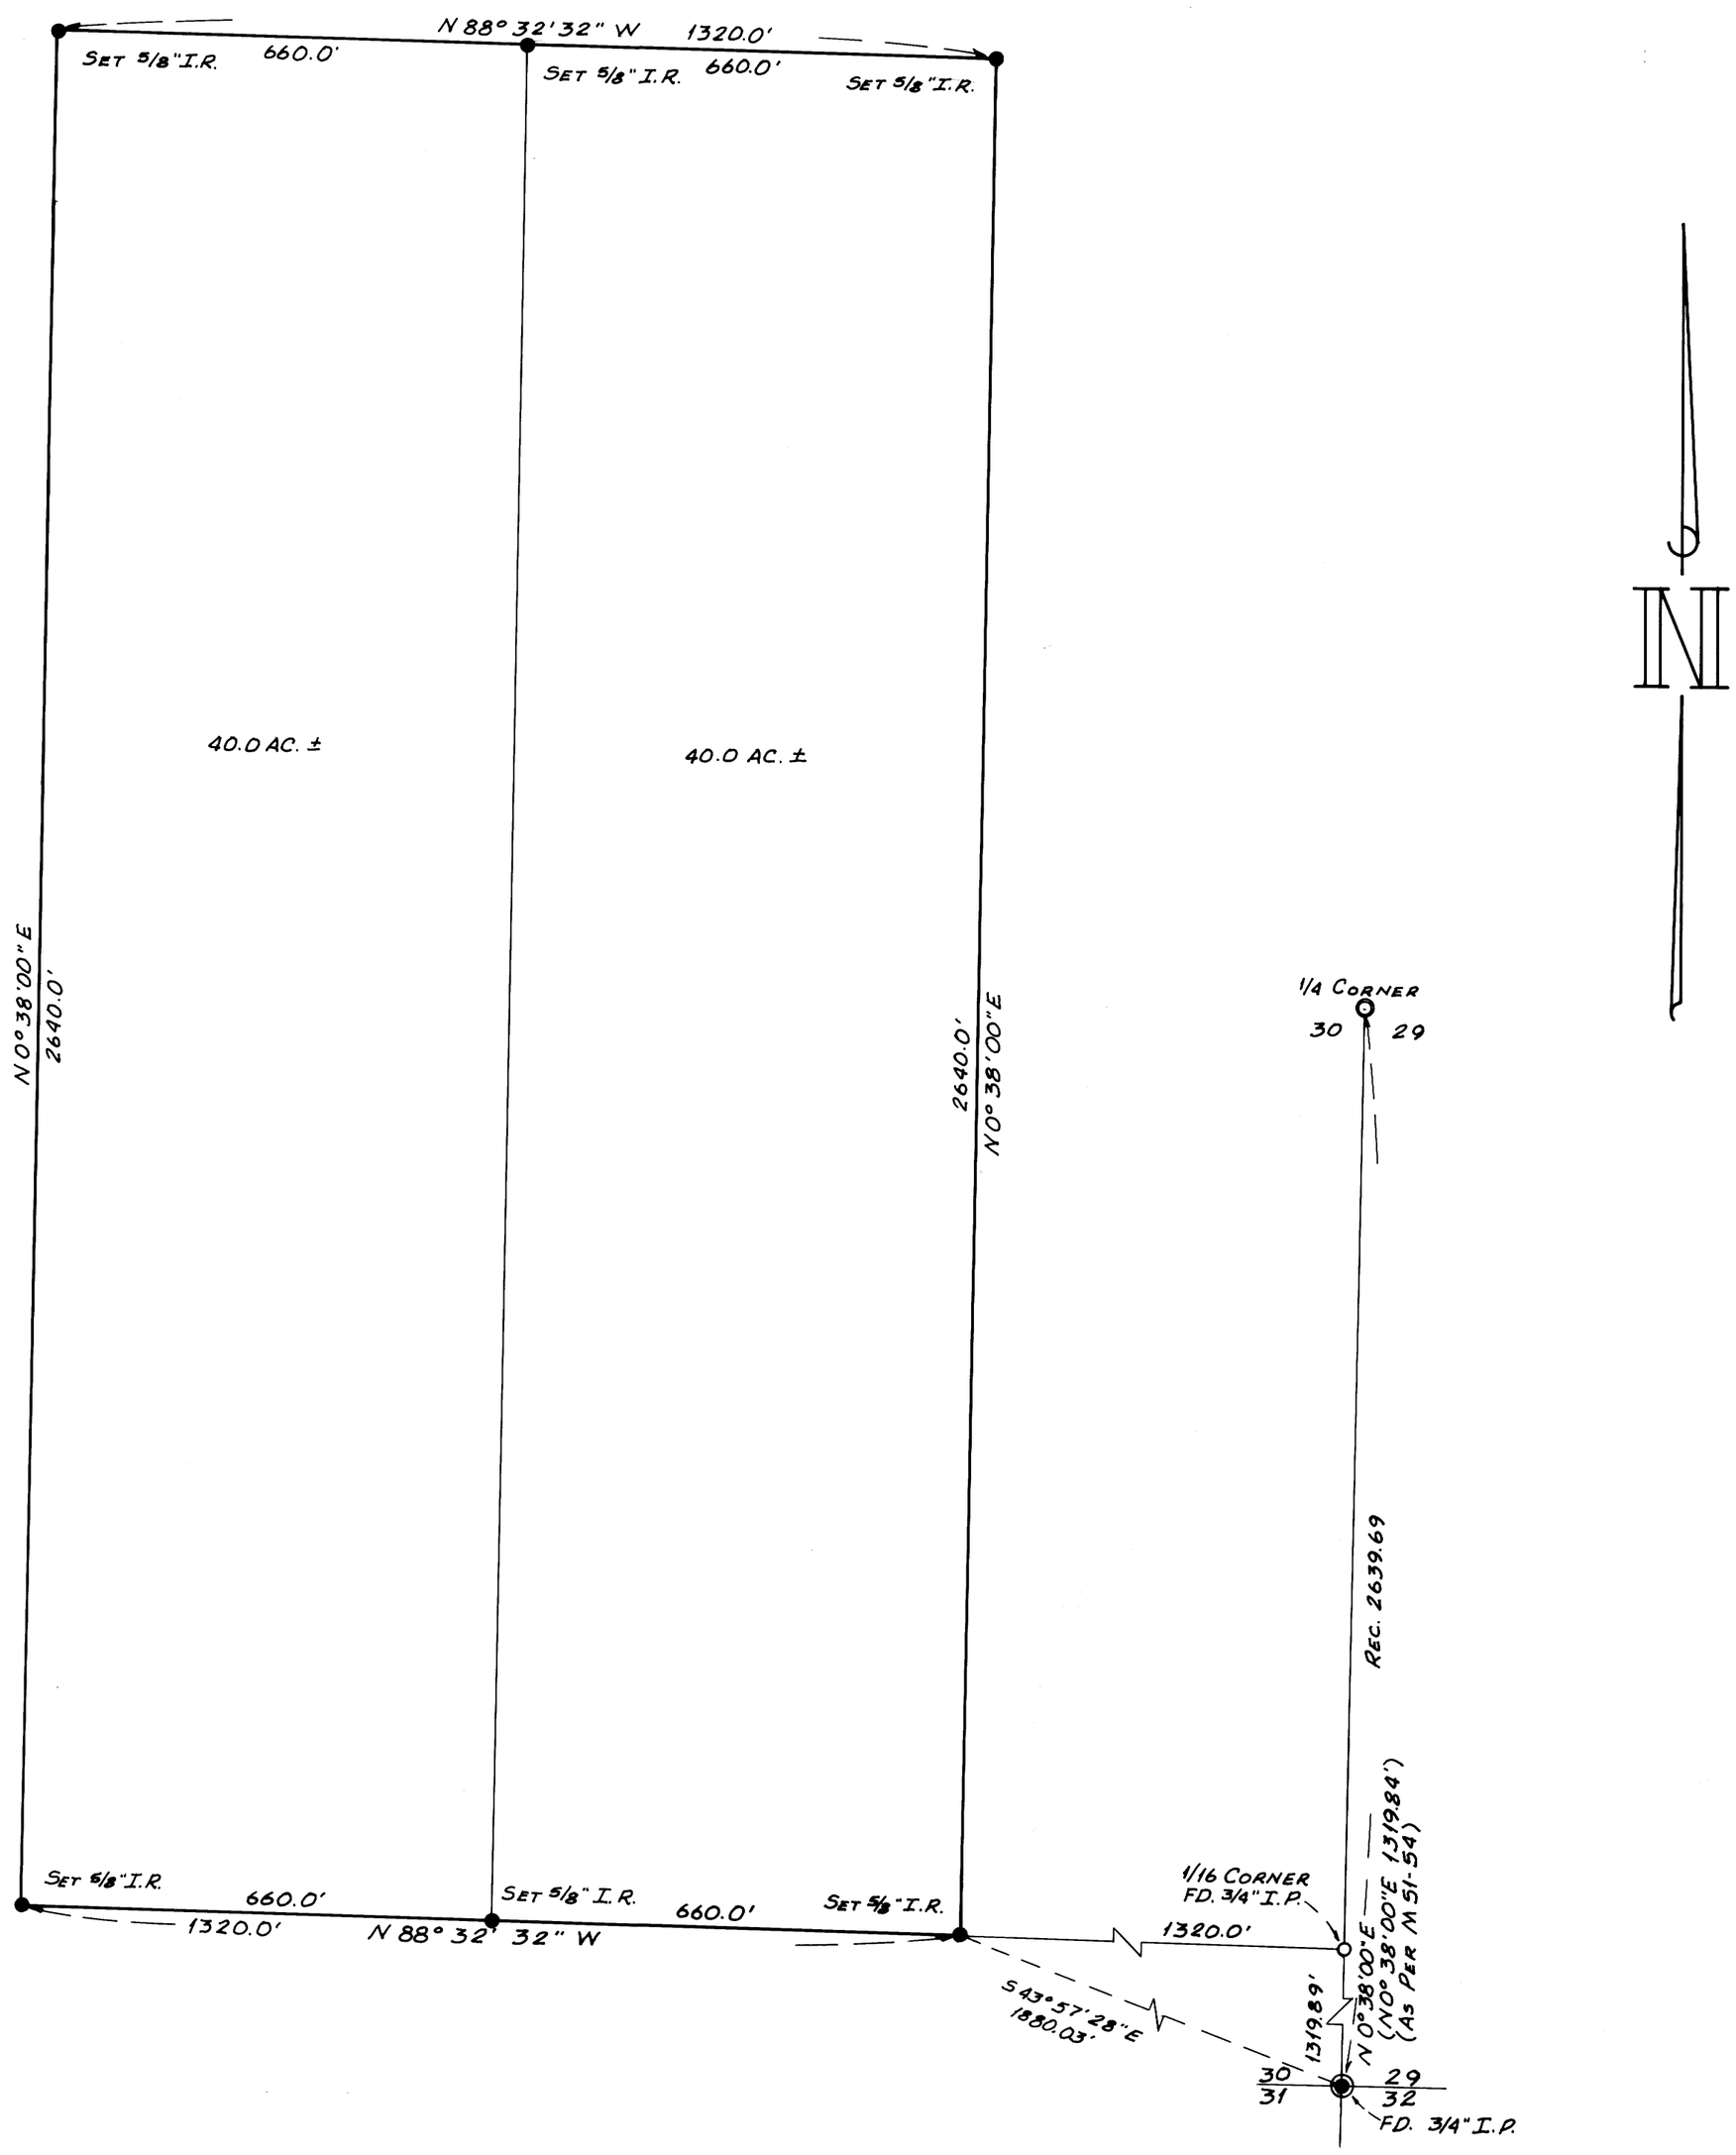

MAP FILE M62-17