MAP FILE M62 - 30

COUNTY SURVEYORS FILE DATA
DO NOT REMOVE FROM OFFICE

FILED
RECEIVED
NOV 29 1976
COUNTY SURVEYOR
DOUGLAS COUNTY, ORE.
mc

SURVEY TO SET PROPERTY CORNERS

IN LOTS 39 & 40, PLAT H, ROSEBURG HOME-ORCHARD TRACTS
S.E. ¼ SEC. 3, T28S, R.6W, W.M.
Surveyed for Jack Barnes Realty by Victor M. McLind
Nov. 1976 Scale: 1" = 100'

o ~ Indicates Set ⅝" x 30" Iron Rod

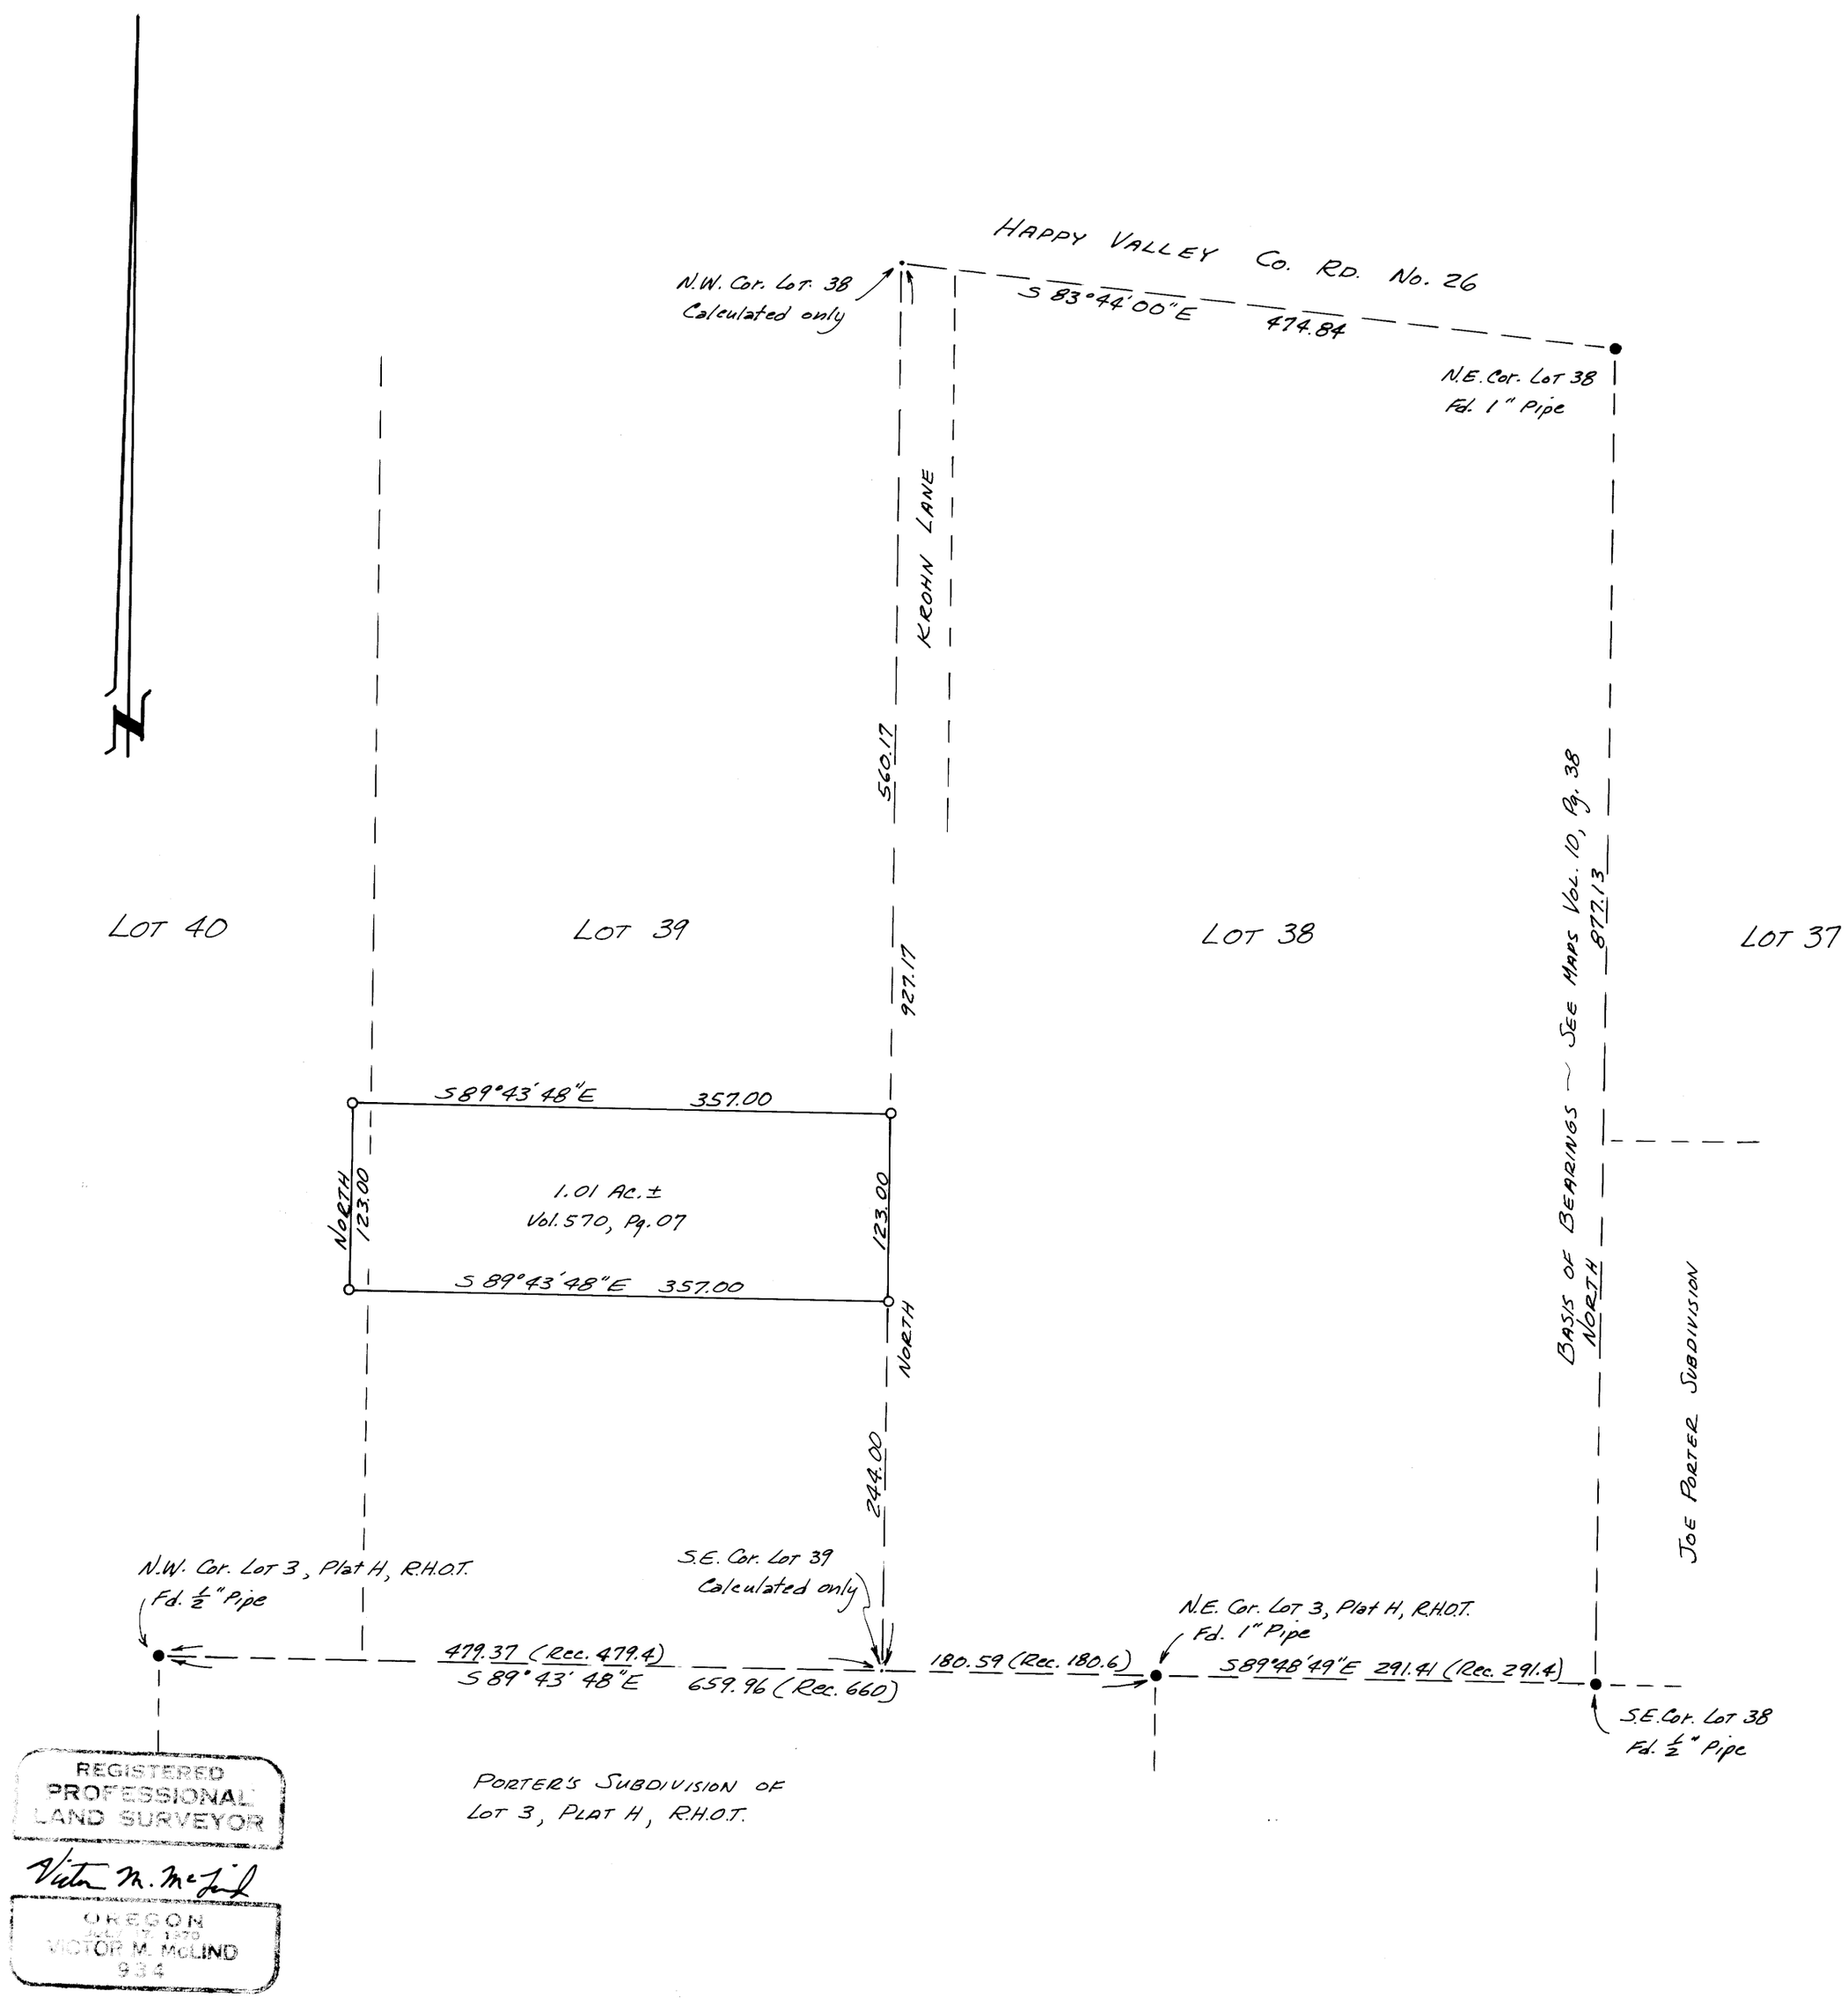

REGISTERED
PROFESSIONAL
LAND SURVEYOR
Victor M. McLind
OREGON
JULY 7, 1970
VICTOR M. McLIND
934

MAP FILE M62 - 30