COUNTY SURVEYORS FILE DATA
DO NOT REMOVE FROM OFFICE

SURVEY IN SECTION 28, T26S, R6W, W.M.
SURVEY FOR JIM MYERS
SURVEY BY BHW ENG. & SURVEYING, INC.
DECEMBER, 1976 SCALE: 1" = 100'

FILED
RECEIVED
JAN 6 1977
COUNTY SURVEYOR
DOUGLAS COUNTY, ORE.

○ — DENOTES SET 5/8" IRON ROD.
● — DENOTES FD. MONUMENT PER M 27-30 UNLESS NOTED OTHERWISE.

REGISTERED
PROFESSIONAL
LAND SURVEYOR
Romanso E. Ware
OREGON
NOV. 16, 1973
ROMANSO E. WARE
1005

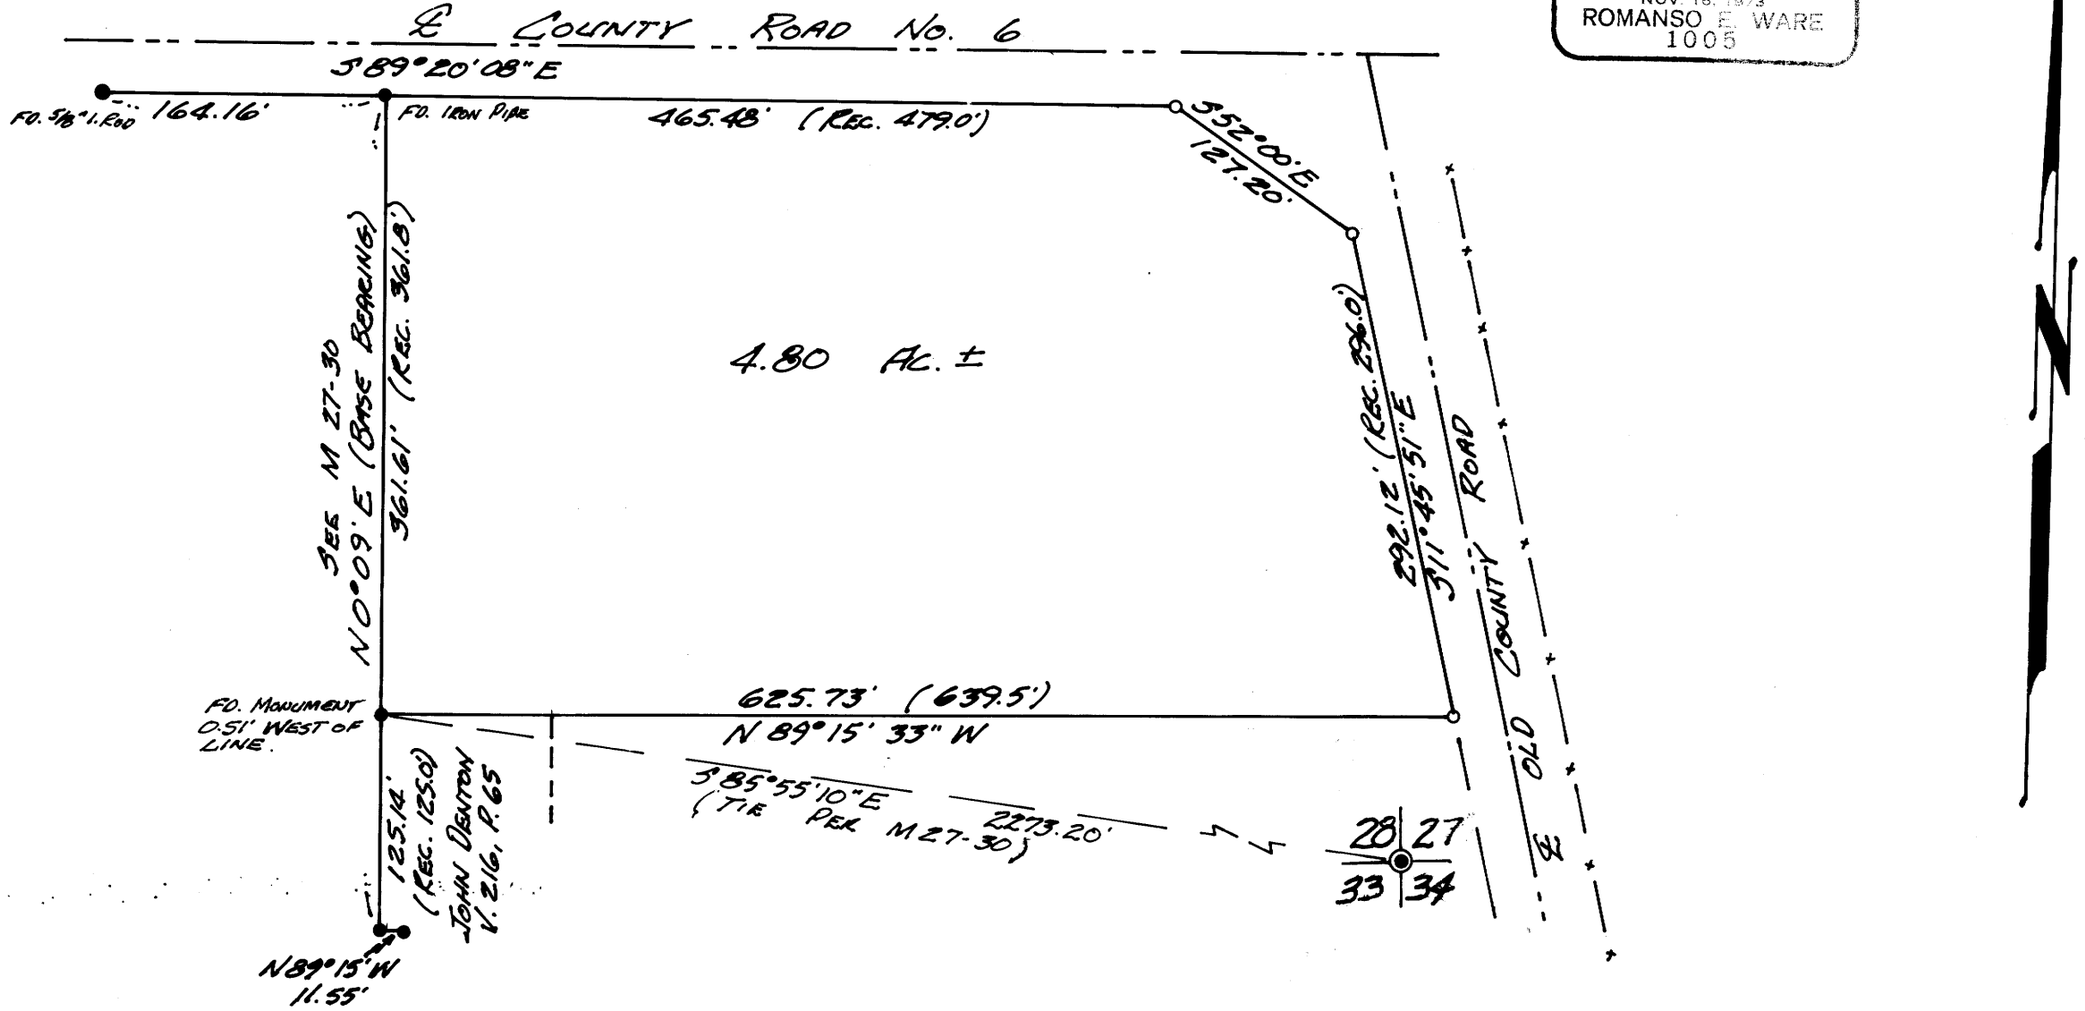

MAP FILE M62-70