COUNTY SURVEYORS FILE DATA
DO NOT REMOVE FROM OFFICE

SUBDIVISION OF SECTION 10 T21S R10W W.M. DOUGLAS COUNTY ORE

SCALE 1" = 1000' DATE JAN 12 1977

FILED
RECEIVED
JAN 19 1977
COUNTY SURVEYOR
DOUGLAS COUNTY, ORE.

MAP FILE M62-78

SURVEY FOR:

INTERNATIONAL PAPER COMPANY
BOX 43, GARDINER, OREGON

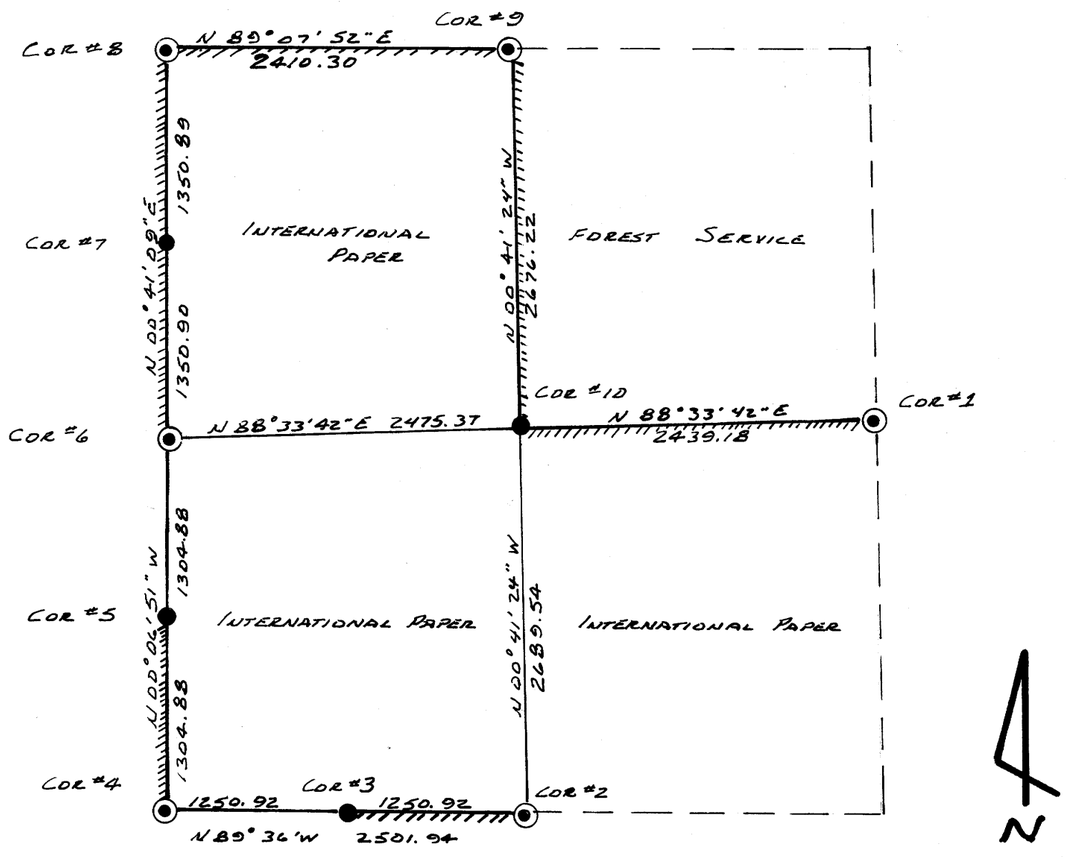

LEGEND

⊙ MONUMENTS FOUND

● MONUMENTS SET

LINES BLAZED

BASIS OF BEARING IS: N 89°36'W FROM S1/4 CORNER TO SW SEC CORNER BY 1919 SURVEY.

CORNER #1 E 1/4 CORNER B.C. FOUND AS SET IN 1968 BY DOUGLAS COUNTY SURVEYOR'S OFFICE ORIG B.T. STILL STANDING

CORNER #2 B.C. S1/4 CORNER FOUND AS SET BY DOUGLAS COUNTY SURVEYOR'S OFFICE IN 1976.

CORNER #3 SET W 1/16 CORNER ON SOUTH LINE - SET 5/8 IRON ROD & WOOD POST GUARD FROM WHICH I SCRIBE & TAG: 6" MAPLE S 53W 5.5 FEET
21" FIR N 19°W 42.1 FEET

CORNER #4 BRASS CAP SECTION CORNER TO 9, 10, 16, 15, FOUND AS SET BY U.S. GENERAL LAND OFFICE SURVEY IN 1919 FD ORIG BT 24" HEMLOCK S 73°E 19 LKS
FD ORIG BT 24" HEMLOCK N 23°W 36 LKS

CORNER #5 SET S 1/16 CORNER ON WEST LINE - SET 5/8 IRON ROD FROM WHICH I SCRIBE:
18" HEMLOCK S 07°40'E 26.2 FEET
26" MAPLE N 49°40'E 33 FEET

CORNER #6 B.C. W1/4 CORNER FOUND AS SET BY U.S. GENERAL LAND OFFICE IN 1919 FROM WHICH I SCRIBE: 30" ALDER N 6°W 32.6 FT
THERE ARE NO OTHER TREES TO SCRIBE

CORNER #7 SET N 1/16 CORNER ON WEST LINE - SET 5/8 IRON ROD FROM WHICH I SCRIBE:
30" FIR S 57°30'E 4 FEET
16" FIR S 50°W 9.6 FEET
14" FIR N 14°30'W 13.4 FEET

CORNER #8 BRASS CAP SECTION CORNER 9/10 FOUND AS SET BY U.S. GENERAL LAND OFFICE IN 1919 FD ORIG BT 36" FIR N 10°E 15 LKS
FD ORIG BT 40" FIR N 40 W 46 LKS

CORNER #9 N 1/4 CORNER B.C. FOUND AS SET BY U.S. GENERAL LAND OFFICE IN 1919
FD ORIG B.T. 12" ALDER
SCRIBED 10" HEMLOCK N 36 E 16.3 FT & TAGGED
12" HEMLOCK S 83°E 22.8 FT & TAGGED

CORNER #10 SET CS1/4 CORNER - SET 5/8 IRON ROD FROM WHICH I SCRIBE:
72" FIR N 58 E 52 FEET
58" FIR S 34 E 49 FEET

REGISTERED PROFESSIONAL ENGINEER 6245
Ronald E. Stuntzner
OREGON
JULY 12, 1968
RONALD E. STUNTZNER

SURVEY BY:

STUNTZNEER ENGINEERING & FORESTRY
1260 GOLDEN AVE COOS BAY ORE

MAP FILE M62-78