COUNTY SURVEYORS FILE DATA
DO NOT REMOVE FROM OFFICE

SURVEY IN SECTIONS 11 & 12, T27S, R6W, W.M.

FILED
RECEIVED
MAR 1 1977
COUNTY SURVEYOR
DOUGLAS COUNTY, ORE.
MC

SURVEY FOR GARDEN HILLS DEVELOPMENT CO.
SURVEY BY BHW ENG. & SURVEYING, INC.
FEB., 1977 SCALE: 1" = 100'

○ — DENOTES SET 5/8" IRON ROD.
● — DENOTES FD. 5/8" IRON ROD UNLESS NOTED OTHERWISE.

BEARINGS BASED ON CONTROL FD. IN "DOGWOOD ESTATES" PLAT.

REGISTERED
PROFESSIONAL
LAND SURVEYOR
Romanso E. Ware
OREGON
NOV. 16, 1973
ROMANSO E. WARE
1005

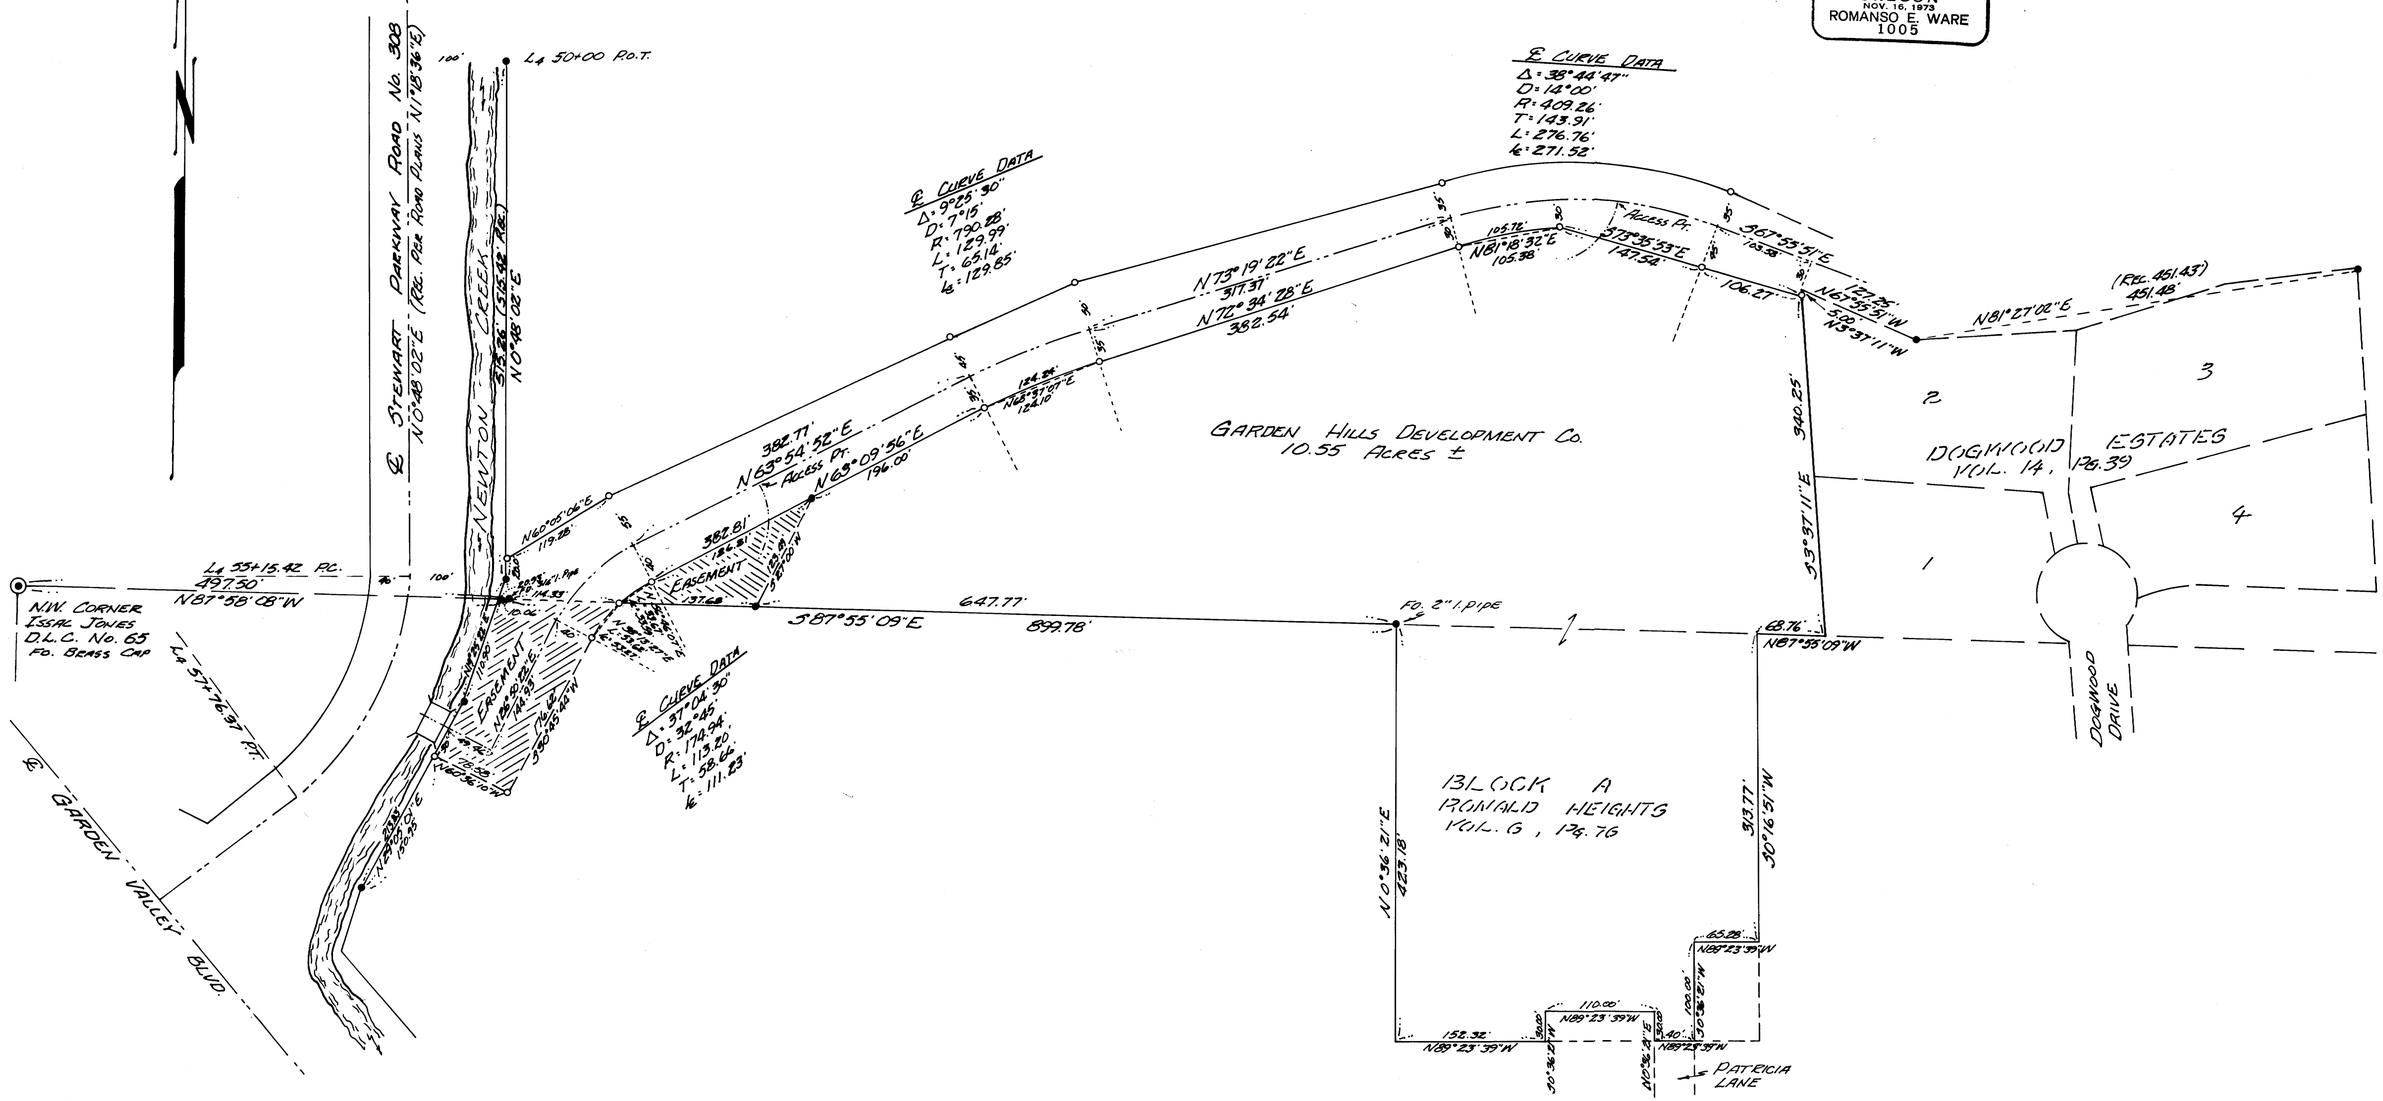

MAP FILE N463 - 33

MAP FILE N463 - 38