COUNTY SURVEYORS FILE DATA
DO NOT REMOVE FROM OFFICE

SURVEY OF LOT 174 TR. 1 PL. 2 ROSEBURG ORCH. CO.

SEC. 36, T. 26 S., R. 6 W., W.M., DOUGLAS CO., ORE.

FOR COLLINS WHOLESALE, ROSEBURG, ORE.
BY HERBERT L. NORTHCRAFT

SCALE 1" = 50'
MAR. 1977

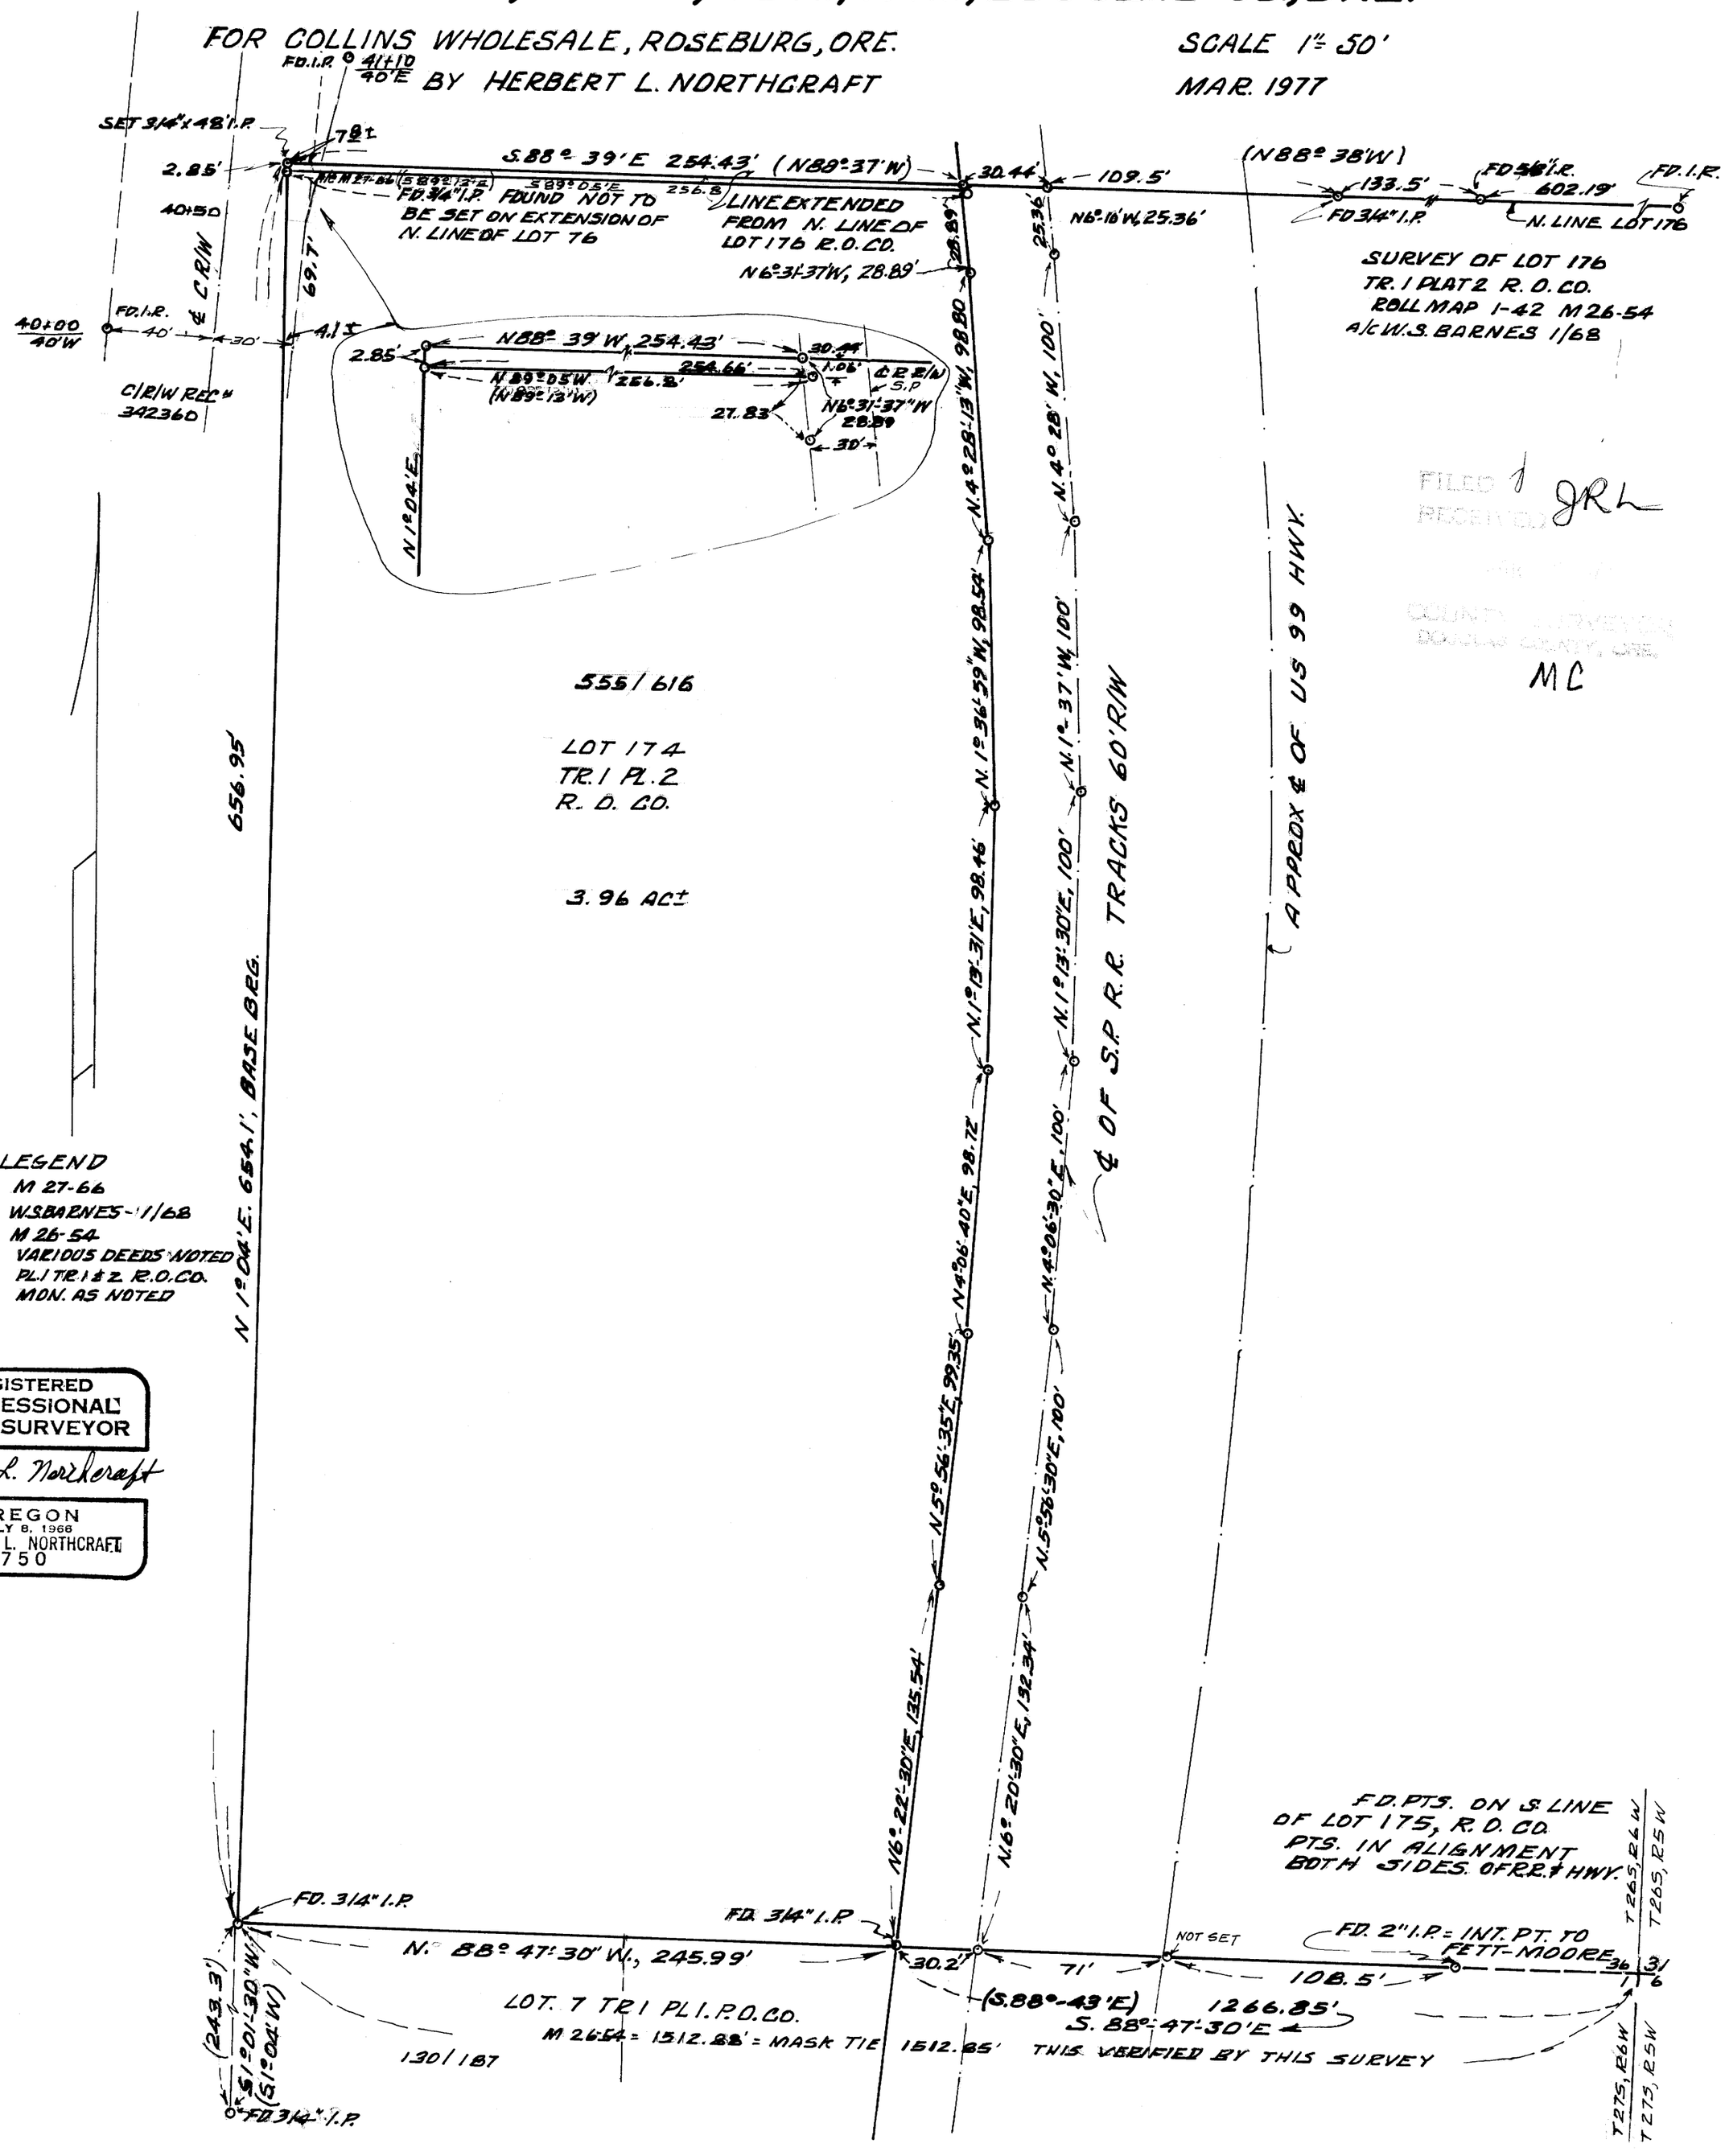

FILED
RECEIVED
JRL
COUNTY SURVEYOR
DOUGLAS COUNTY, ORE.
MC

M 63 - 150