MAP FILE M 63-62

FILED
RECEIVED MC
APR 13 1977
COUNTY SURVEYOR
DOUGLAS COUNTY, ORE.

PROPERTY SURVEY MAP
LOCATED IN NE 1/4 SE 1/4 SEC 4 T22S R12WWM
DOUGLAS COUNTY ORE

FILED
RECEIVED MC
APR 13 1977
COUNTY SURVEYOR
DOUGLAS COUNTY, ORE.

SURVEY FOR:

KNOWLTON INC.
RT 4 BOX 78
REEDSPORT ORE

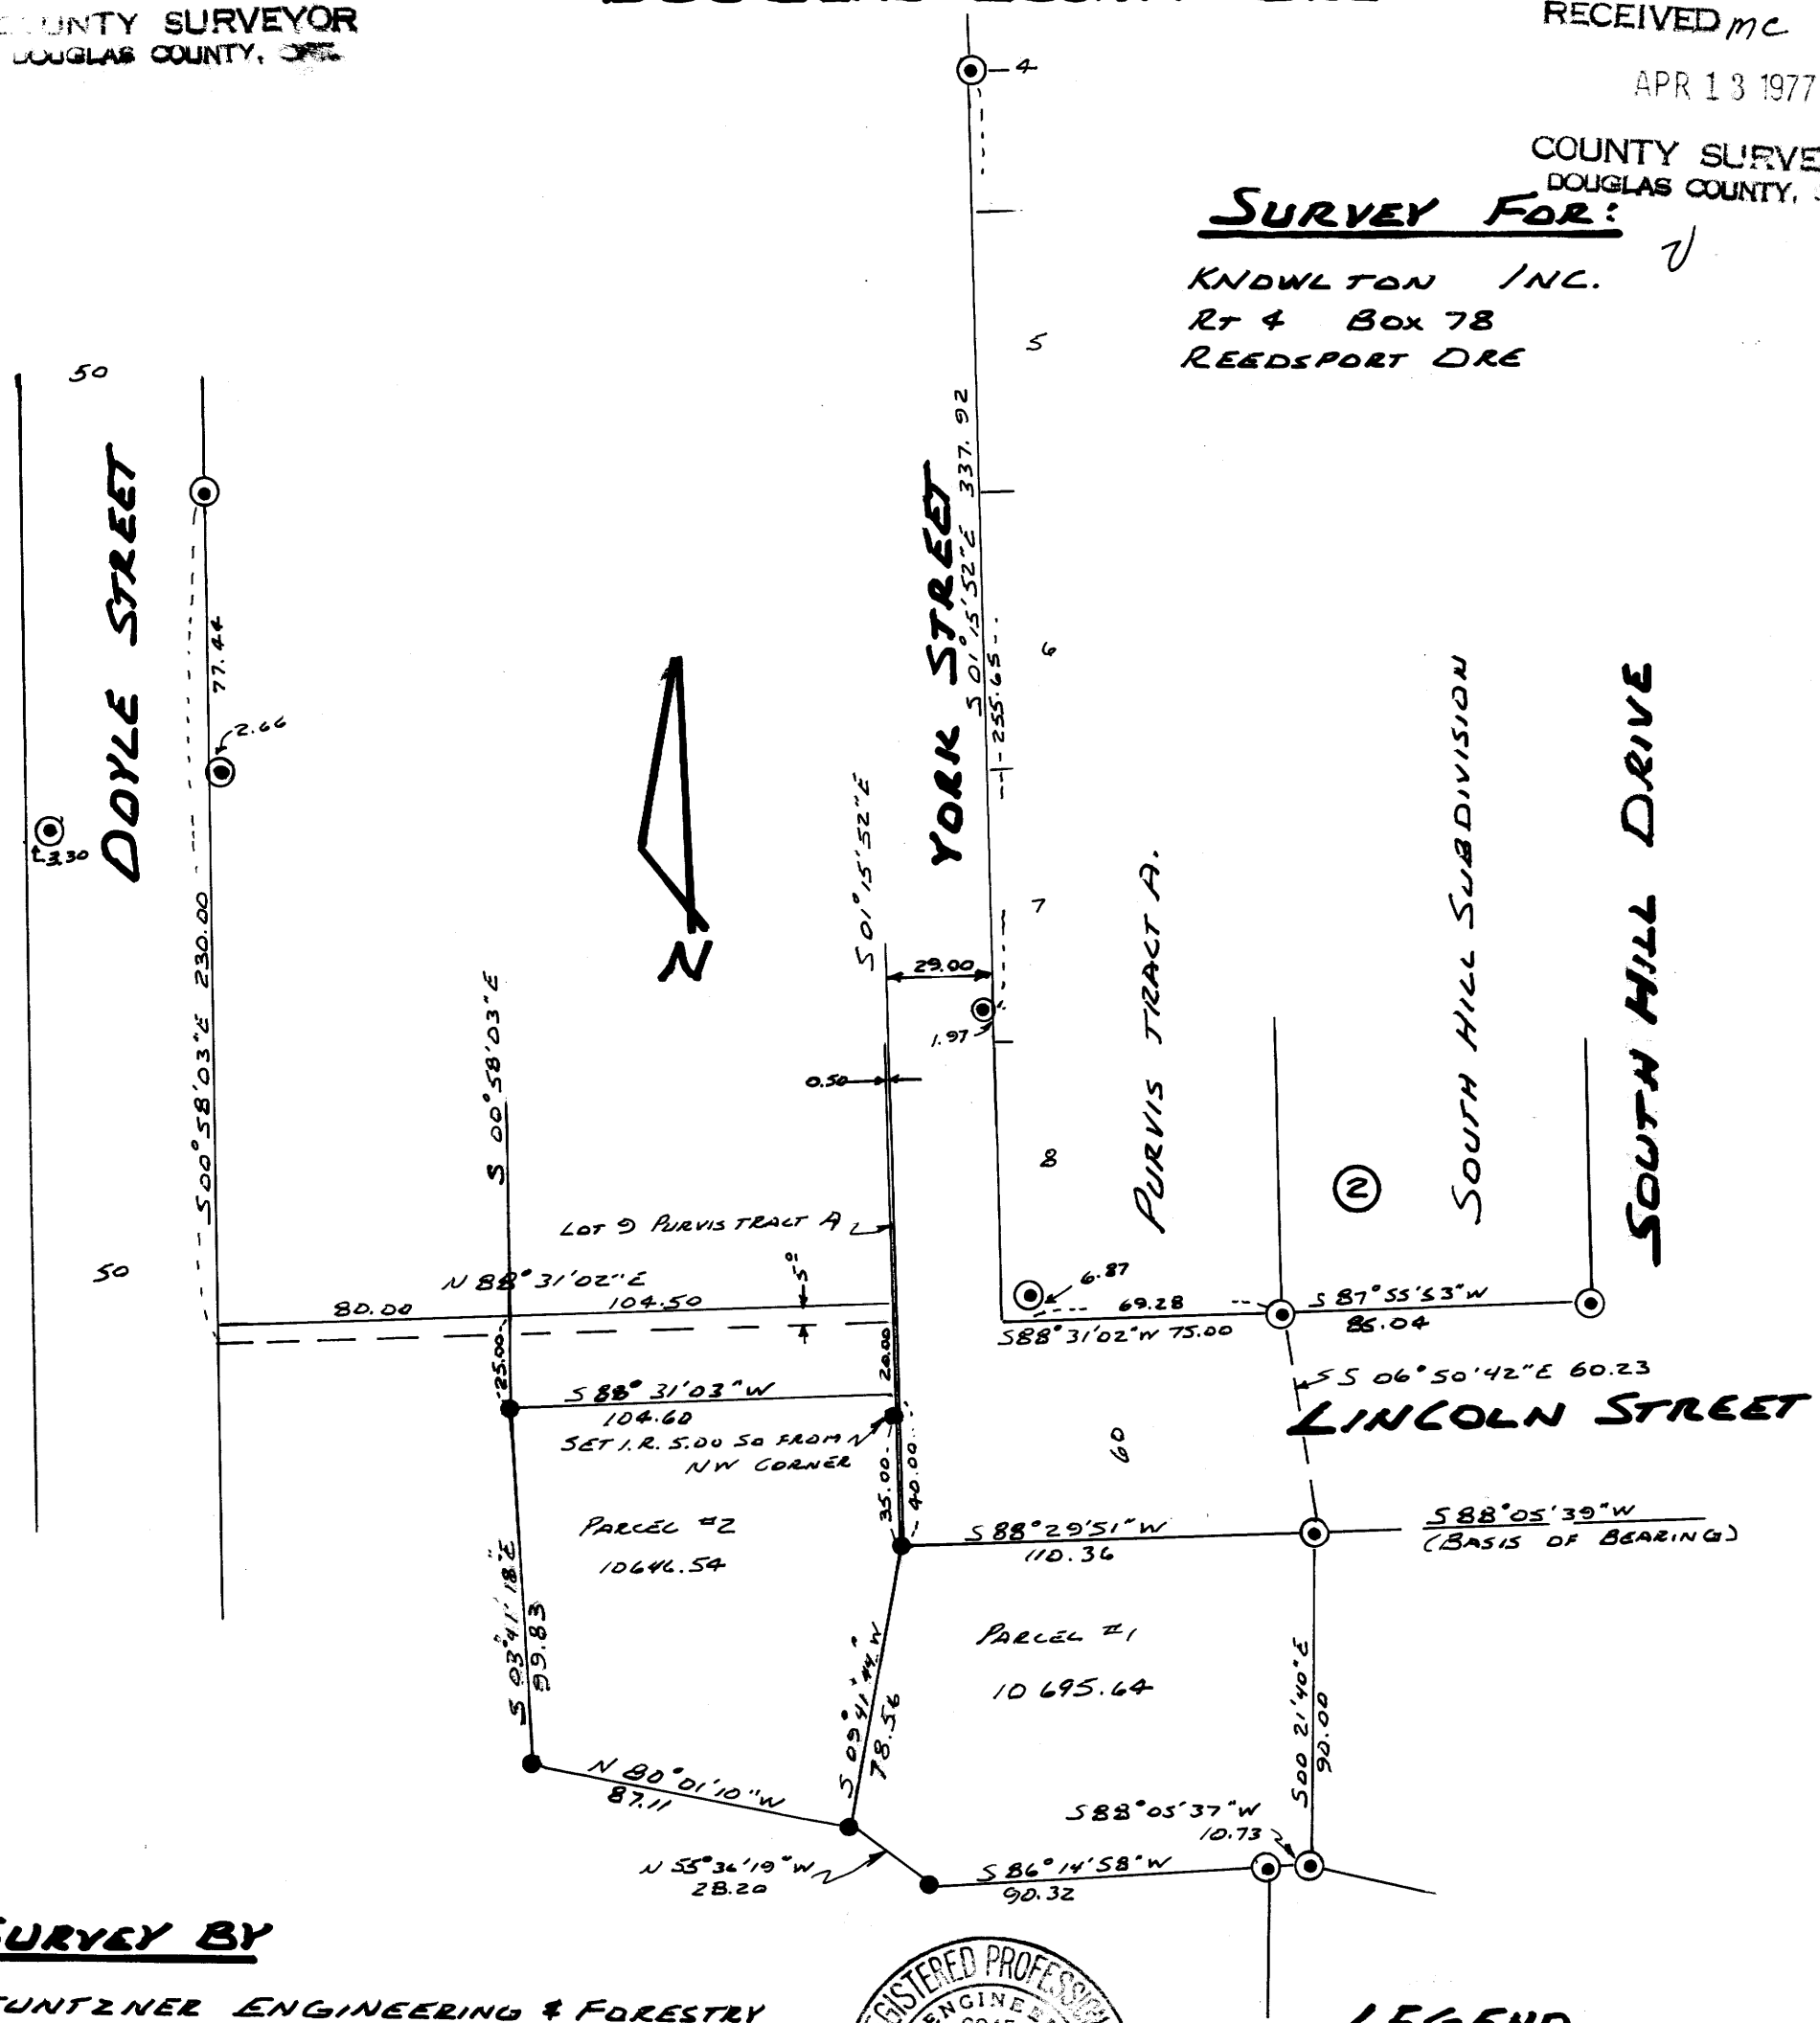

SURVEY BY

STUNTZNER ENGINEERING & FORESTRY
1260 GOLDEN AVE COOS BAY ORE

COUNTY SURVEYORS FILE DATA
DO NOT REMOVE FROM OFFICE

REGISTERED PROFESSIONAL ENGINEER 6245
Ronald E. Stuntzner
OREGON
JULY 12 1968
RONALD E. STUNTZNER

LEGEND

⊙ MONUMENTS FOUND
● MONUMENTS SET
DATE 20 DEC 1976
* BASIS OF BEARING AS SHOWN
SCALE 1" = 50'

MAP FILE M 63-62