FILED ✓
RECEIVED MLL
APR 18 1977
COUNTY SURVEYOR
DOUGLAS COUNTY, ORE.
✓

COUNTY SURVEYORS FILE DATA
DO NOT REMOVE FROM OFFICE

MAP FILE M63-69

SURVEY OF DEED DESCRIPTION, A PART OF THE EAST 5 ACRES
OF ROSEBURG HOME ORCHARD TRACTS PLAT "H" SEC. 3, T. 28 S., R. 6 W. W.M.

FOR

JAMES B. BYFORD

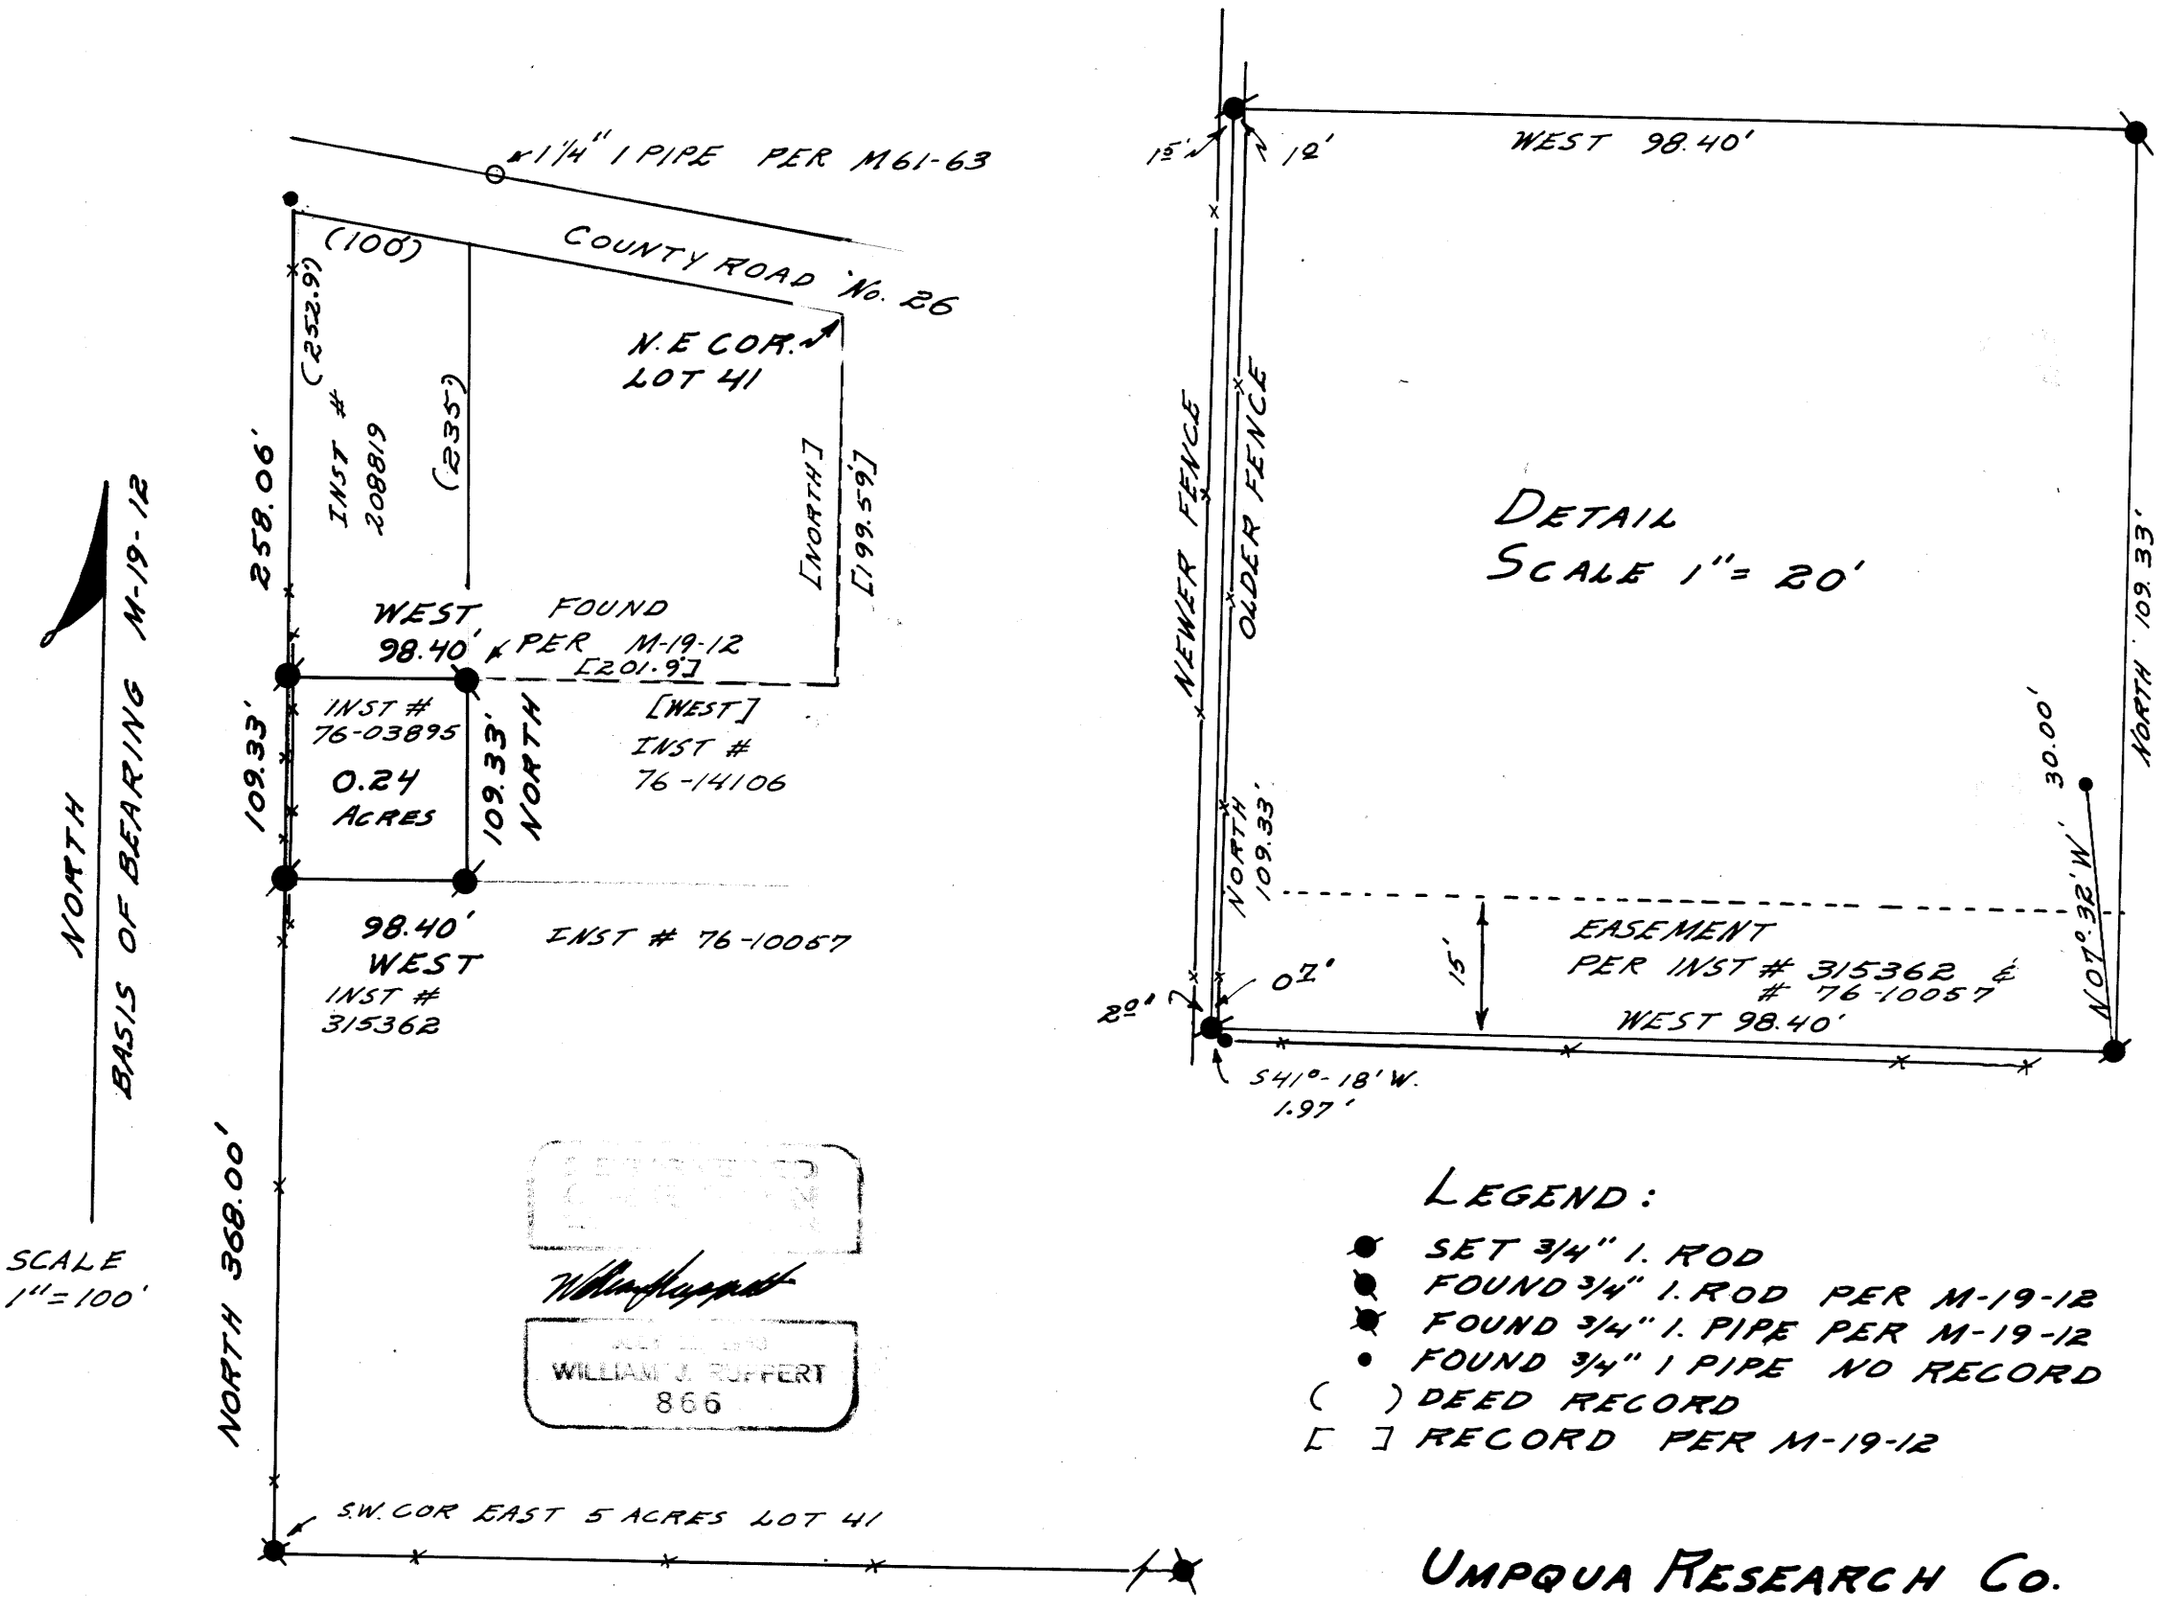

UMPQUA RESEARCH CO.
MYRTLE CREEK, OREGON
APRIL 6, 1977

MAP FILE M63-69