SURVEY FOR DESCRIPTION

COUNTY SURVEYORS FILE DATA
DO NOT REMOVE FROM OFFICE

FILED ✓
RECEIVED DKS
JUN 14 1977
COUNTY SURVEYOR
DOUGLAS COUNTY, ORE.
MC

MAP FILE M64-50

IN SECTION 20, T.30S. R.5W.W.M.

FOR: CHARLES TAYLOR

BY: C & G ENG, INC.

JUNE 1977 — SCALE: 1"=200'

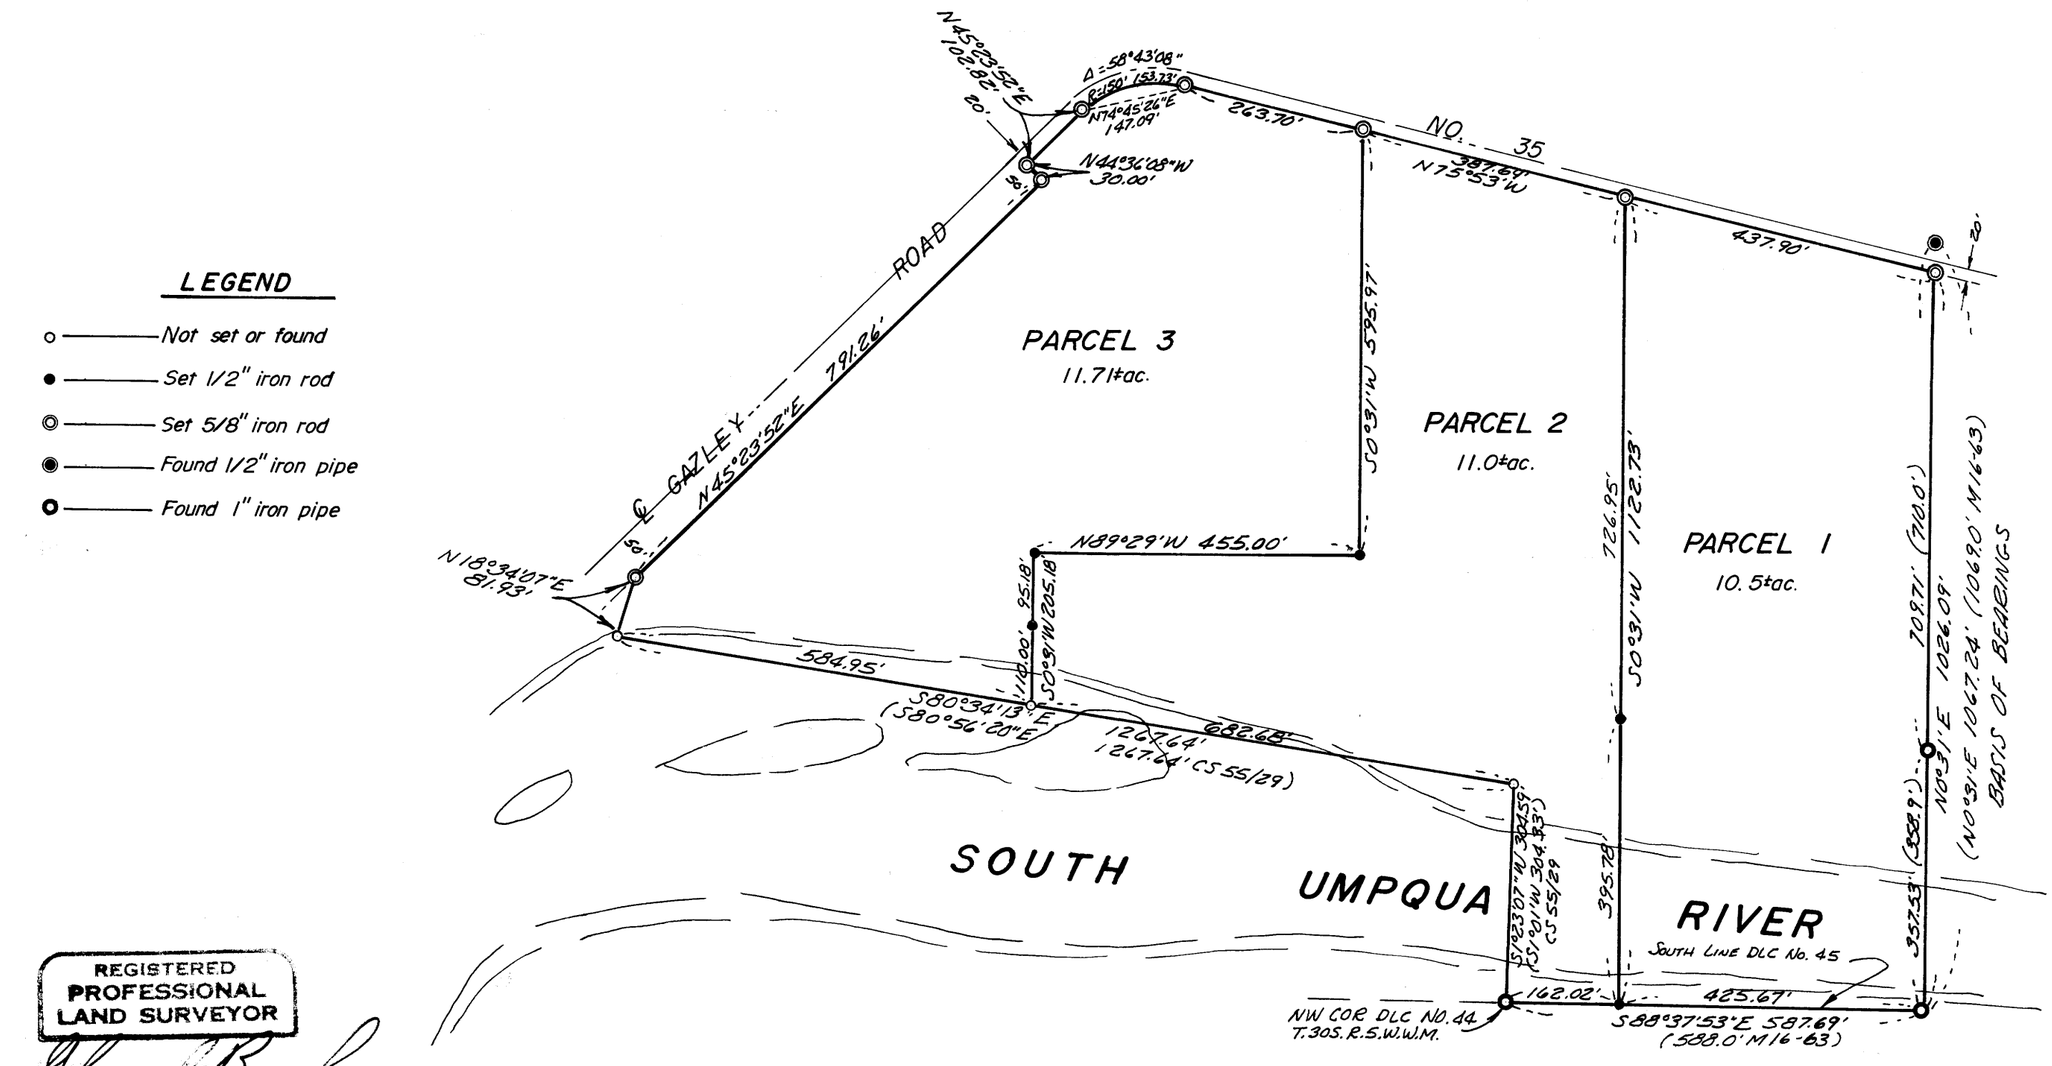

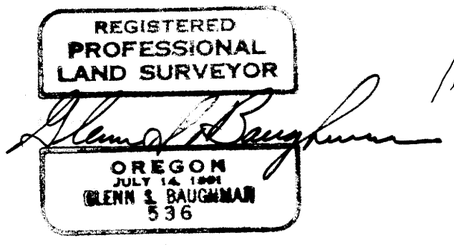

MAP FILE M64-50

6150.0002