MAP FILE M64-9

COUNTY SURVEYORS FILE DATA
DO NOT REMOVE FROM OFFICE

FILED
RECEIVED
MAY 9 1977
COUNTY SURVEYOR
DOUGLAS COUNTY, ORE.

SURVEY IN SEC. 17, T. 29 S., R. 8 W., W.M., DOUGLAS COUNTY, OREGON FOR MISSIONARY CHURCH OF CAMAS VALLEY ORE.

BY HERBERT L. NORTHCRAFT

SCALE 1" = 40'

APRIL, 1977

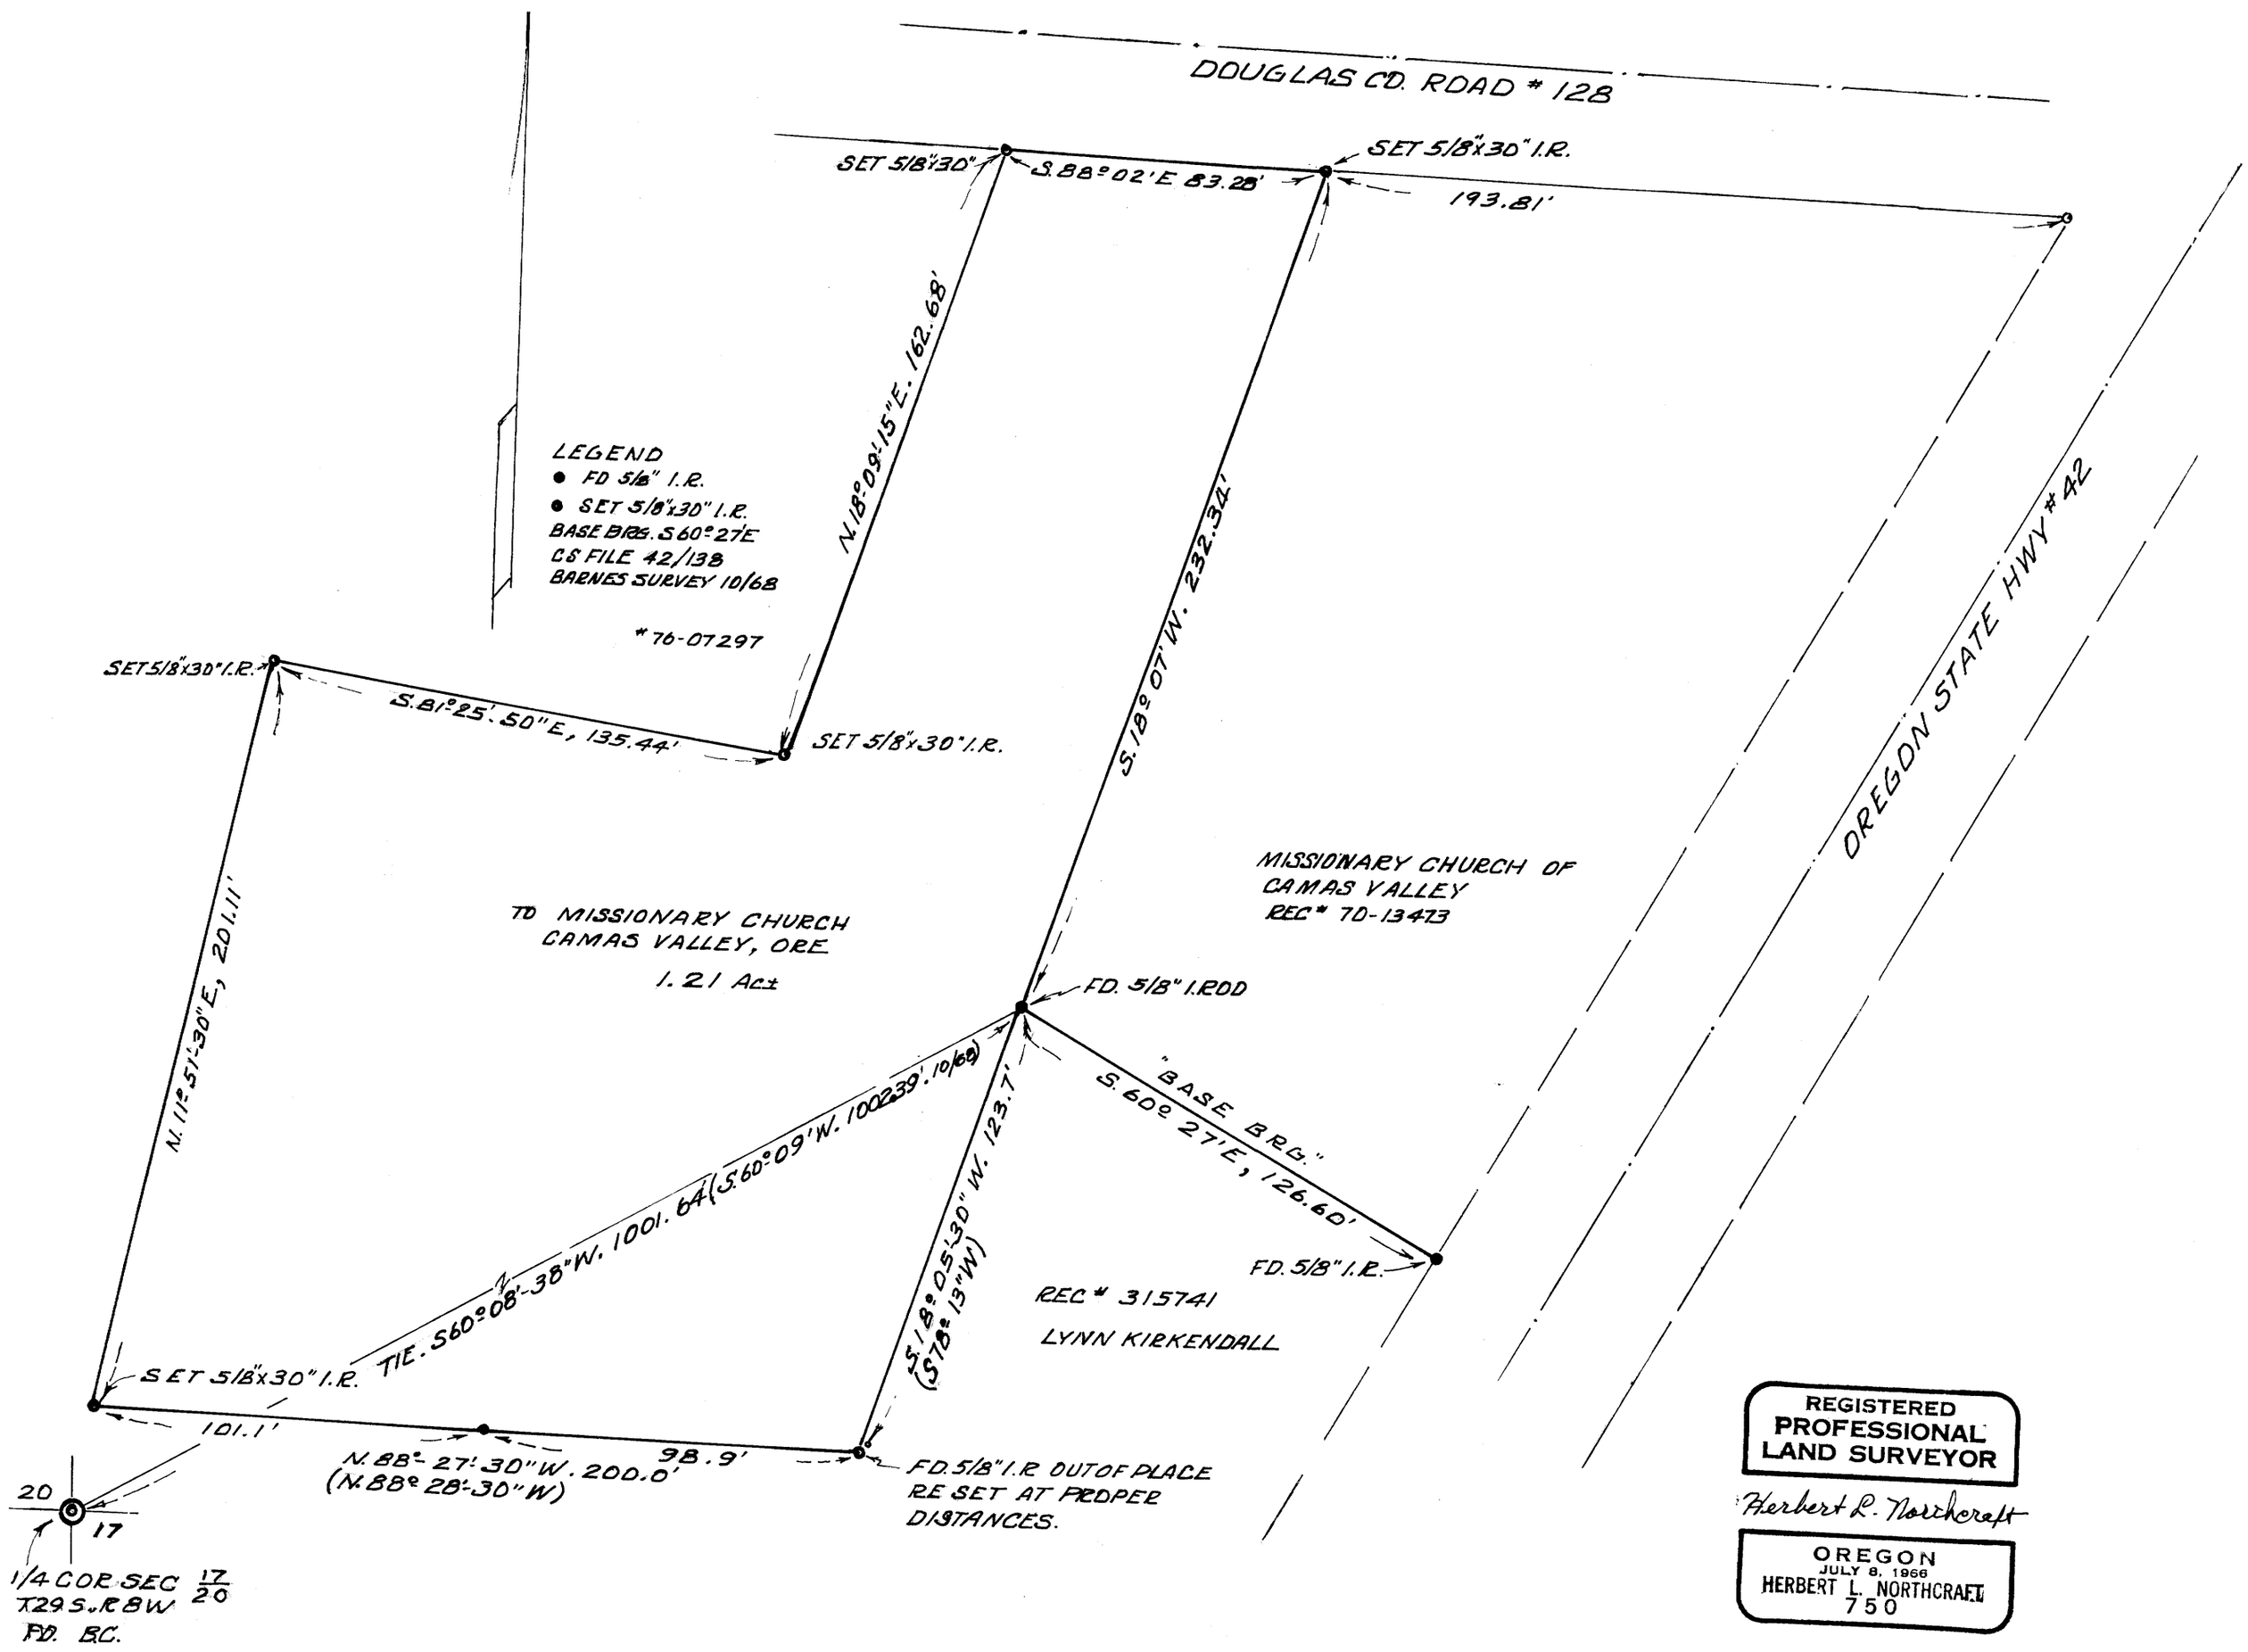

REGISTERED
PROFESSIONAL
LAND SURVEYOR

Herbert L. Northcraft

OREGON
JULY 8, 1966
HERBERT L. NORTHCRAFT
750

MAP FILE M64-9