MAP FILE M65-10

COUNTY SURVEYORS FILE DATA
DO NOT REMOVE FROM OFFICE

Witness Corner

Fd. 5/8" iron rod with alum. cap.
From which a:

14" Douglas fir BT
Bears S69 1/2°W, 17.3 ft.

12" ash BT
Bears S12 1/2°E, 16.0 ft.

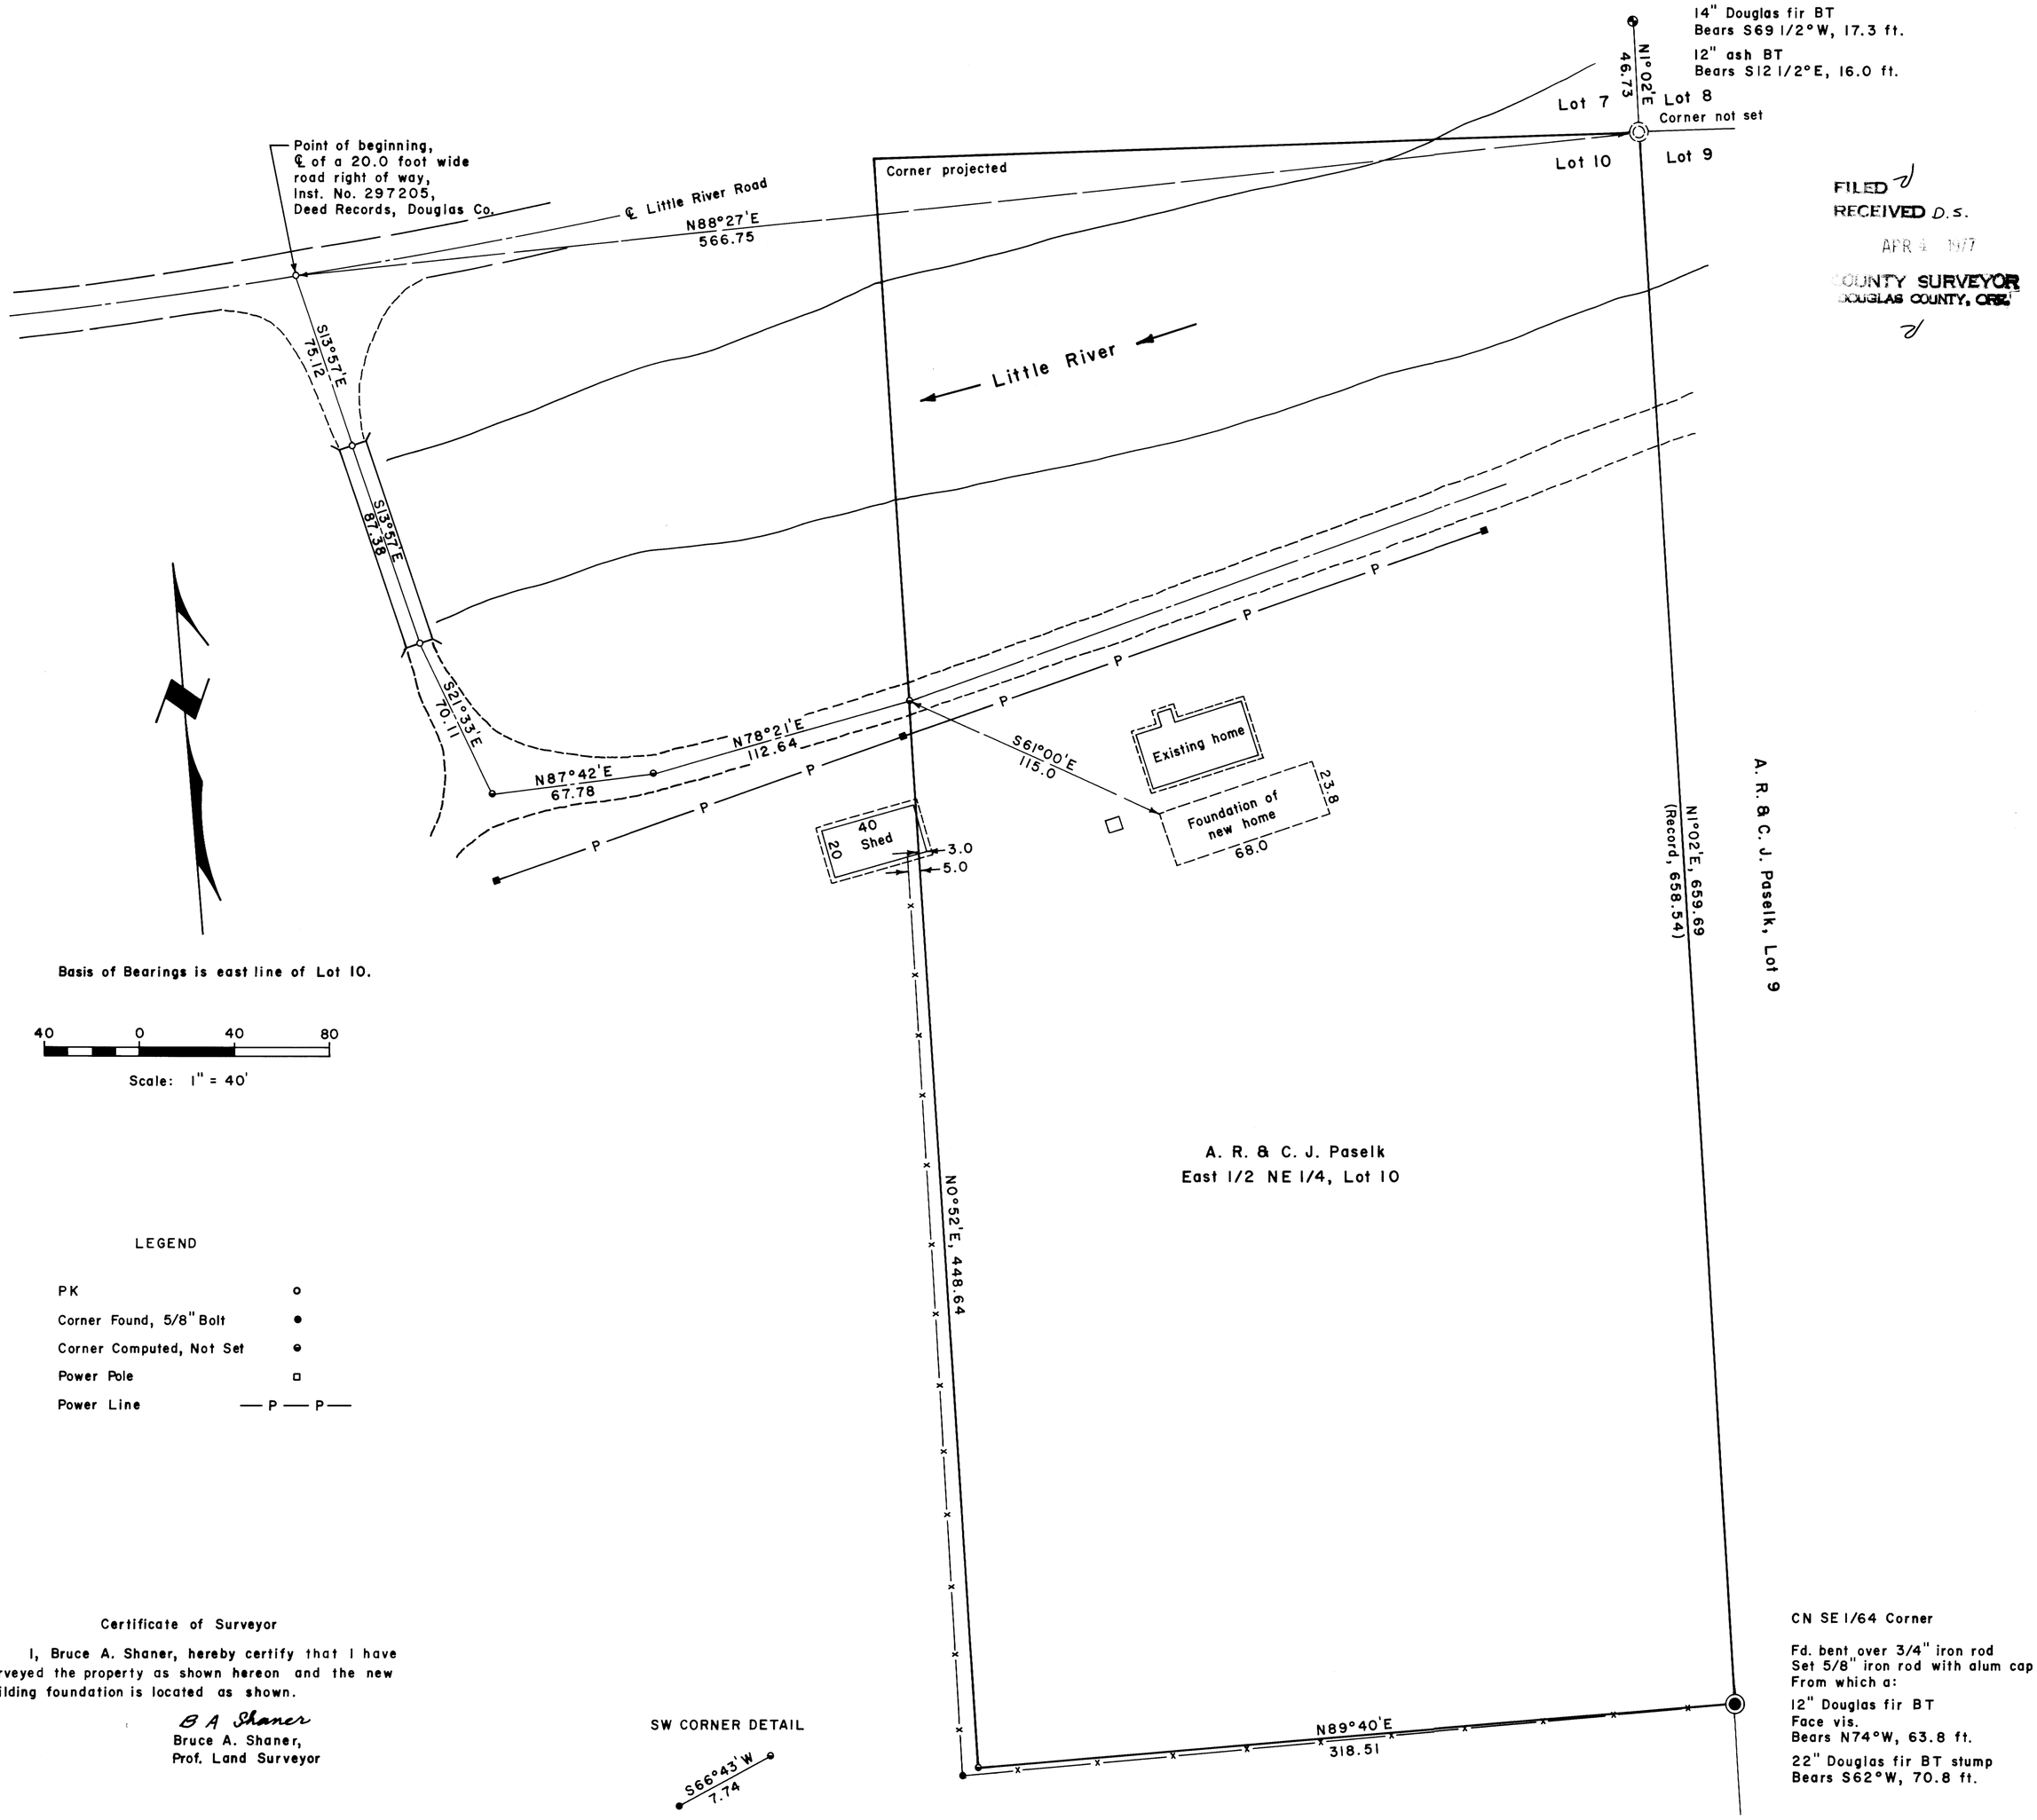

Basis of Bearings is east line of Lot 10.

40 0 40 80

Scale: 1" = 40'

LEGEND

PK	o
Corner Found, 5/8" Bolt	●
Corner Computed, Not Set	⊖
Power Pole	□
Power Line	— P — P —

Certificate of Surveyor

I, Bruce A. Shaner, hereby certify that I have surveyed the property as shown hereon and the new building foundation is located as shown.

B A Shaner
Bruce A. Shaner,
Prof. Land Surveyor

REGISTERED
PROFESSIONAL
LAND SURVEYOR
B A Shaner
OREGON
OCT. 4, 1957
BRUCE A SHANER
430

SW CORNER DETAIL

CN SE 1/64 Corner

Fd. bent over 3/4" iron rod
Set 5/8" iron rod with alum cap
From which a:

12" Douglas fir BT
Face vis.
Bears N74°W, 63.8 ft.

22" Douglas fir BT stump
Bears S62°W, 70.8 ft.

FILED
RECEIVED D.S.
APR 4 1977
COUNTY SURVEYOR
DOUGLAS COUNTY, ORE.

A. L. T. A. & ACCESS EASEMENT SURVEY IN LOT 10, SEC. 12, T. 27 S., R. 3 W., W. M.

For: A. R. & C. J. Paselk

By: Shaner Engineering, Inc.

April 4, 1977

COUNTY SURVEYORS FILE DATA
DO NOT REMOVE FROM OFFICE

MAP FILE M65-10