Survey For U.S. Forest Service
In Sec. 12, T27S, R2W, W.M., Douglas County, Oregon
By: B.H.W., Eng. & Surveying, Inc.
March 1977

FILED
RECEIVED
APR 11 1977
COUNTY SURVEYOR
DOUGLAS COUNTY, ORE.

MAP FILE M45-13

DECL. = 20°
MAGNETIC NORTH

Scale: 1" = 400'

200 100 50 0 100 300 500 700 900

LEGEND

- ◎ — Set Brass Cap
- ⊙ — Found Brass Cap
- ● — Found Aluminum Cap
- ⊕ — Found 2" Iron Pipe
- ◉ — Found 3/4" Iron Pipe
- ( ) — Record Calls (Originals Unless Noted Otherwise)
- ——— True Lines Posted with Steel Fence Posts & Government Property Signs.

Bearings Based on Solar Observation Taken Jan. 24, 1977.

Steel Fence Posts Set within 5.0 Ft. of Each Corner Set or Posted To.

"I, Romanso E. Ware, a registered professional land surveyor in the State of Oregon, hereby certify that this plat and the notes hereon, or attached, are a correct representation of a survey I performed during December, 1976 — March, 1977, for the U.S. Forest Service, in accordance with the statutes of the State of Oregon and with the Articles of my contract."

Romanso E. Ware
Romanso E. Ware
Registered Professional Land Surveyor
Oregon License No. 1005

REGISTERED PROFESSIONAL LAND SURVEYOR
Romanso E. Ware
OREGON JULY 14, 1972 ROMANSO E. WARE 1005

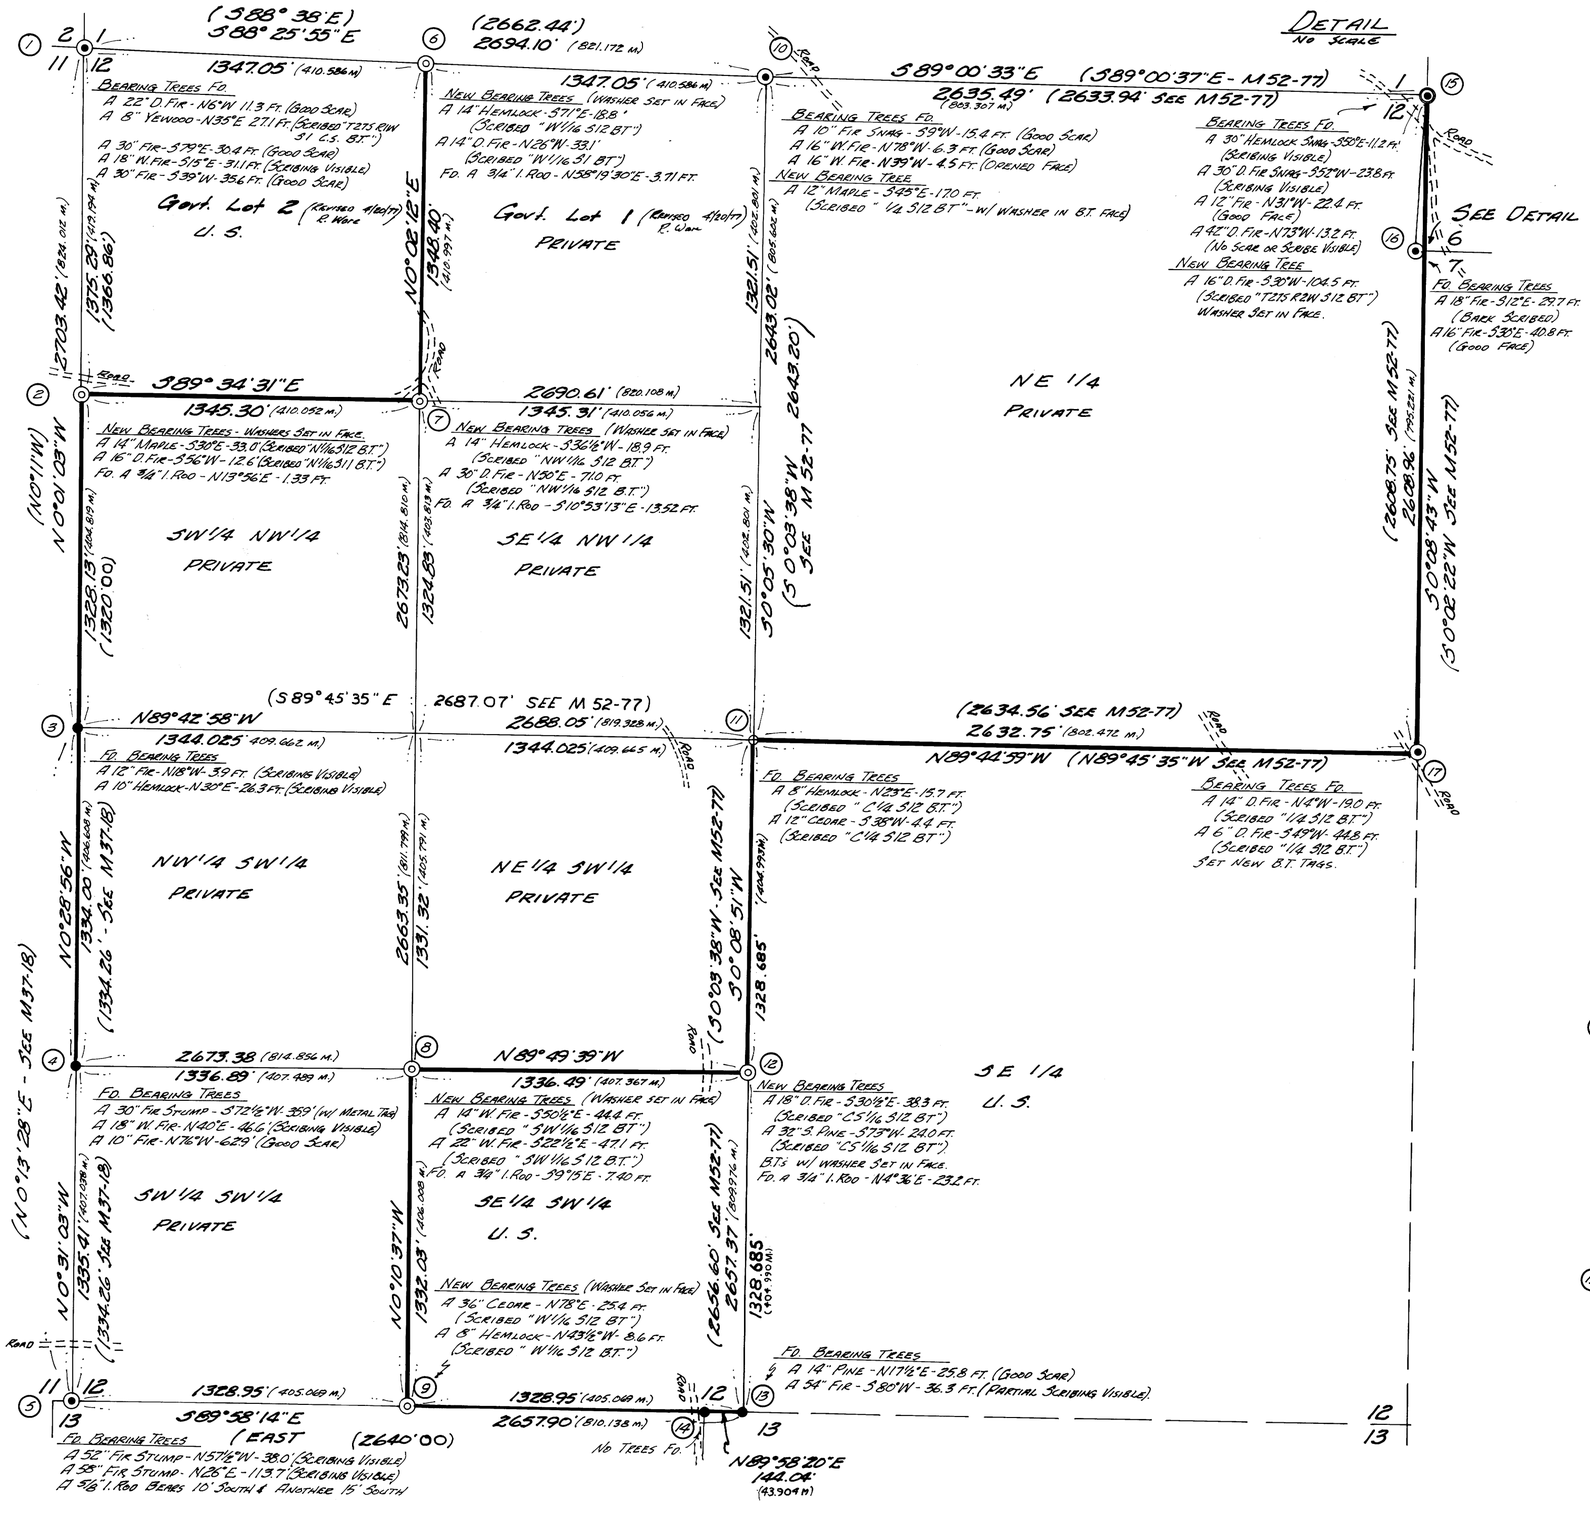

DETAIL
No Scale

1. Fd. Brass Cap Set by Douglas County Surveyors Office
2. Set 2 1/2" x 30" I.P. with Brass Cap
3. Fd. U.S. Plywood Corp. Aluminum Cap on 3/4" I. Rod.
4. Fd. U.S. Plywood Corp. Aluminum Cap on 1" I. Rod with 3/4" I. Rod Along Side.
5. Fd. Brass Cap Set by County Surveyors Office with Fence Post Alongside.
6. Set 2 1/2" x 30" I.P. with Brass Cap
7. Set 2 1/2" x 30" I.P. with Brass Cap
8. Set 2 1/2" x 30" I.P. with Brass Cap
9. Set 2 1/2" x 30" I.P. with Brass Cap
10. Fd. Brass Cap Set by Douglas County Surveyor's Office
11. Fd. A 2" I. Pipe with Wooden Plug (8" Above Ground) Set by Glen Baughman (See M52-77) Center 1/4 Section 12.
12. Set 2 1/2" x 30" I.P. with Brass Cap
13. Fd. Brass Cap on 1" I. Pipe 8" Above Ground.
14. Fd. Aluminum Cap on 3/4" I. Rod Post & Signs 3.0 West.
15. Fd. 3/4" I. Pipe 6" Above Ground with Rock on South Side.
16. Fd. Brass Cap on 1" I. Pipe 8" Above Ground.
17. Fd. Brass Cap on 1" I. Pipe 8" Above Ground in Rock Mound.

GLIDE LAND SURVEY No. 4 - Contract No. 006258.N

MAP FILE M45-13

COUNTY SURVEYOR'S FILE DATA