L1 - 59.W

COUNTY SURVEYORS FILE DATA
DO NOT REMOVE FROM OFFICE

FILED
RECEIVED JRL
MAY 16 1977
COUNTY SURVEYOR
DOUGLAS COUNTY, ORE.

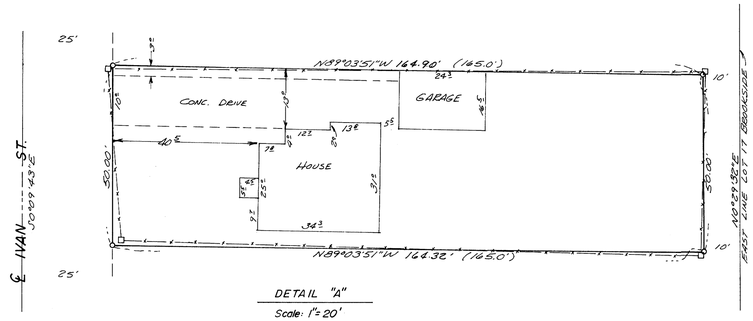

DETAIL "A"
Scale: 1"=20'

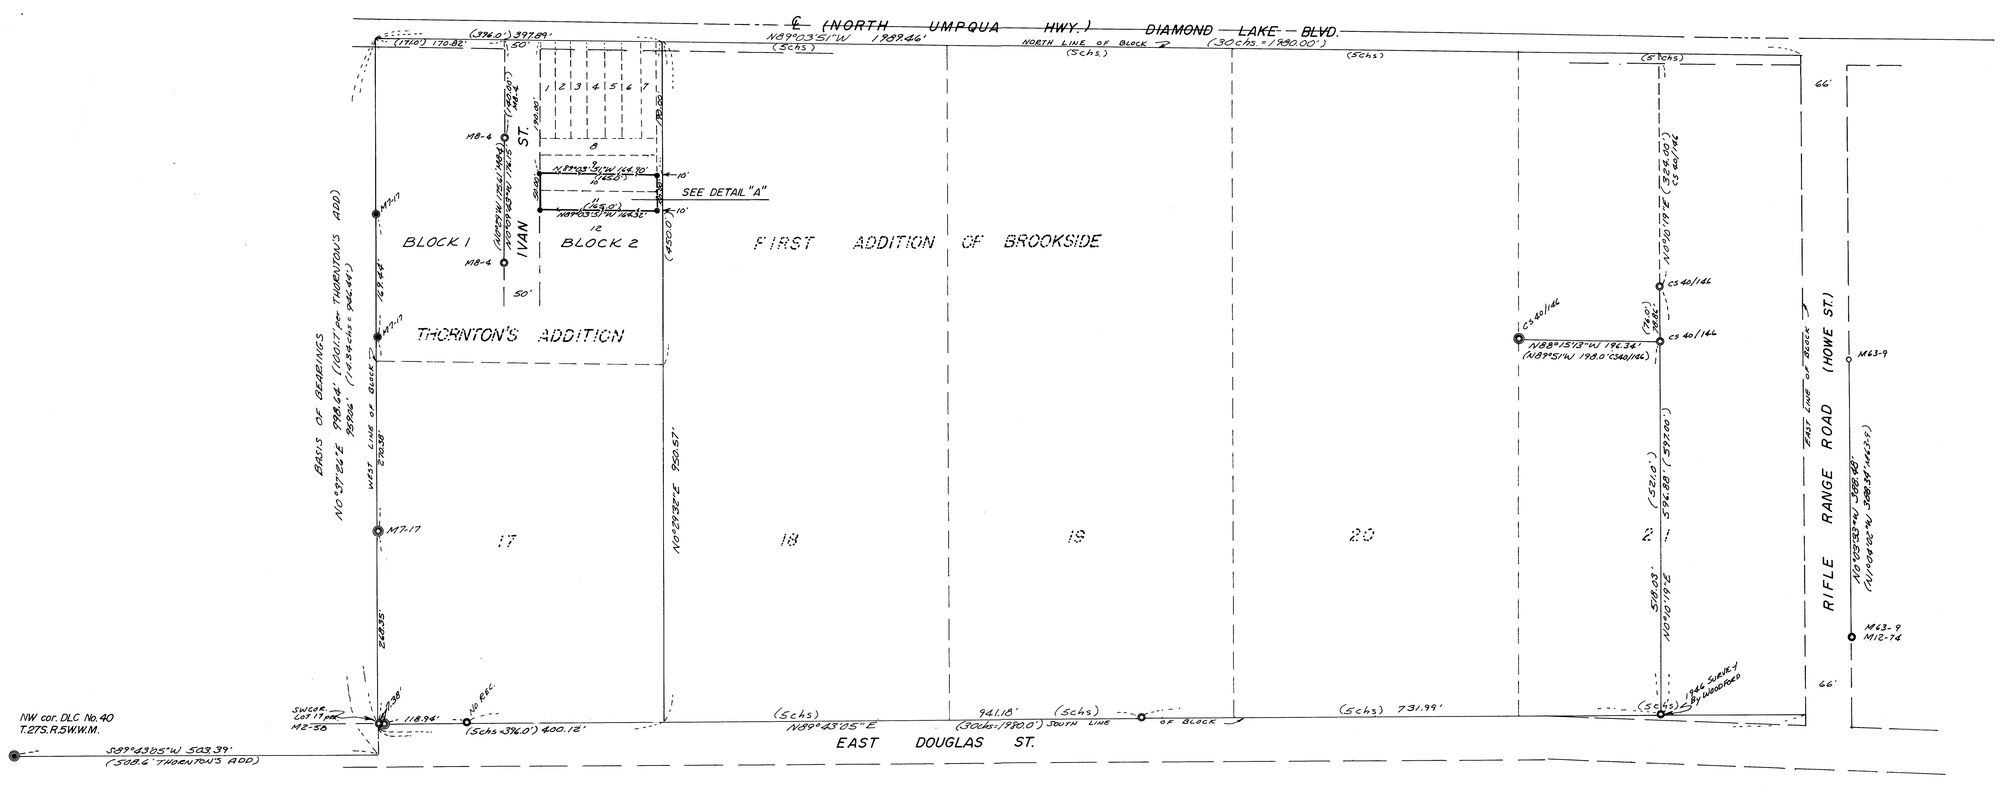

Based on West Line Lot 17, Brookside

LEGEND

- Set 1/2" iron rod
- Found 5/8" iron rod
- Found 1/2" iron pipe
- Found 3/4" iron pipe
- Found 1/2" iron rod
- Found 3/4" iron rod
- Found 1-1/2" iron pipe

REGISTERED PROFESSIONAL LAND SURVEYOR
OREGON
JULY 9, 1971
GLEN E. BAUGHMAN
R.L.S.

COUNTY SURVEYORS FILE DATA
DO NOT REMOVE FROM OFFICE

SURVEY TO SET PROPERTY CORNERS FOR PLUNKETT

IN LOTS 10 & 11, BLK. 2, THORNTONS ADDITION — SEC. 20, T.27S.R.5W.W.M. SEC. 19

SCALE 1"=100'

DRAWN BY Eab

REVISED

C & G ENG., INC, P.O.BOX 222, ROSEBURG, OREGON

DATE	APPROVED BY	DRAWING NUMBER
MAY 1977		6140.0027

K+E CRYSTALENE ® 10 9458
ARCHITECTS' STANDARD FORM

MADE IN U.S.A.

M 65 - 19