COUNTY SURVEYORS FILE DATA
DO NOT REMOVE FROM OFFICE

FILED
RECEIVED
JUN 1 1977
COUNTY SURVEYOR
DOUGLAS COUNTY, ORE.

Survey For U.S. Forest Service
In Sec. 24, T27S, R2W, W.M., Douglas County, Oregon
By: B.H.W., Eng. & Surveying, Inc.
May, 1977

Scale: 1" = 400'

200 100 50 0 100 300 500 700 900

DECL. = 20°
MAGNETIC NORTH

LEGEND

◎ — SET BRASS CAP

⊙ — FOUND BRASS CAP

( ) — RECORD CALLS (ORIGINALS UNLESS NOTED OTHERWISE)

——— TRUE LINES POSTED WITH STEEL FENCE POSTS & GOVERNMENT PROPERTY SIGNS.

BEARINGS BASED ON SOLAR OBSERVATION TAKEN JAN. 24, 1977.

STEEL FENCE POSTS SET WITHIN 5.0 FT OF EACH CORNER SET OR POSTED TO.

WASHERS ATTACHED TO BT FACE OF ALL NEW BT's

"I, Romanso E. Ware, a registered professional land surveyor in the State of Oregon, hereby certify that this plat and the notes hereon, or attached, are a correct representation of a survey I performed during December, 1976-- May, 1977, for the U.S. Forest Service, in accordance with the statutes of the State of Oregon and with the Articles of my contract."

Romanso E. Ware
ROMANSO E. WARE
REGISTERED PROFESSIONAL LAND SURVEYOR
OREGON LICENSE No. 1005

REGISTERED PROFESSIONAL LAND SURVEYOR
Romanso E. Ware
OREGON
NOV. 19, 1973
ROMANSO E. WARE
1005

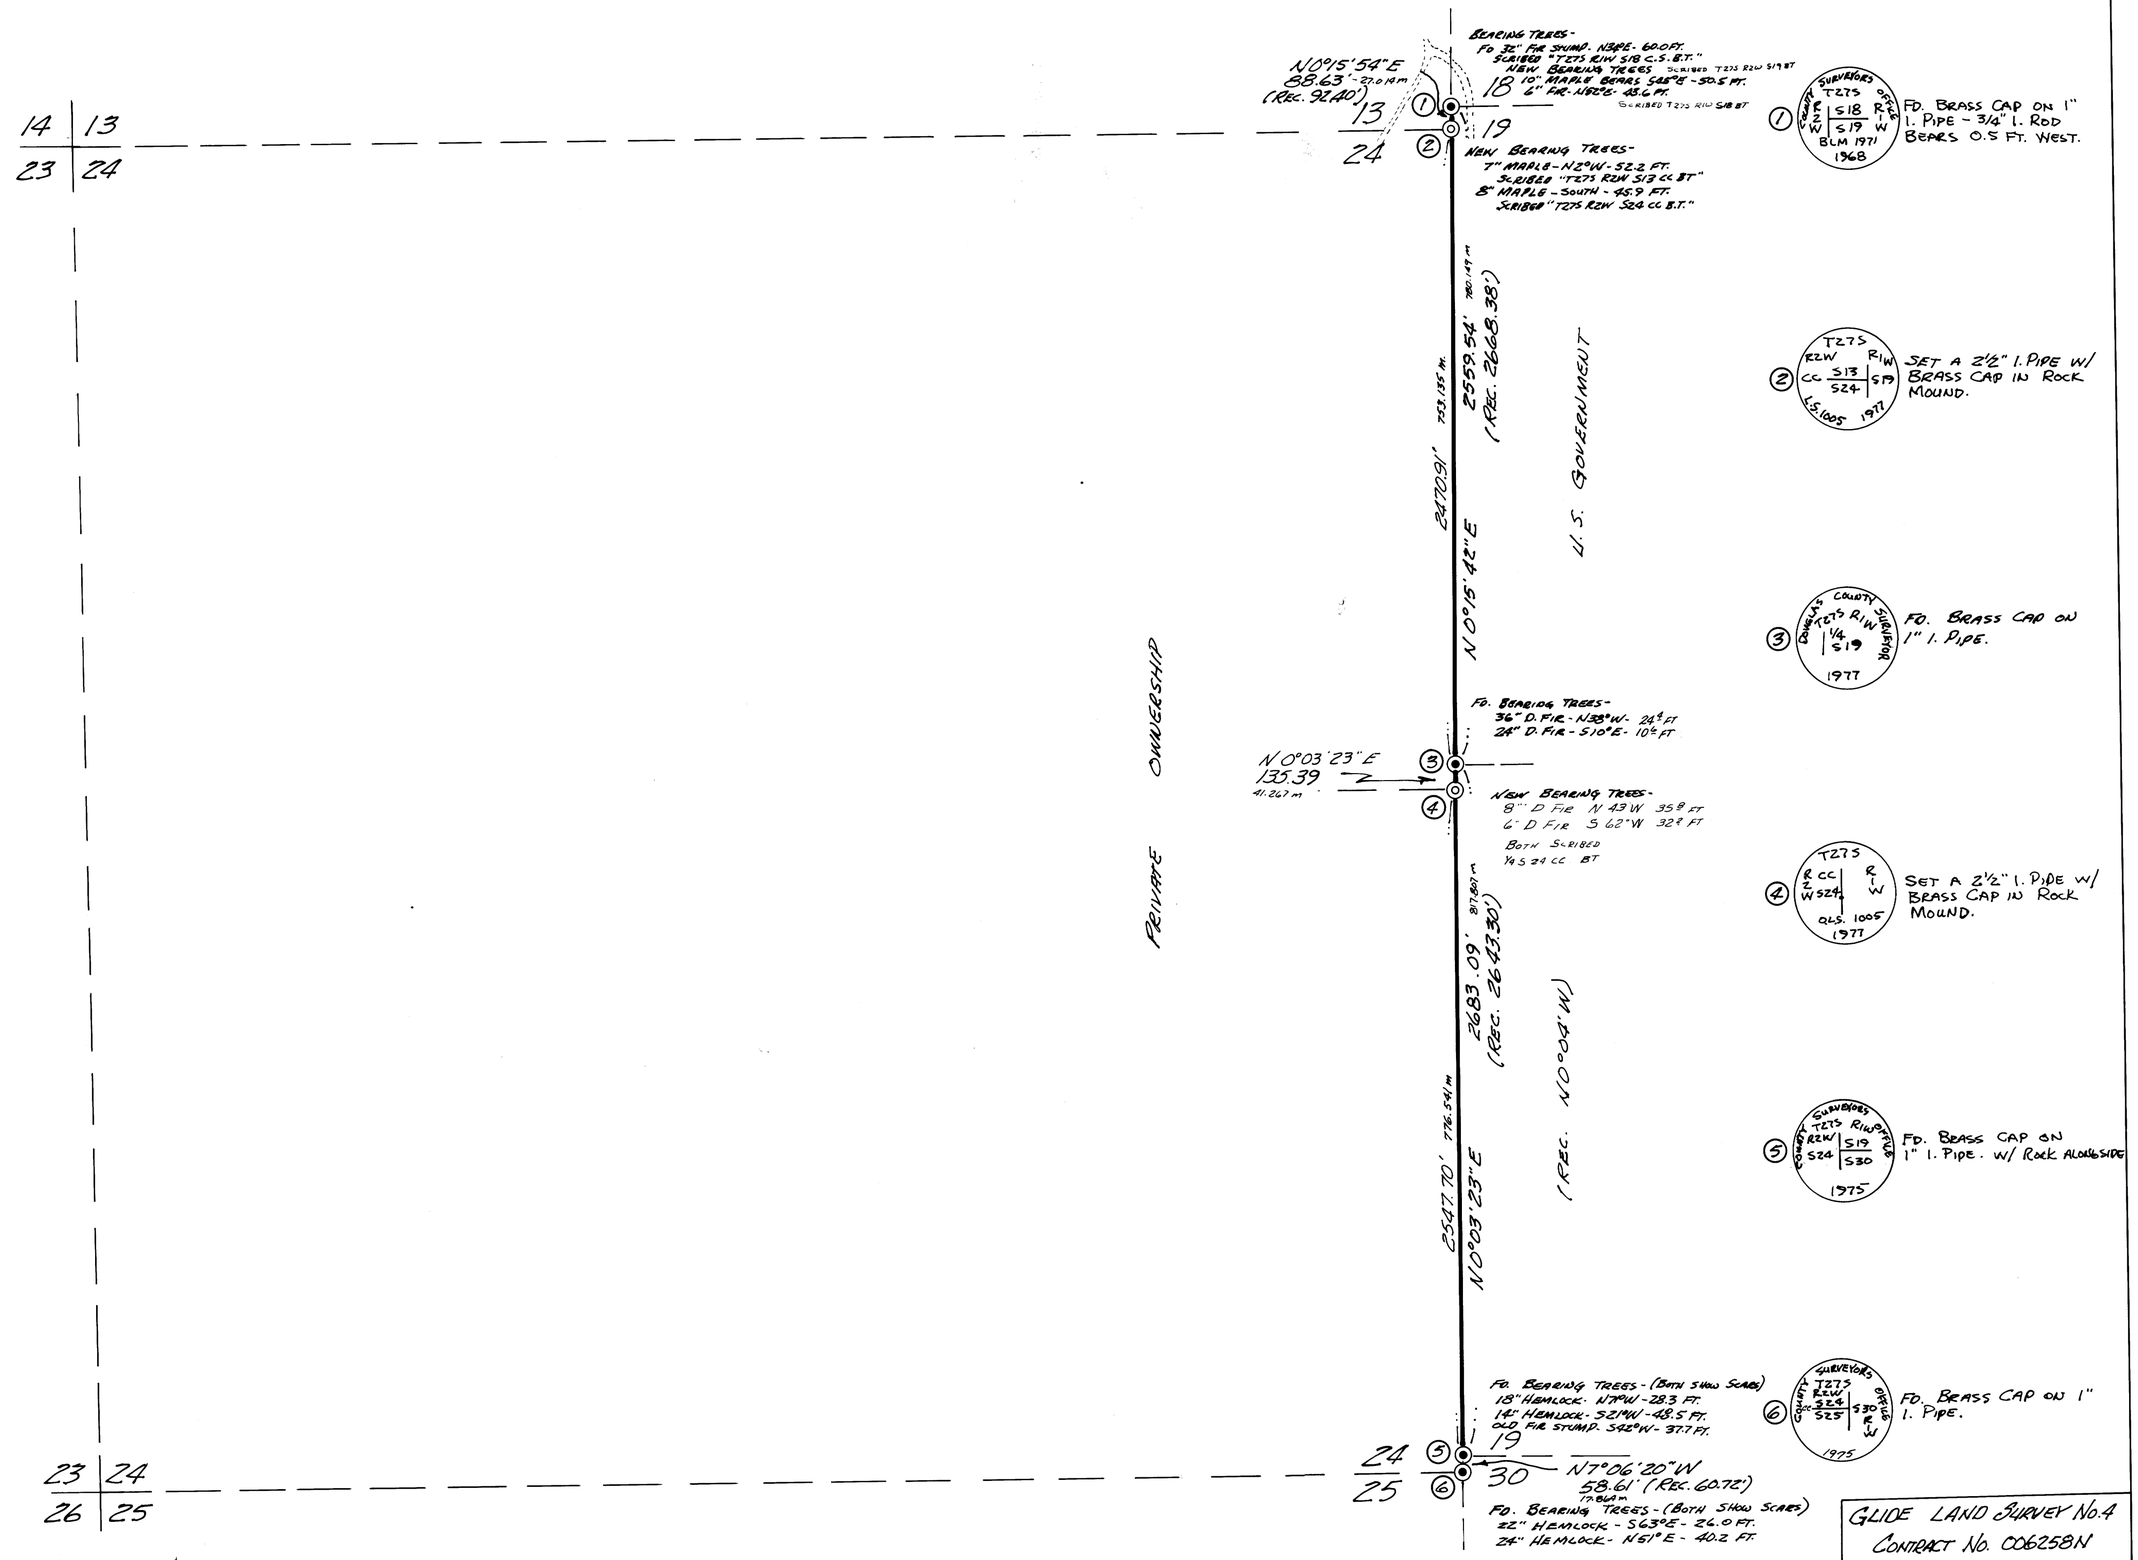

GLIDE LAND SURVEY No. 4
CONTRACT No. 006258N

COUNTY SURVEYORS FILE DATA
DO NOT REMOVE FROM OFFICE

MAP FILE 65 - 19