MAP FILE M 65-3

COUNTY SURVEYORS FILE DATA
DO NOT REMOVE FROM OFFICE

SURVEY FOR FUGATE BROS. LOGGING, INC.
IN SECTION 32, T.28S. R.7W.W.M.
BY: C & G ENG., INC.

FEBRUARY 1977 SCALE: 1" = 400'

FILED
RECEIVED
MAR 2 1977
COUNTY SURVEYOR
DOUGLAS COUNTY, ORE.
MC

BASED ON RM 2-46

LEGEND

- Set 5/8" iron rod
- Found 5/8" iron rod
- Found 1/2" iron pipe
- Found 1" iron pipe
- Found Brass cap

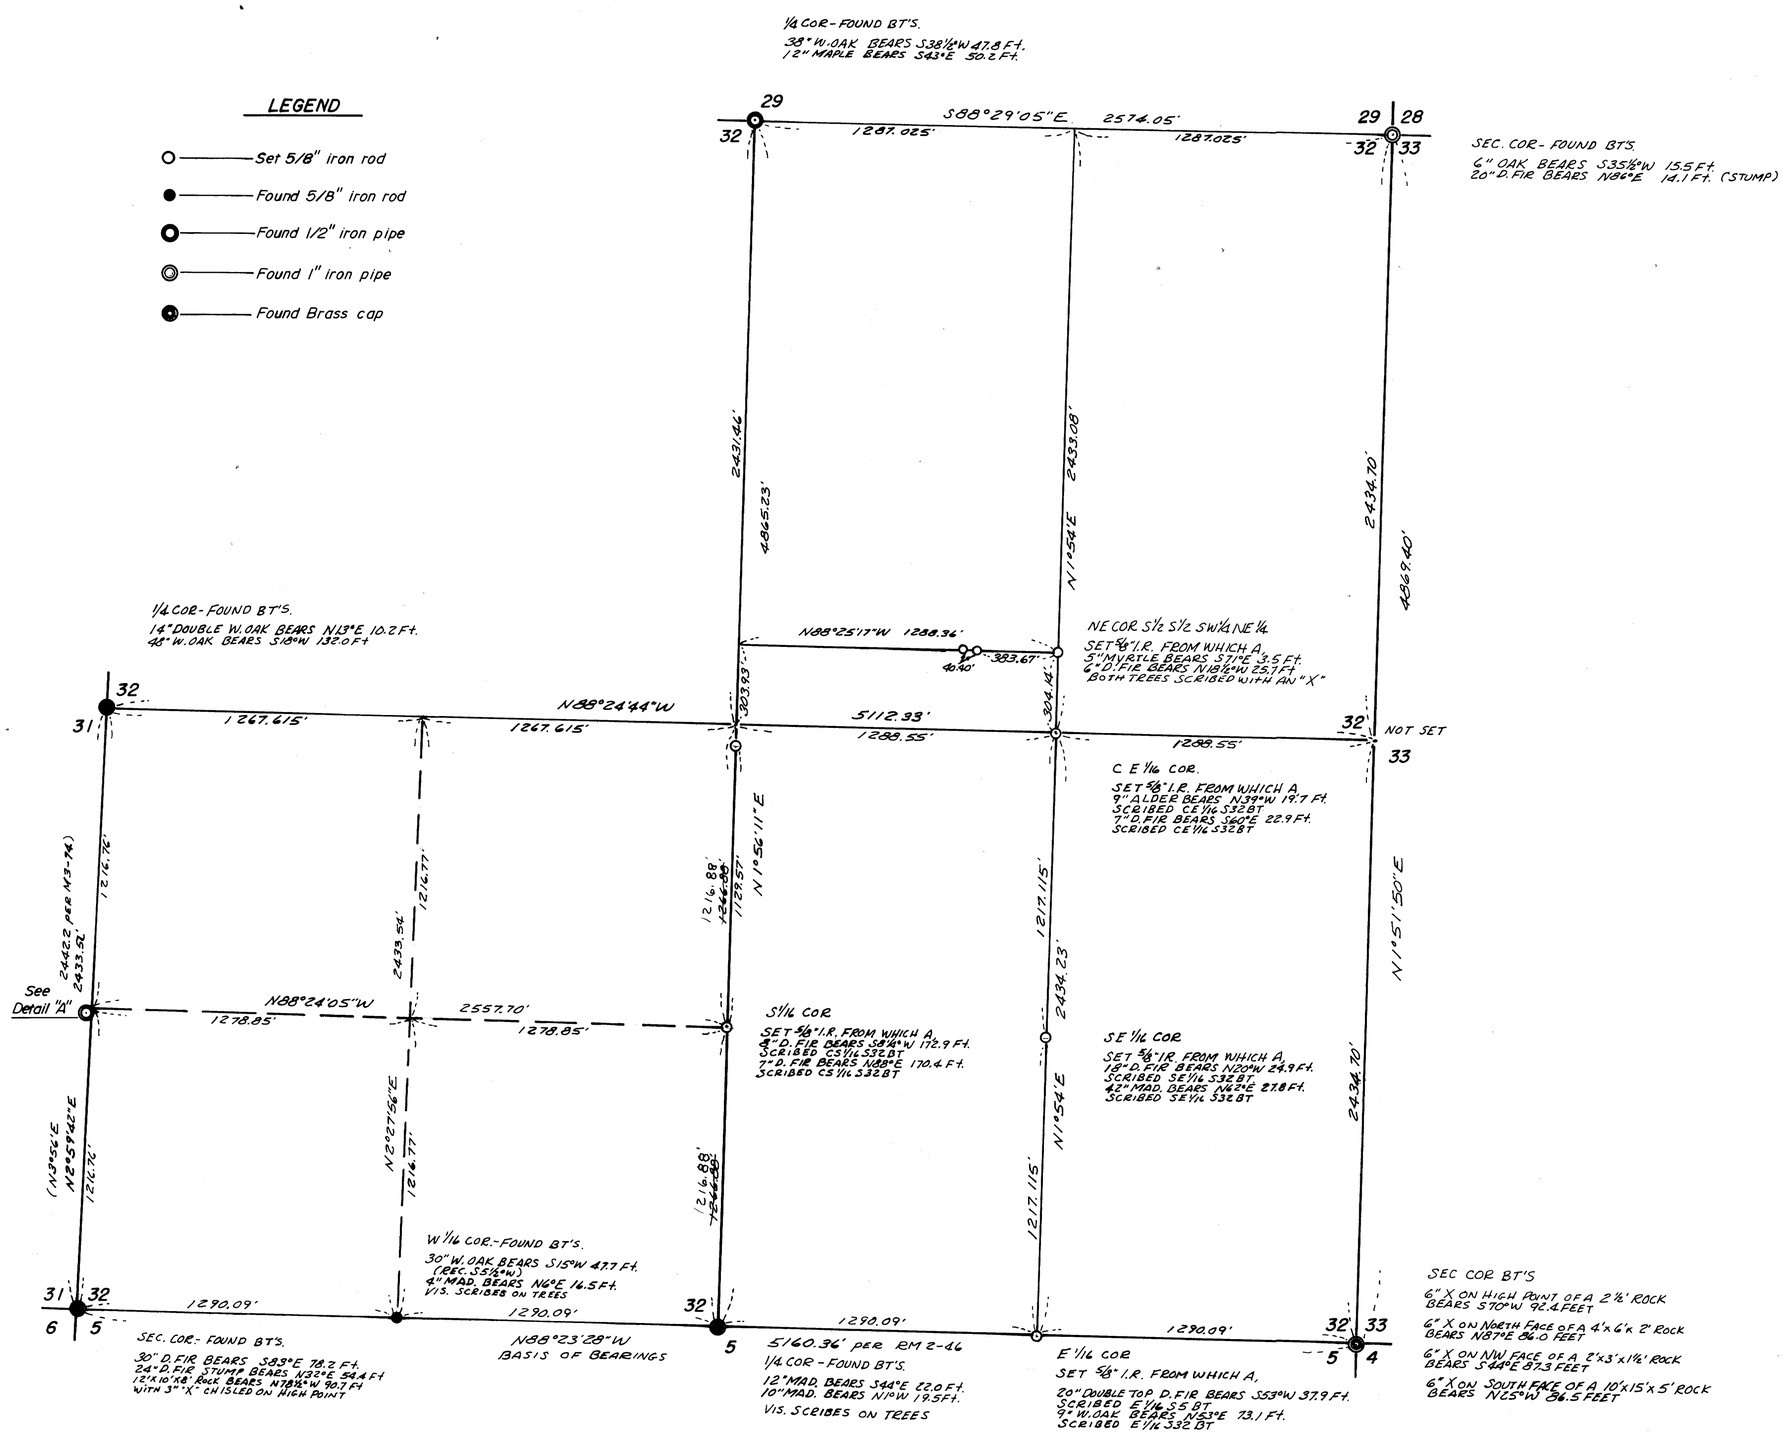

DETAIL "A"
no scale

REGISTERED
PROFESSIONAL
LAND SURVEYOR
OREGON
JULY 14, 1961
GLENN S. BAUGHMAN
536

6150.0007

COUNTY SURVEYORS FILE DATA
DO NOT REMOVE FROM OFFICE

MAP FILE M 65-3