MAP FILE M65-40

COUNTY SURVEYORS FILE DATA
DO NOT REMOVE FROM OFFICE

SURVEY IN SEC. 33, T25S, R7W, W.M.

SURVEY FOR WALLY DINSMORE & ARCHIE CLARNO
SURVEY BY BHW ENGR. & SURVEYING, INC.

AUGUST 1977

FILED
RECEIVED
SEP 8 1977
COUNTY SURVEYOR
DOUGLAS COUNTY, ORE.

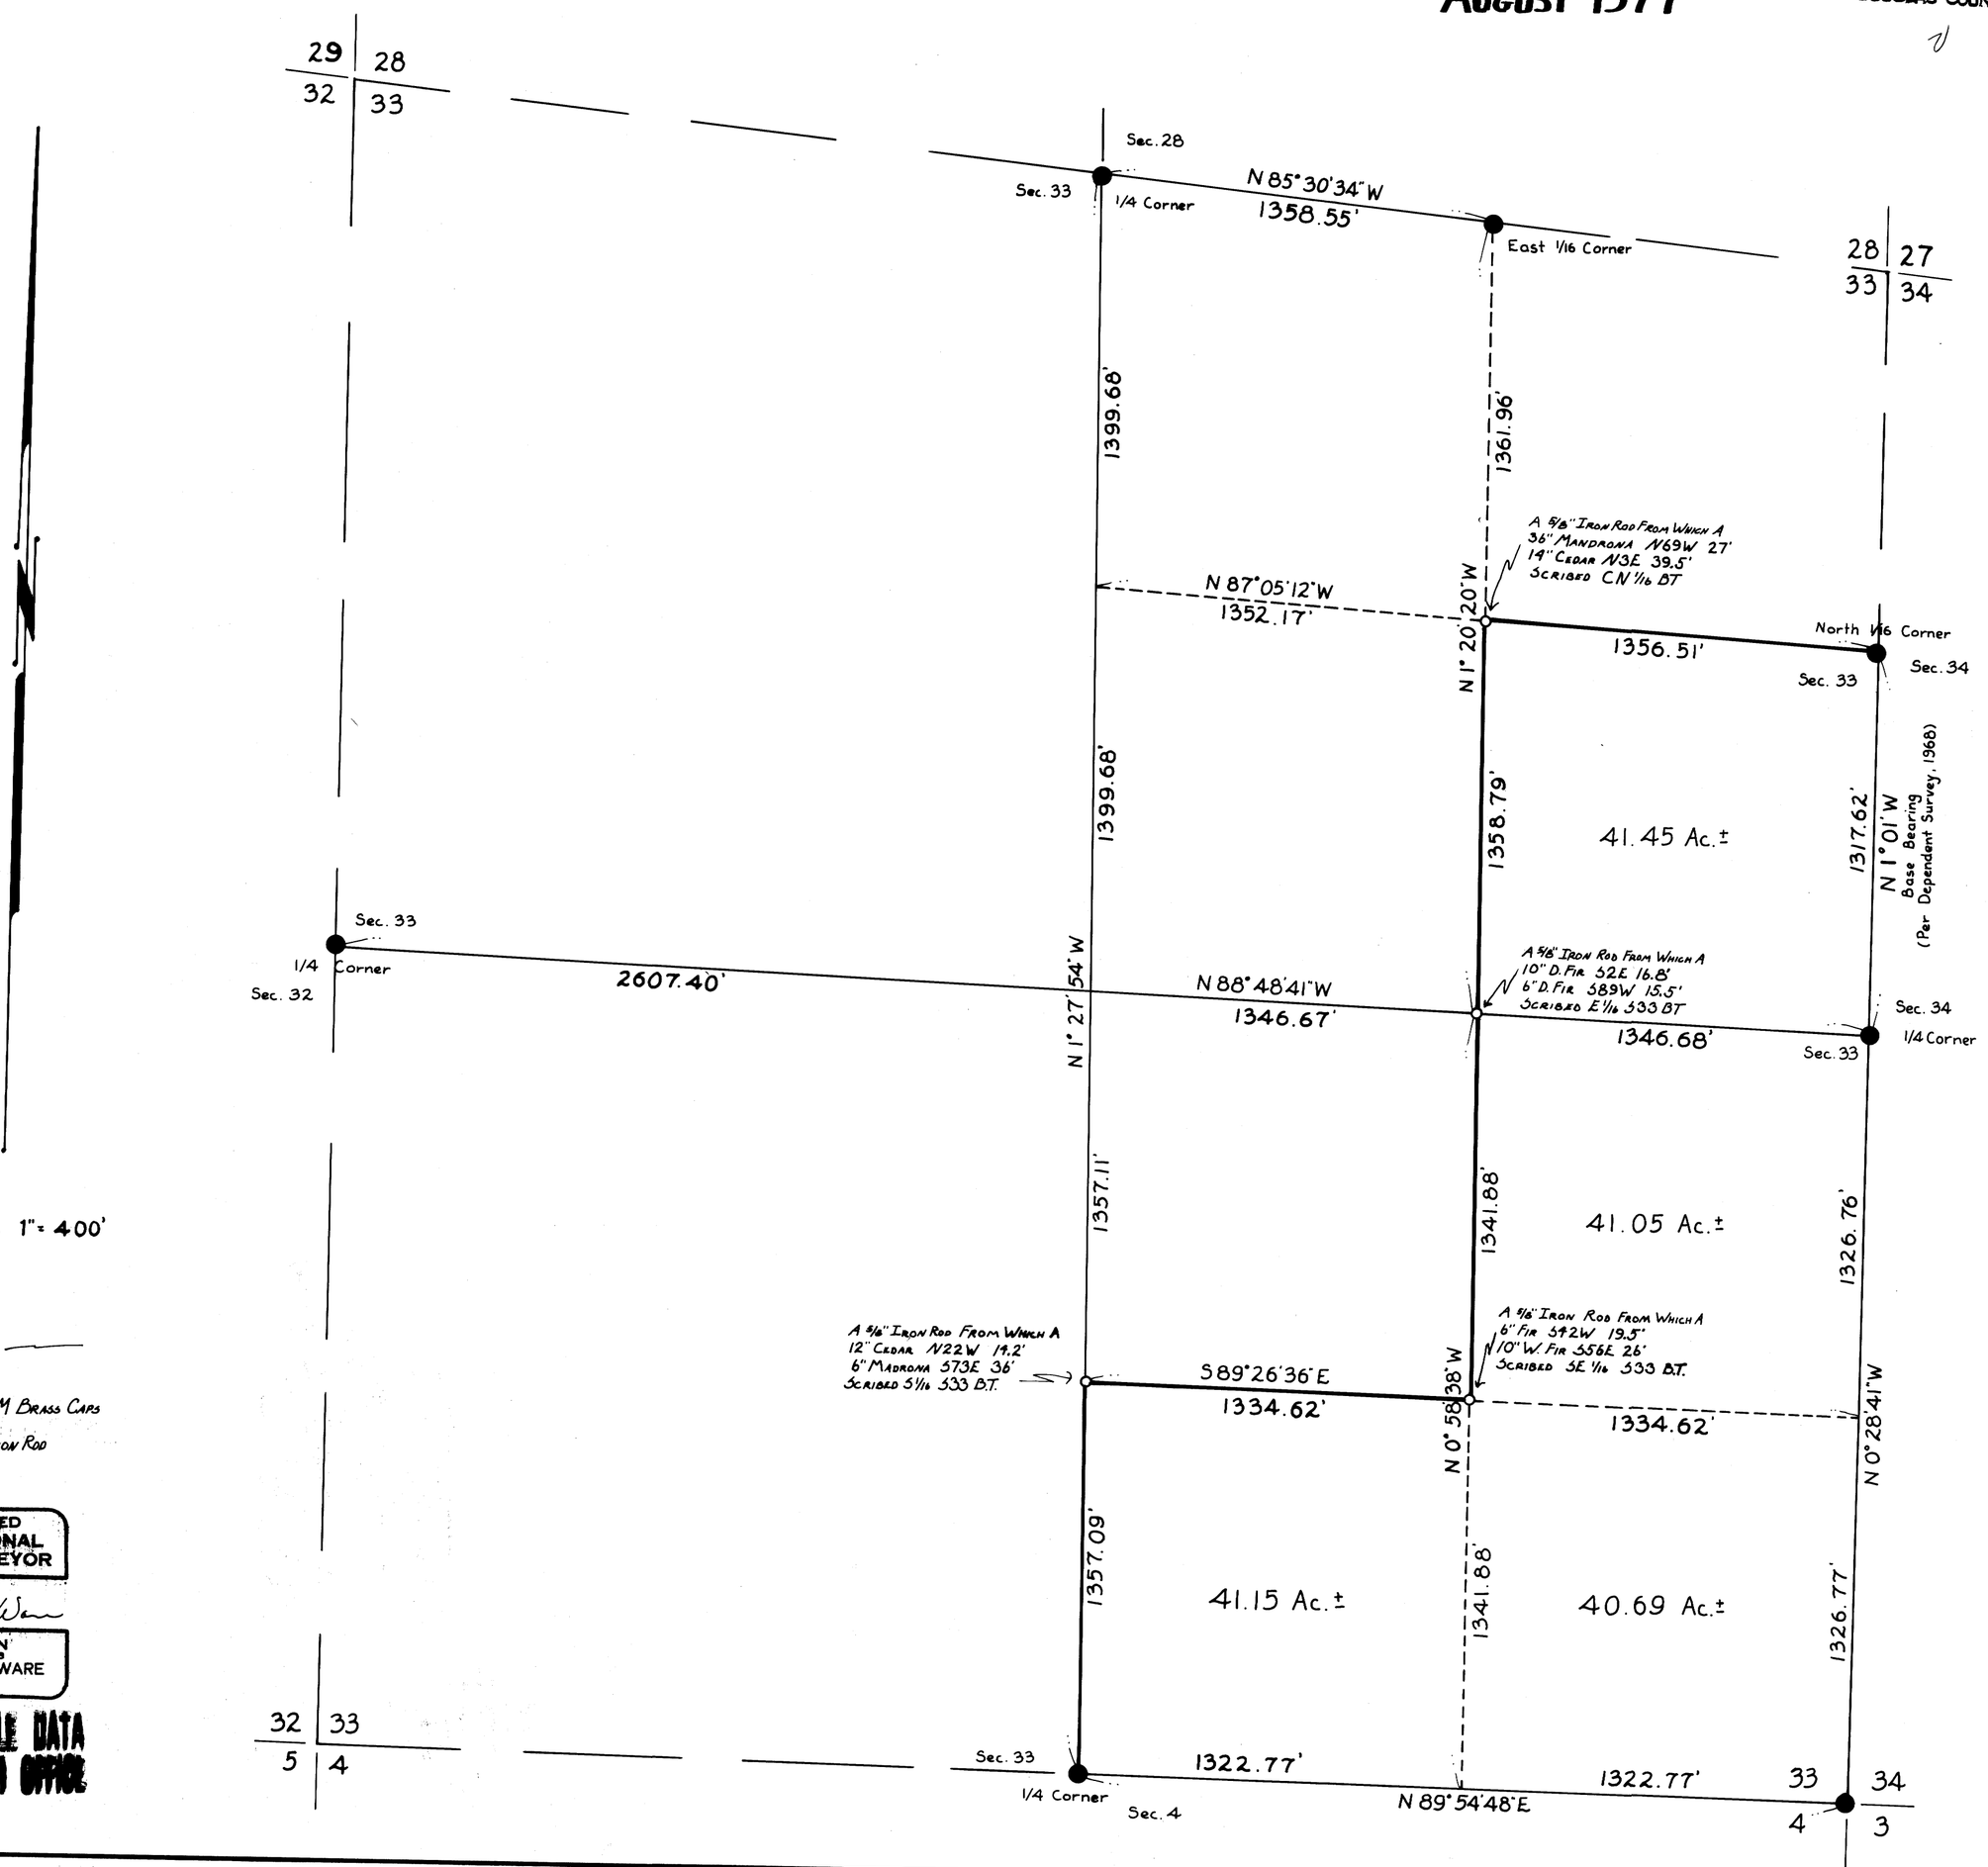

SCALE 1" = 400'

LEGEND

● - Found BLM Brass Caps

○ - Set 5/8" Iron Rod

REGISTERED
PROFESSIONAL
LAND SURVEYOR

Romanso E. Ware

OREGON
NOV. 16, 1973
ROMANSO E. WARE
1005

COUNTY SURVEYORS FILE DATA
DO NOT REMOVE FROM OFFICE

MAP FILE M65-40