MAP FILE M65-42

COUNTY SURVEYORS FILE DATA
DO NOT REMOVE FROM OFFICE

FILED
RECEIVED
SEP 26 1977
COUNTY SURVEYOR
DOUGLAS COUNTY, ORE.

MAP FILE M65-42

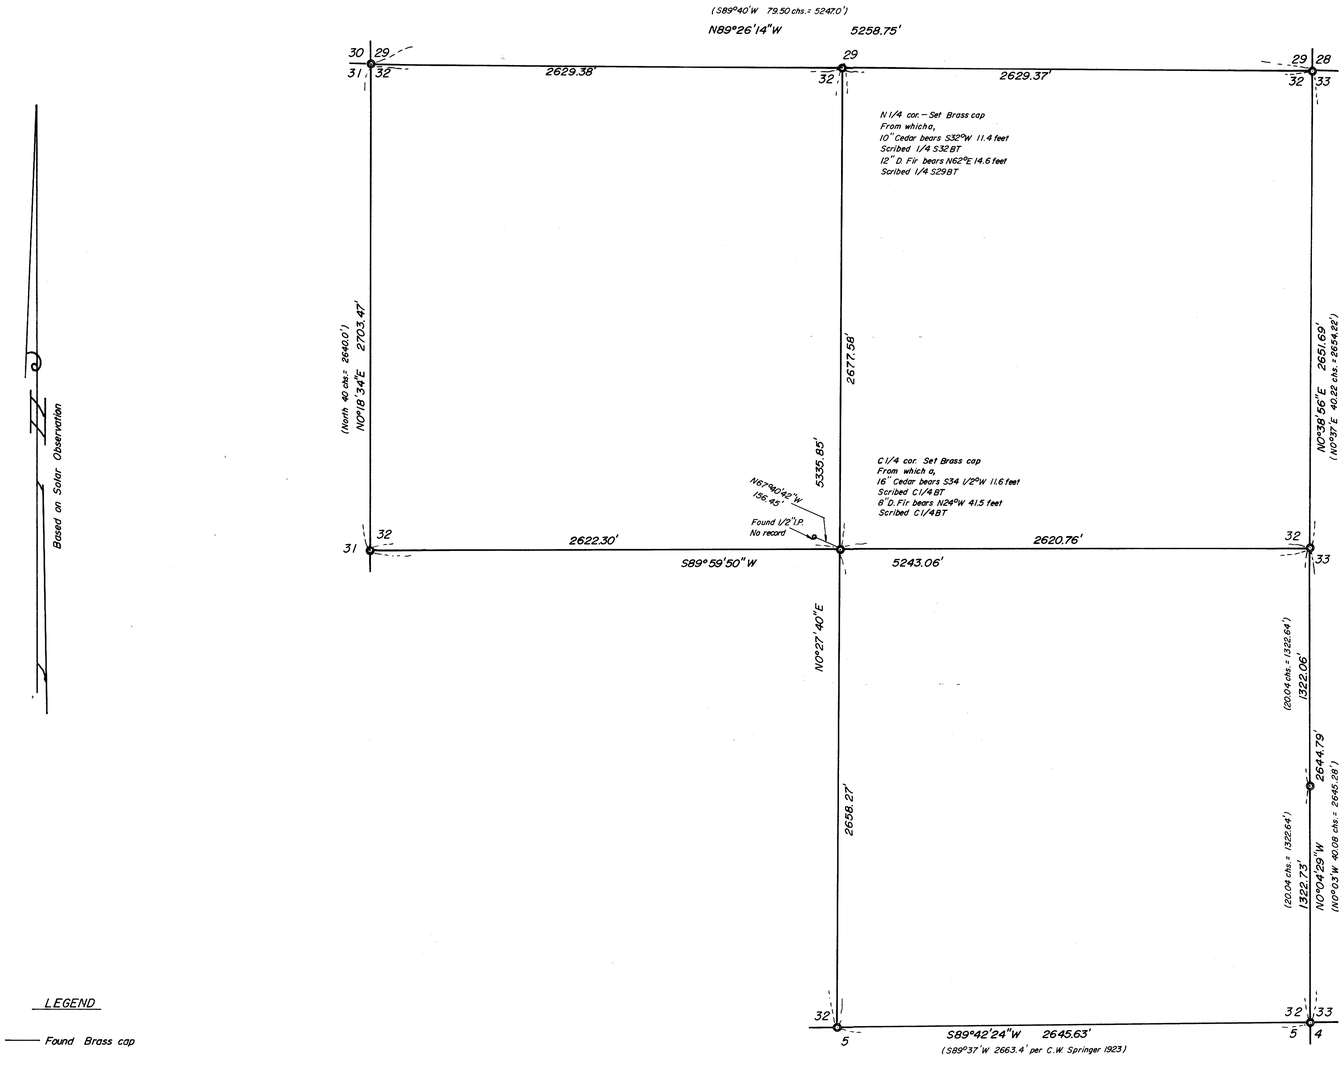

LEGEND

- Found Brass cap
- Set Brass cap

REGISTERED
PROFESSIONAL
LAND SURVEYOR
OREGON
JULY 14, 1961
GLENN S. BAUCHMAN
536

COUNTY SURVEYORS FILE DATA
DO NOT REMOVE FROM OFFICE

SURVEY IN SECTION 32, T.29S. R.3W.W.M.		
FOR: JOHN WESTHEIMER	SCALE 1"=400'	DRAWN BY Eab / REVISED
C & G ENGINEERING INC. – ROSEBURG, OREGON		
DATE Aug. 1977	APPROVED BY	DRAWING NUMBER 6150.0051

K+E CRYSTALENE © 10 9458
ARCHITECTS' STANDARD FORM
MADE IN U.S.A.
MAP FILE M65-42