COUNTY SURVEYORS FILE DATA
DO NOT REMOVE FROM OFFICE

MAP FILE M65 - 47

FILED
RECEIVED
OCT 26 1977
COUNTY SURVEYOR
DOUGLAS COUNTY, ORE.

RECORD OF SURVEY

FOR

DOUG SMITH

LOCATED:
IN THE E½ SEC. 24, T.21S., R.5W., W.M., AND THE W½ SEC. 19, T.21S., R.4W., W.M., DOUGLAS, COUNTY, OREGON

JUNE, 1977

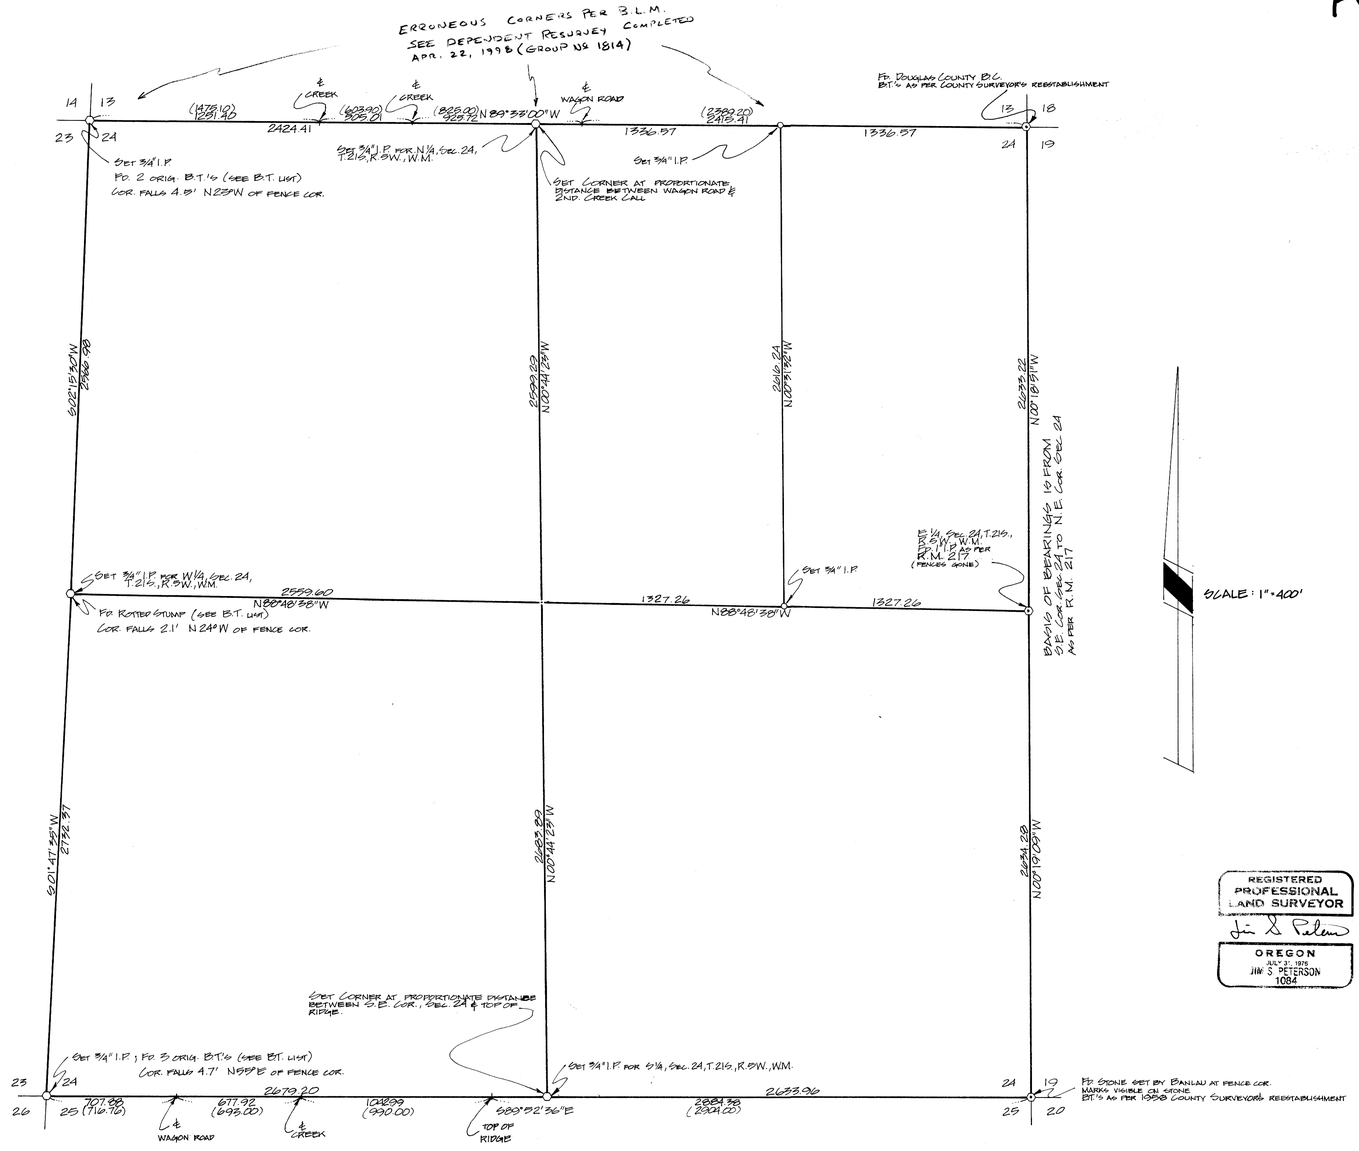

REGISTERED PROFESSIONAL LAND SURVEYOR
OREGON
JULY 27, 1976
JIM S. PETERSON
1084

BEARING TREE LIST

N.W. COR. SEC. 24				SCRIBING
1. 8" Douglas Fir	N 60°E	36.8'	TO CENTER	S 13 BT
2. 14" Douglas Fir	S 54°E	20.6'	TO CENTER	S 24 BT
3. 12" Douglas Fir	S 80°W	26.5'	TO CENTER	S 23 BT
4. 12" Douglas Fir	N 20°W	4.7'	TO CENTER	S 14 BT
ORIGINAL B.T.'S				
1. Rotted Fir Stump	N 87°15'W	56.76' (N 74°W 56.76')		
2. 80" Douglas Fir	S 68°58'E	71.28' (S 72°E 71.28')		

S.W. COR., SEC. 24				
1. 14" Douglas Fir	N 83°E	19.5'	TO CENTER	S 24 BT
2. 12" Douglas Fir	S 16°E	12.3'	TO CENTER	S 25 BT
3. 14" Douglas Fir	S 45°W	48.5'	TO CENTER	S 26 BT
4. 8" Douglas Fir	N 57°W	29.1'	TO CENTER	S 25 BT
ORIGINAL B.T.'S				
1. 60" Douglas Fir.	N 9°18'W	221.08' (N 09°W 220.44')		
2. Rotted Fir Stump (scribing visible)	N 63°54'E	81.24' (N 72°E 81.84')		
3. Rotted Fir Stump	S 59°18'E	160.17' (S 61°E 159.72')		

W 1/4 SEC. 24				
1. 12" Douglas Fir	N 68°E	9.3'	TO CENTER	1/4 S 24 BT
2. 12" Douglas Fir	S 81°W	12.4'	TO CENTER	1/4 S 25 BT
ORIGINAL B.T.				
1. Rotted Fir Stump	N 64°W	44.88'		

N 1/4 SEC. 24				
1. 18" Douglas Fir	N 30°W	5.4'	TO CENTER	1/4 S 13 BT
2. 26" Douglas Fir	S 71°E	26.4'	TO CENTER	1/4 S 24 BT

S 1/4 SEC. 24				
1. 8" Douglas Fir	N 80°E	9.0'	TO CENTER	1/4 S 24 BT
2. 6" Douglas Fir	S 31°W	3.4'	TO CENTER	1/4 S 25 BT

CE 1/16 SEC. 24				
1. 14" Douglas Fir	N 40°W	29.4'	TO CENTER	CE 1/16 S 24 BT
2. 12" Douglas Fir	S 53°W	23.0'	TO CENTER	CE 1/16 S 24 BT

E 1/16 S 13 & S 24				
1. 16" Douglas Fir	N 04°W	44.2'	TO CENTER	E 1/16 S 13 BT
2. 16" Douglas Fir	S 43°W	17.6'	TO CENTER	E 1/16 S 24 BT

COUNTY SURVEYORS FILE DATA
DO NOT REMOVE FROM OFFICE

MAP FILE M65 - 47