MAP FILE M45-53

COUNTY SURVEYORS FILE DATA
DO NOT REMOVE FROM OFFICE

FILED
RECEIVED
JAN 4 1978
COUNTY SURVEYOR
DOUGLAS COUNTY, ORE.

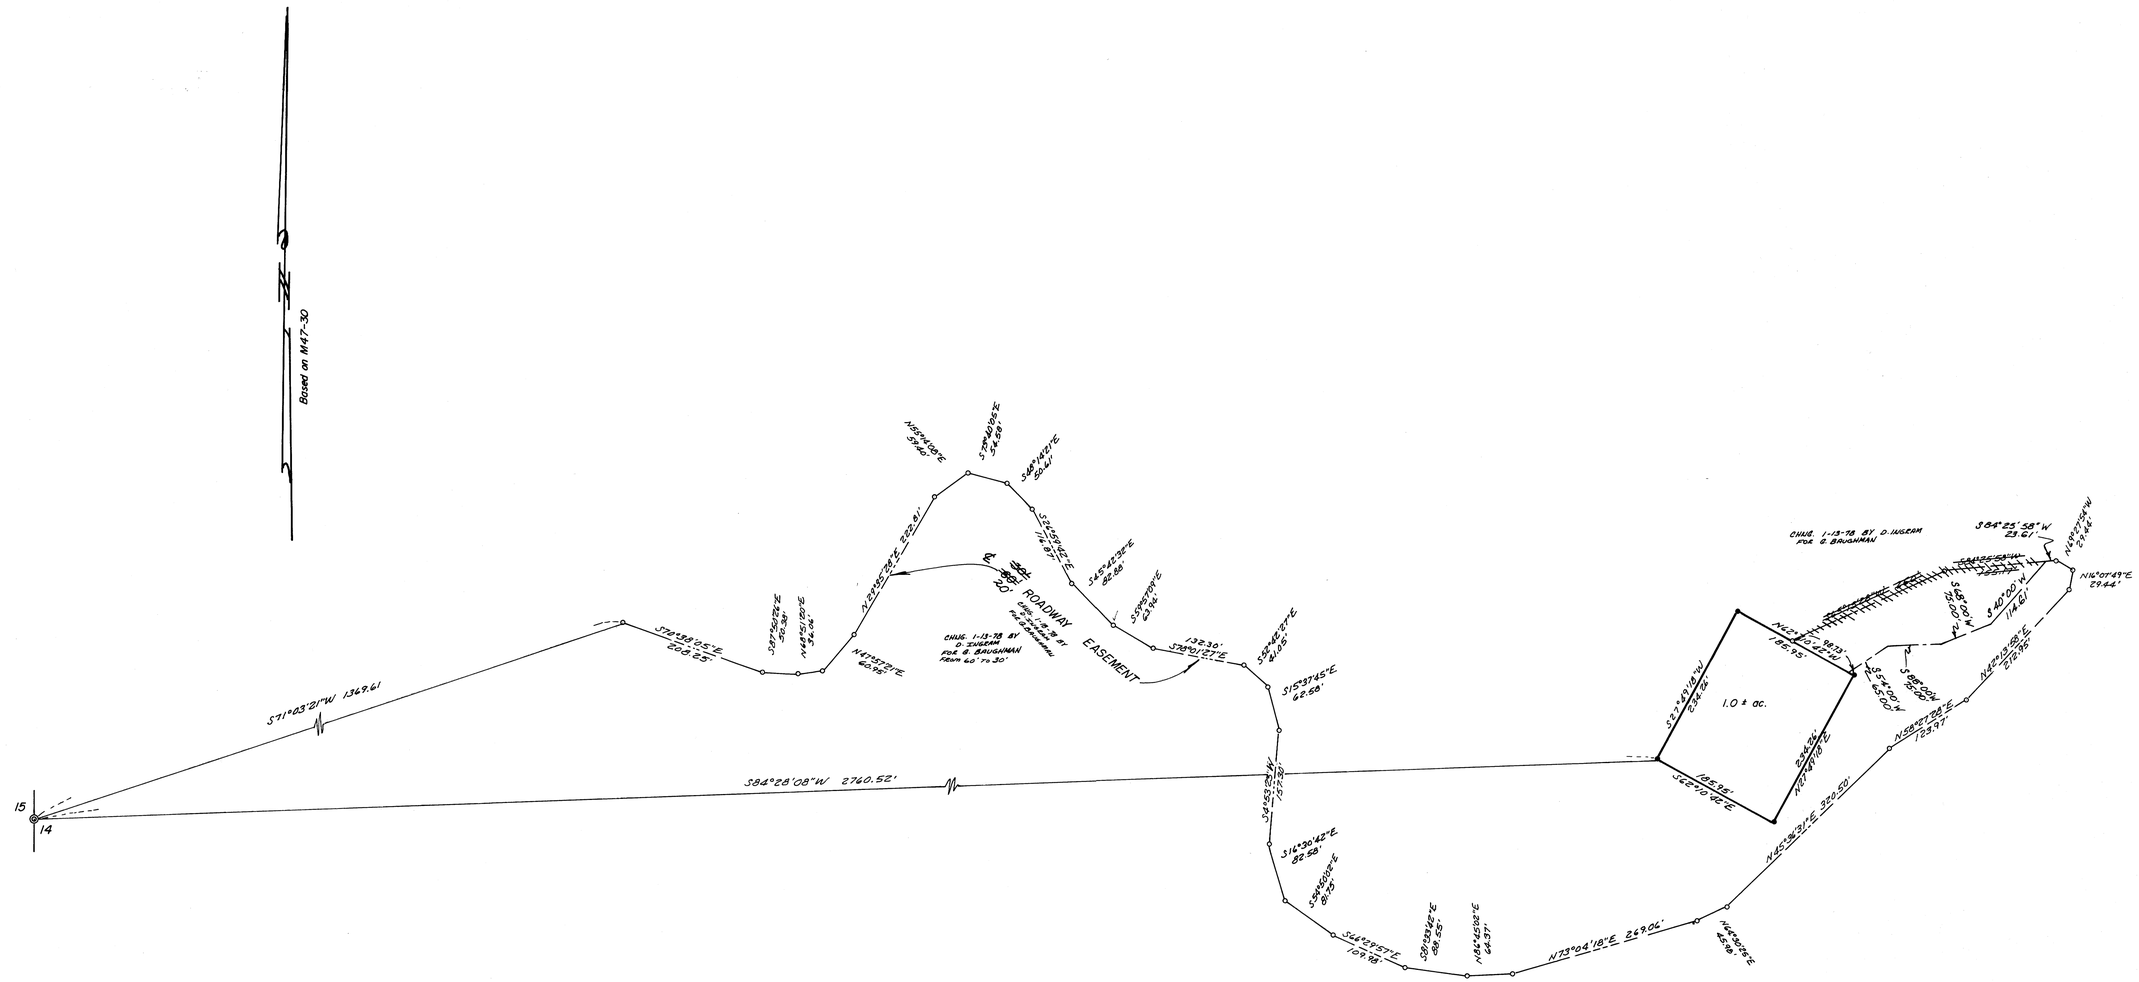

LEGEND

- ○ —— Not set
- ● —— Set 1/2" iron rod
- ◎ —— Found Brass cap

Basis of Bearings M47-30
B.C. N89°55'06"W 300.00' B.C.
M47-14

REGISTERED PROFESSIONAL LAND SURVEYOR
OREGON
JULY 14, 1966
GLEN E. BAUGHMAN
2515

COUNTY SURVEYORS FILE DATA
DO NOT REMOVE FROM OFFICE

SURVEY FOR MORTGAGE PURPOSES IN SECTION 14 T27S R5WWM			
FOR: BOB CARRICO	SCALE 1"=100'	DRAWN BY Eab	REVISED
C & G ENGINEERING INC, ROSEBURG, OREGON			
DATE 12/23/77	APPROVED BY	DRAWING NUMBER 6150.0024	

K+E CRYSTALENE © 10 9458
ARCHITECTS' STANDARD FORM
MADE IN U.S.A.

MAP FILE M45-53