

COUNTY SURVEYORS FILE DATA  
DO NOT REMOVE FROM OFFICE

Donald B. & Elizabeth A.  
Harmon (hus. & wife)  
Inst. No. 86398

FILED  
RECEIVED  
MAR 13 1978  
COUNTY SURVEYOR  
DOUGLAS COUNTY, ORE.

James W. & Margaret L.  
Damitio (hus. & wife)  
Inst. No. 67-7545

1/2" iron rod 0.73 east of line

Mark K. & Lucille R.  
Smith (hus. & wife)  
Inst. No. 71-3283

3/4" iron pipe 0.62 east of line

50°21'W, 947.92 (record, 947.80)

S0°21'W, 927.63 (basis of bearings)

641.74

Harry D. & Shari K.  
Hayes (hus. & wife)  
Inst. No. 72-11498

School District No. 4  
11.09 Acres ±

N0°21'E  
930.65

Basis of bearings:  
West line of property

50 0 50 100

Scale: 1" = 50'

REGISTERED  
PROFESSIONAL  
LAND SURVEYOR

B A Shaner

OREGON  
OCT. 4, 1957  
BRUCE A SHANER  
430

Point of beginning

6.69

S89°44'E, 520.00  
468.81

S89°44'E  
44.50 218.51

Garden Valley Road, County Road No. 6


S0°21'W, 20.29  
Steel fence post, buried

S75°11'E, 2383.18  
(Tie by record)

LEGEND

- Corner found (3/4" iron rod R/W pin, unless noted) •
- Corner set (5/8" iron rod with aluminum cap) ○

Note: Refer to County Surveyor Map File 42/281

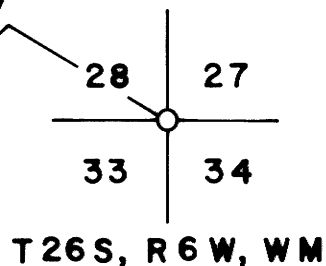

PROPERTY BOUNDARY SURVEY  
IN SE 1/4 SEC. 28, T. 26 S., R. 6 W., W. M.  
DOUGLAS COUNTY, OREGON

For: Douglas County School District No. 4

By: Shaner Engineering, Inc.

March 10, 1978

COUNTY SURVEYORS FILE DATA  
DO NOT REMOVE FROM OFFICE