66-99W

COUNTY SURVEYORS FILE DATA
DO NOT REMOVE FROM OFFICE

SURVEY IN SEC. 6, T29S, R5W. W.M.

SURVEYED FOR - EUGENE MARSHALL
SURVEYED BY - W. S. BARNES

SEPT. 1977
SCALE 1" = 200'

FILED
RECEIVED
SEP 23 1977
COUNTY SURVEYOR
DOUGLAS COUNTY, ORE.

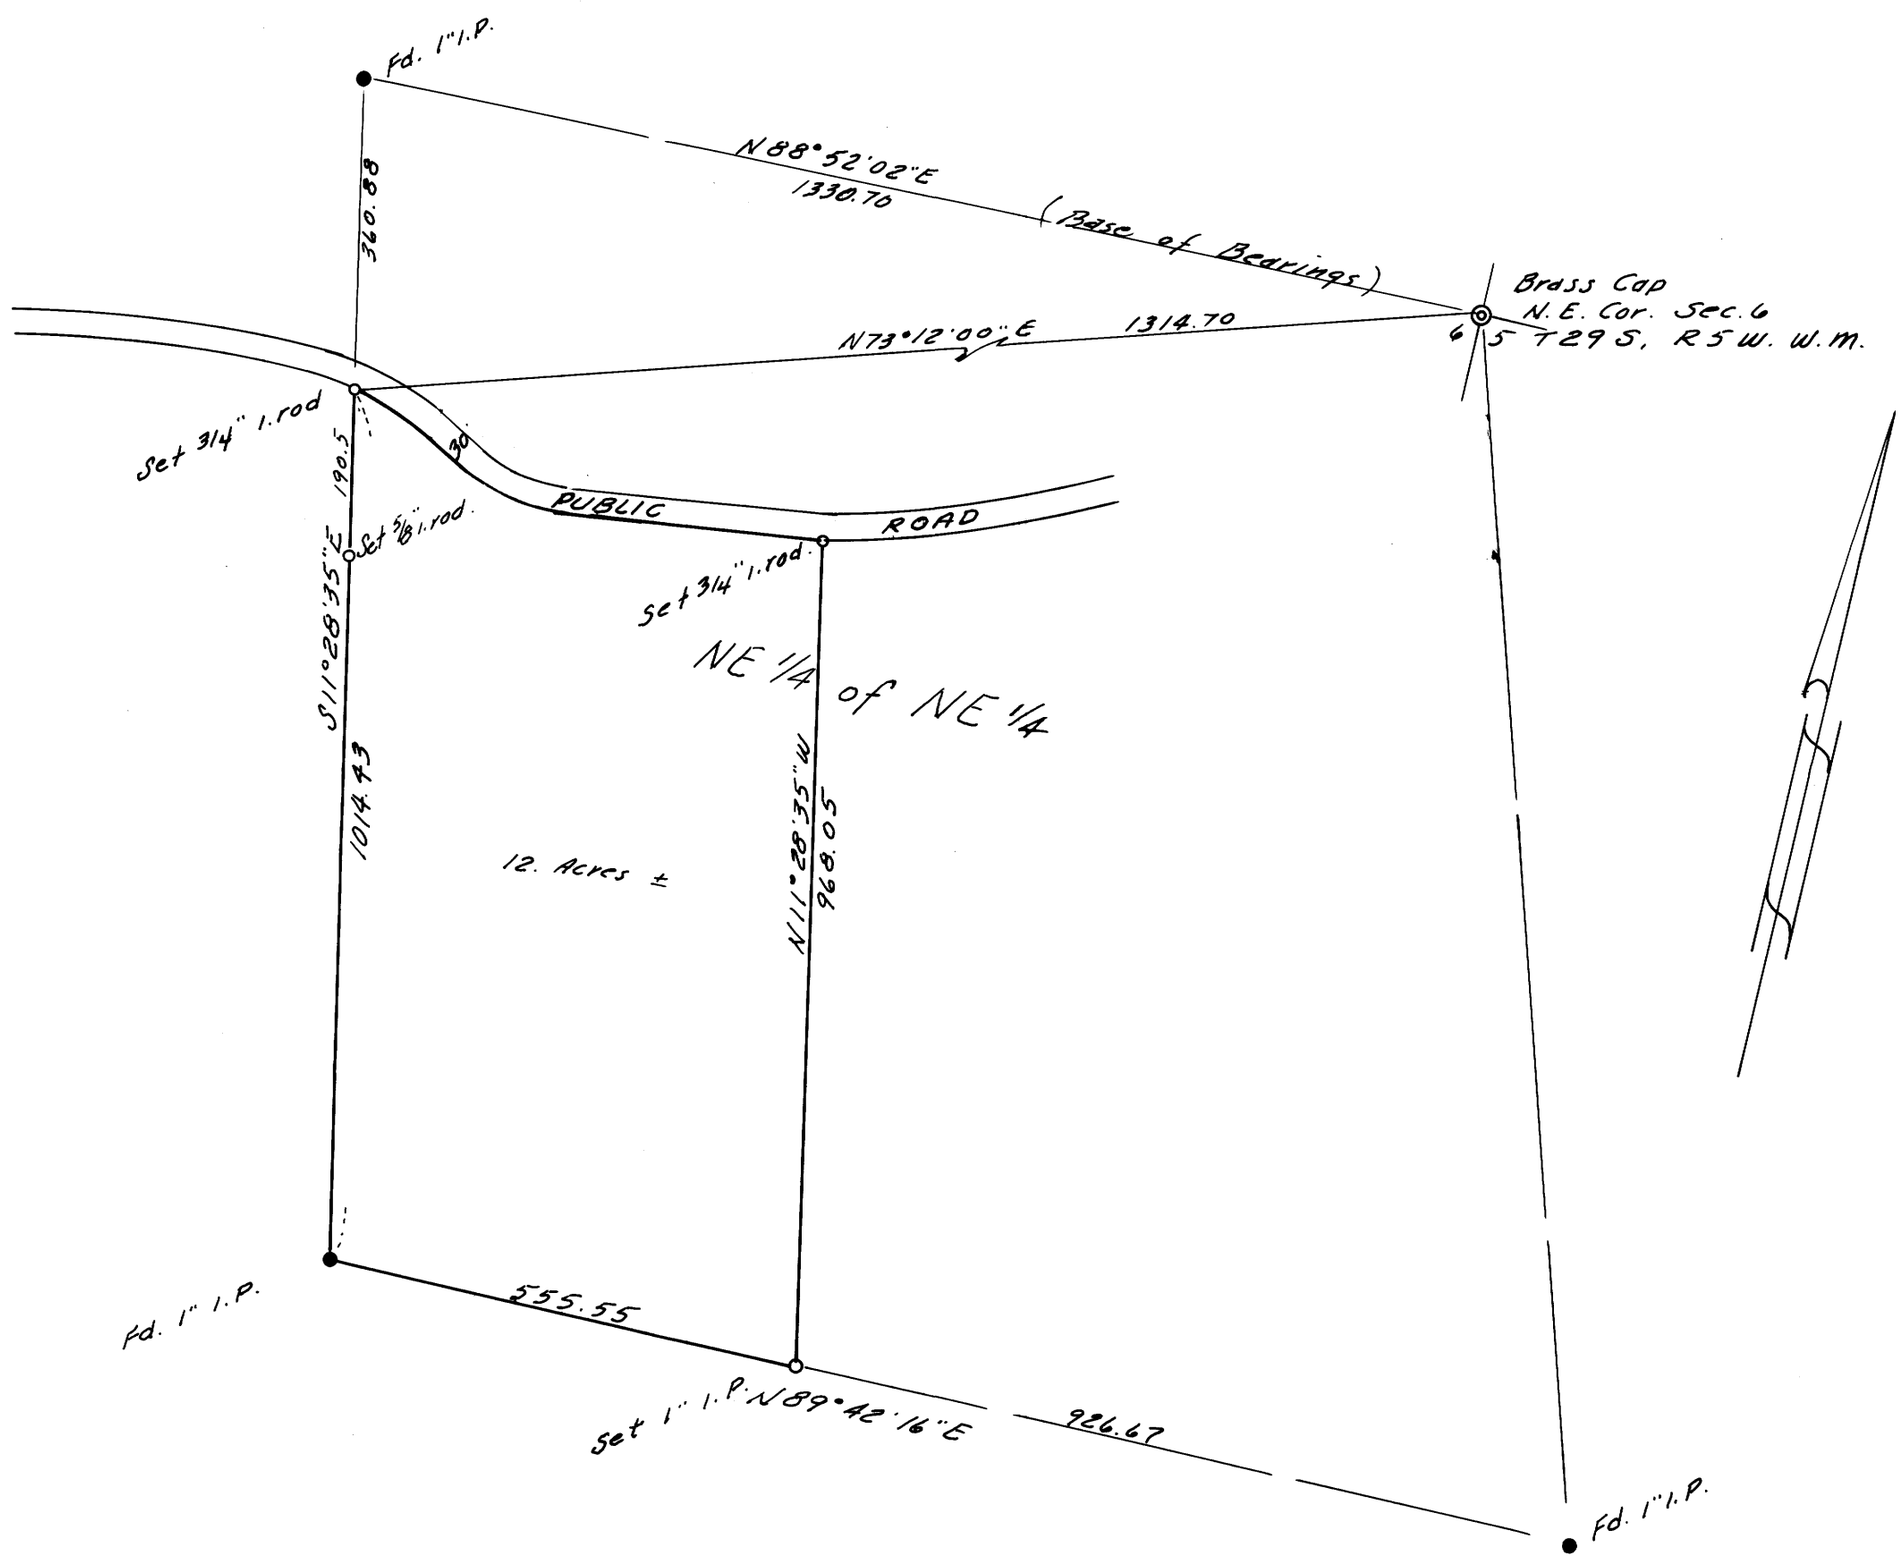

Reference - M33-63 C.S. Files

REGISTERED PROFESSIONAL ENGINEER
W. S. Barnes
William S. Barnes

MAP FILE M66-79