8 -99W

SURVEY FOR DEED DESCRIPTION
IN SEC. 10, T26S, R3W. W.M.

SURVEYED FOR- GARY KENNADAY
SURVEYED BY- W.S. BARNES

JULY 1977
SCALE 1" = 100'

COUNTY SURVEYORS FILE DATA
DO NOT REMOVE FROM OFFICE

FILED
RECEIVED MLL
JUL 22 1977
COUNTY SURVEYOR
DOUGLAS COUNTY, ORE.

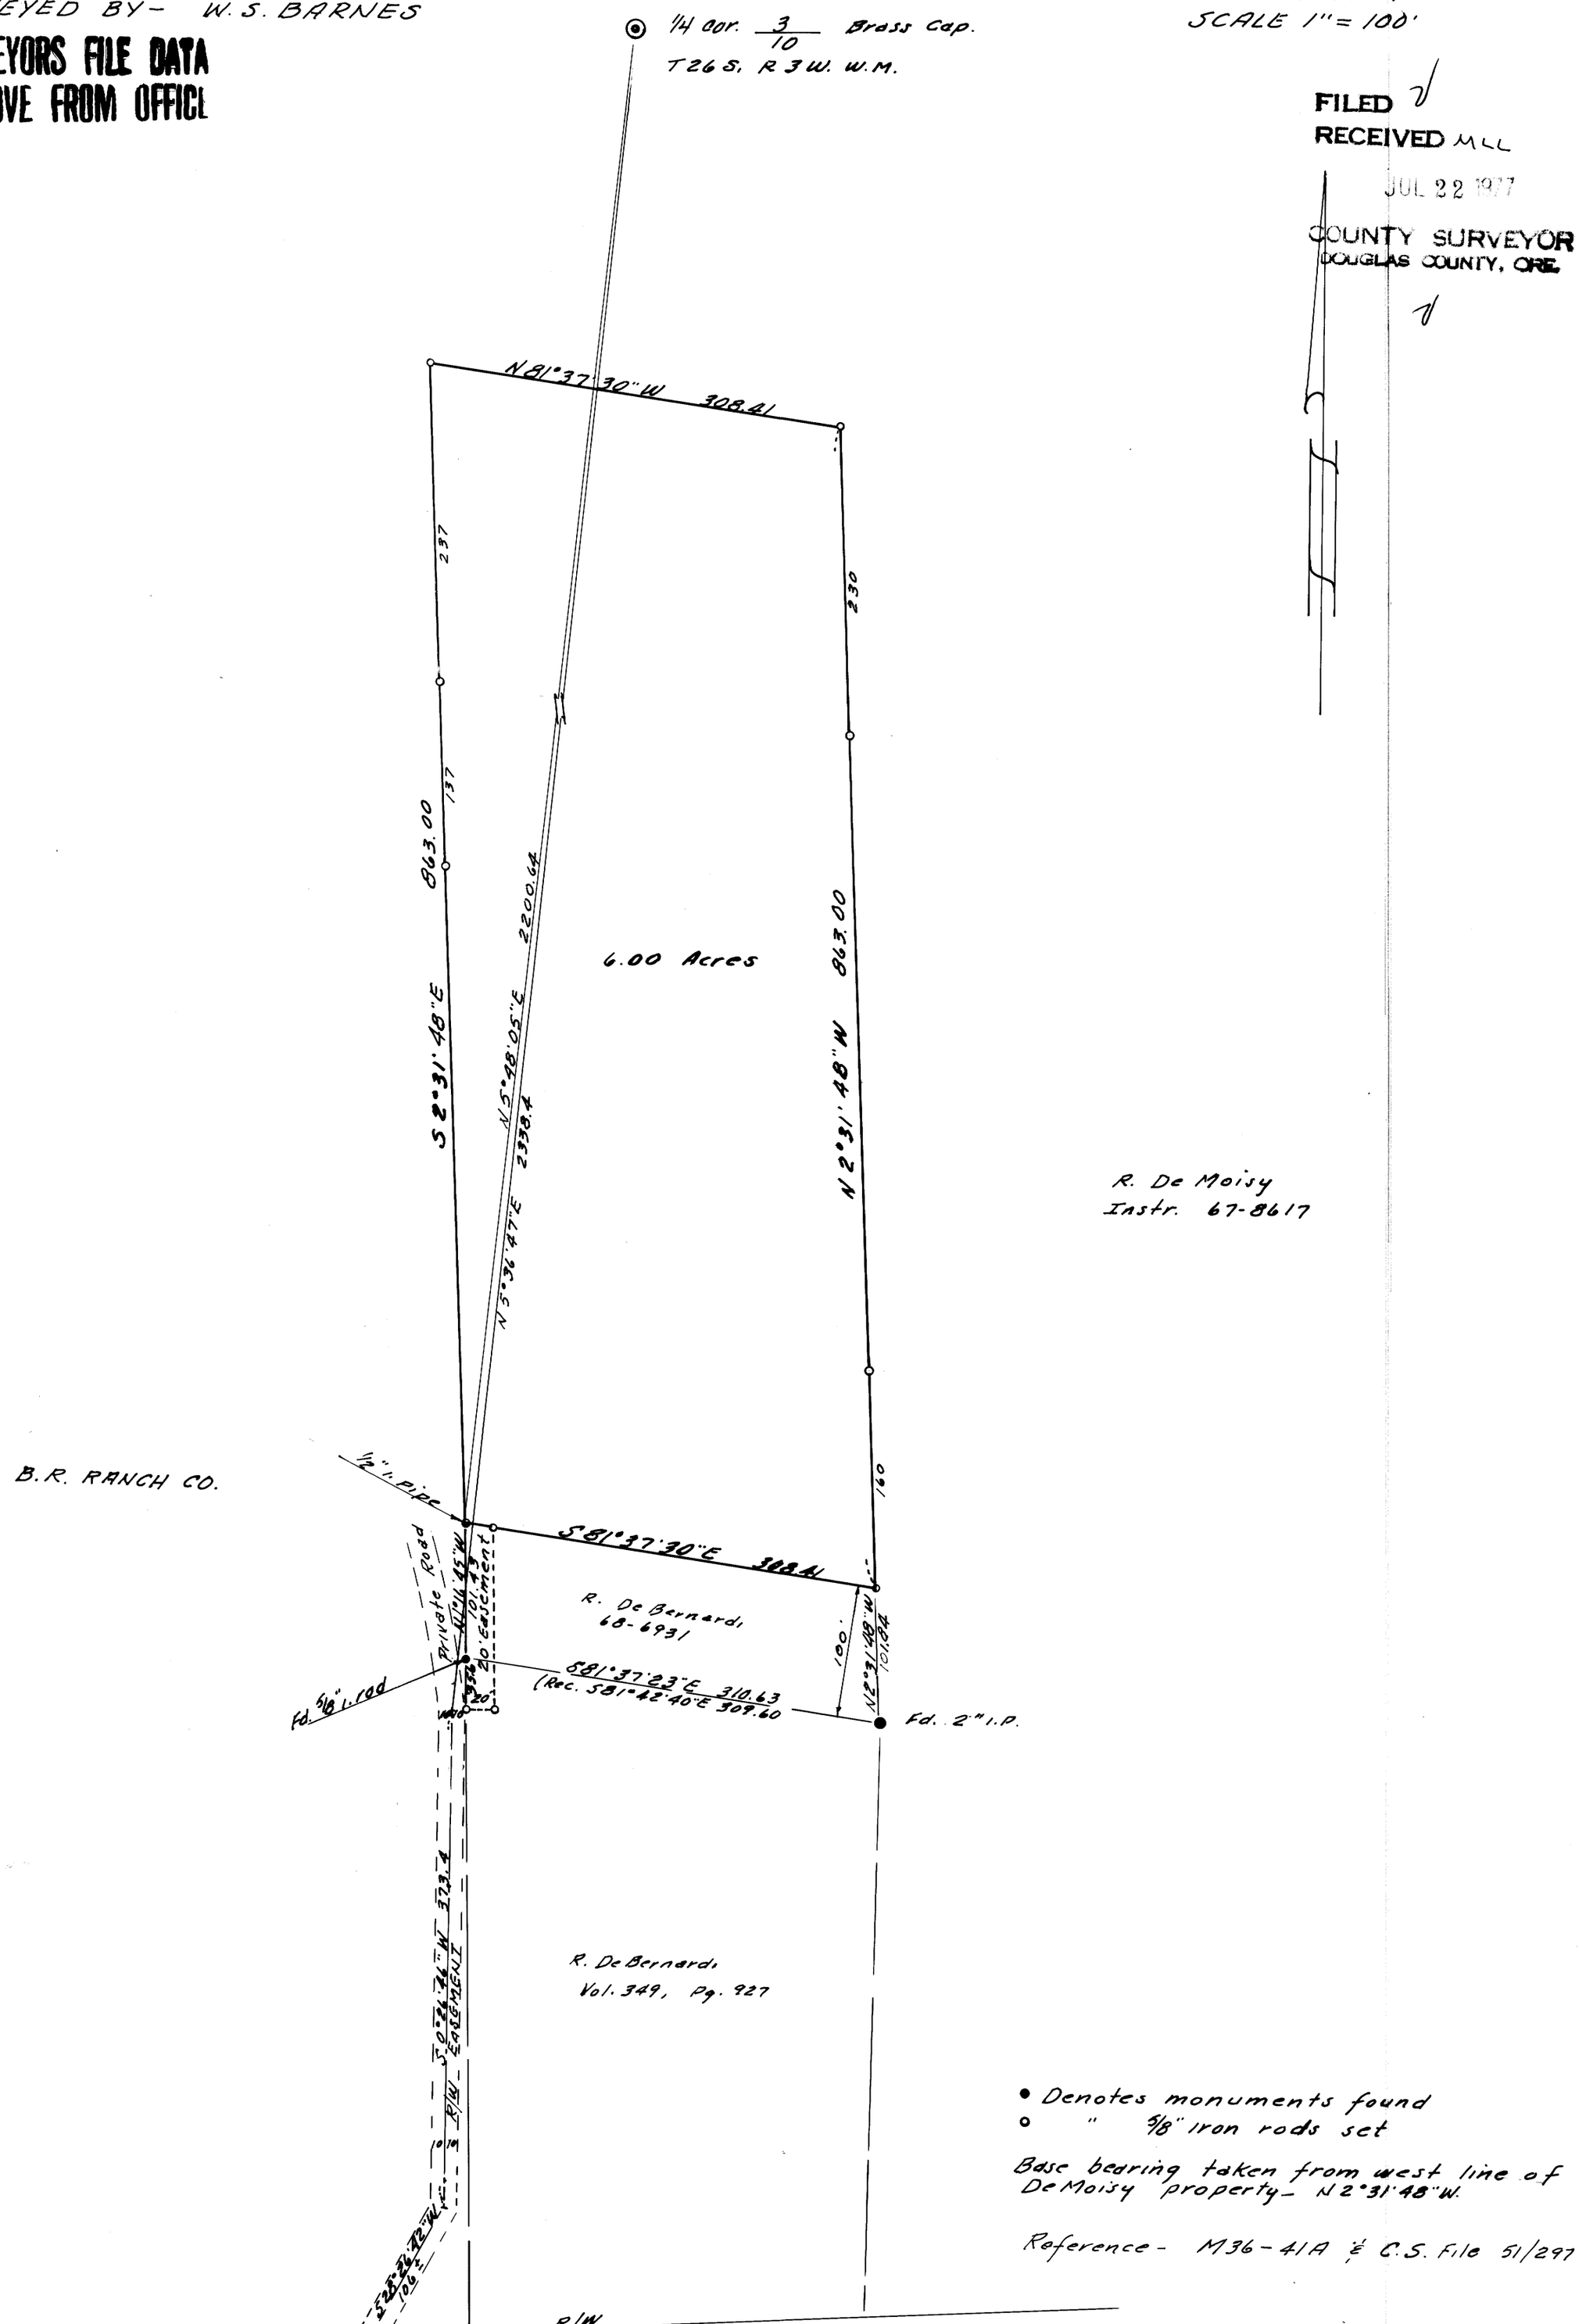

• Denotes monuments found
○ " 5/8" iron rods set

Base bearing taken from west line of DeMoisy property- N2°31'48"W.

Reference- M36-41A & C.S. File 51/297

REGISTERED PROFESSIONAL ENGINEER 2128 OREGON SEPT 8, 1941 William S. Barnes

W. S. Barnes

MAP FILE M66 8